

# **Appendix A5**

## Retaining Wall Inspection Reports

**NY33 RETAINING WALL CONDITION EVALUATION 2023**  
**KENSINGTON EXPRESSWAY PROJECT**  
**PIN 5512.52**  
**CITY OF BUFFALO, ERIE COUNTY**  
**RETAINING WALL 1**




Prepared By:



Merton J. Edwards, PE (NYSPE 064981)  
Inspection Team Leader | Sr. Structural Engineer  
Date: 5/30/2023

Reviewed By:

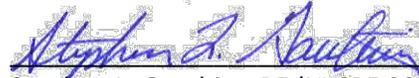

Stephen L. Gauthier, PE (NYSPE 0075775)  
Quality Control Engineer | Sr. Structural Engineer  
Date: 6/16/2023



300 State Street  
Rochester, New York 14614  
ph: 585-454-6110  
[www.labellapc.com](http://www.labellapc.com)

# PIN 5512.52 – NY33 RETAINING WALL CONDITION EVALUATION 2023 FIELD INSPECTION SUMMARY

STRUCTURE: Retaining Wall #1 (RT) along 33EB between off Ramp to NB Humboldt Parkway and Pedestrian Bridge

STRUCTURE TYPE: Reinforced Concrete Cantilever Wall on Spread Footings  
Year Built: 1970

CURRENT INSPECTION: 05/01/23 – 5/09/23 (LaBella Inspections)

LAST KNOWN INSPECTION: Unknown

CONDITION STATE: FAIR

## RETAINING WALL INSPECTION & DOCUMENTATION:

Inspection of the retaining walls will be in conformance with the NYSDOT Retaining Wall Inventory and Inspection Program Manual, October 2018. Inspection of the following elements will be inspected and documented as appropriate:

### - Inspection:

The following inspection procedure was followed:

- Walls were checked for signs of settlement, rotation, or bulging. Walls faces were checked for vertical alignment using a smart level. The walls being evaluated are vertical with no batter.
- Construction joints between sections of the wall were examined for misalignment, and near the ground line for fill material washing out from between panels or joint.
- Walls were inspected for erosion material in front of the wall, for heaving of material in front of the wall, and for settlement of fill behind the wall
- Examined the wall for deterioration of the material, such as cracking, spalling, and/or corrosion, noting the width, length, depth, and/or orientation of the deterioration. Photographs are provide documenting defects found.
- Wall façades were reviewed for evidence of water seepage, efflorescence, or rust staining.
- Examined the base of walls for evidence of water flow where the water table may be within the retained earth.
- Examined and probed drains for signs of clogging. Examined drainage around ends of wall and note if embankments have been experiencing erosion.
- Examined site grading for any locations that may prohibit proper drainage from behind the wall looking for evidence of ponding above the wall, such as debris accumulation in the lower spots.
- Ascertain why water is not draining properly and note in the inspection.
- Inspected roadway components above wall for signs or joint separation, potholes, and areas of settlement.
- Examined vegetation growth along and above the wall for root infiltration creating undesirable stresses on the wall. Documented any induce cracking, bulging or failure.
- Examined the wall system for vehicular damage, and document the location and degree of damage.

GENERAL OBSERVATIONS:

1. Retaining Wall Panels are generally 30 feet in length. The wall cap is 9" with horizontal chamfered panels spaced 3'-0" vertically, from the top of the wall. The wall cap is 9" with horizontal chamfered panels spaced 3'-0" vertically, from the top of the wall. There is some variation in panel length due to the location of bridges within the corridor. For specific panel lengths see the DOCUMENTION Section of this report.
2. The lower 6-10 ft of the subject retaining wall was found to be in FAIR-POOR condition with extensive map cracking, dampness, isolated rust staining, concrete spalls and widespread delamination. For specific conditions found, photographs of the of wall panels, and condition calculations see the attached sections of this report.
3. The upper portions of theses wall panels were generally found to be in GOOD-FAIR condition except for a few locations. The top of wall rail coping is map cracked under approximately 50% of the railing posts and has horizontal cracking along the coping at mid height for approximately 40% of the wall length. For specific conditions found, photographs of the of wall panels, and condition calculations see the attached sections of this report.

| GENERAL:                    |   |
|-----------------------------|---|
| DEFECT                      | DESCRIPTION   |
| Misalignment                | None noted. No tipping or rotation of the wall panels was observed.   |
| Settlement                  | None noted. No heaving was detected at the wall toe, nor was the Humboldt Parkway above the wall showing signs of settlement. |
| Sinkhole (cavity) Formation | None noted.   |

| Concrete Cracks:                                     |  |
|--|--|
| DEFECT   | DESCRIPTION  |
| Insignificant Cracks<br>(cracks < 0.012 inches wide) | Most wall panels exhibit minor cracking. Cracking is predominately vertical and seems to mirror the rebar spacing underneath.  |
| Map cracks   | Most wall panels are exhibiting some map cracking. The map cracking is most prevalent in the bottom 6 feet of the panels and at the top of walls under railing posts.    |
| Moderate Cracks<br>(0.012 - 0.05 inches wide)        | Many wall panels exhibit moderate cracking. These cracks, where they exist, are predominately vertical, full height cracks located at or near the midpoint of the panel. |
| Wide Cracks<br>(cracks > 0.05 inches wide)           | A few panels exhibit wide cracking. These cracks, where they exist, are predominately vertical, full height cracks located at or near the midpoint of the panel.         |

PIN 5512.52 Kensington Expressway  
 Retaining Wall #1 (RT) along 33EB between Off Ramp to NB Humboldt Parkway and Pedestrian Bridge

| Additional Concrete Distress: |   |
|-------------------------------|---|
| DEFECT                        | DESCRIPTION   |
| Spalling / Delamination       | Every wall panel is exhibiting delamination. Delamination amounts vary from approximately 15% to 60% of the exposed wall face. Many wall panels exhibit spalling. Spalling is predominately found at the wall joints to adjacent wall panels and in vertical rebar areas in the lower 6 to 10 feet of wall. |
| Staining                      | Staining, both efflorescence and rust staining, is evident on every wall panel. The amount of staining varies and is best noted in the photo documentation.   |
| Exposed Rebar                 | Rebar is exposed in many of the spalled areas noted during the inspection. Most of the exposed rebar is vertically placed reinforcement. Exposed rebar was noted to have between 15% and 60% section loss.  |

**Notes:**

RW 1 consists of 99 panels numbered west (south) to east (north). The retaining wall supports the Humboldt Parkway above State Route 33 (Kensington Expressway).

Located along the right shoulder of E.B. Kensington from the off-ramp to N.B. Humboldt Parkway and extending beyond Sidney Street supporting N.B. Humboldt Parkway (Approximately 2,935 ft. long, 21 ft. maximum exposed height). The east abutments for the E. Utica and E. Ferry Street Overpass Bridges are not considered as part of RW #1.

**INVENTORY, INSPECTION, AND DATA COLLECTION**

| Element                       | Total Qty | Units | Condition State |             |             |               |
|-------------------------------|-----------|-------|-----------------|-------------|-------------|---------------|
|                               |           |       | 1               | 2           | 3           | 4             |
|                               |           |       | <b>GOOD</b>     | <b>FAIR</b> | <b>POOR</b> | <b>SEVERE</b> |
| RW.01 - Entire Wall           | 1         | Each  | 0.79            | 0.07        | 0.14        |               |
| RW.02 - Wall Facing           | 56770     | SF    | 43678           | 4233        | 8859        |               |
| RW.03 - Ground Surface, Front | 2935      | Ft    | 2935            |             |             |               |
| RW.04 - Ground Surface, Back  | 2935      | Ft    | 2932            |             | 3           |               |
| RW.05 - Weep Holes            | 1         | Each  |                 |             | 1           |               |
| 800 – Scour                   | N/A       | Ft    | ---             | ---         | ---         | ---           |

PIN 5512.52 Kensington Expressway  
Retaining Wall #1 (RT) along 33EB between Off Ramp to NB Humboldt Parkway and Pedestrian Bridge

#### INSPECTION RESULTS/ RECOMMENDATIONS

- **Overall Condition State Recommendation: 2 - FAIR**
- PROJECT DOCUMENTATION CAN BE FOUND IN THE ATTACHED SECTIONS

PIN 5512.52 Kensington Expressway  
Retaining Wall #1 (RT) along 33EB between Off Ramp to NB Humboldt Parkway and Pedestrian Bridge

## Inspection Photos

# PIN 5512.52 – NY33 RETAINING WALL CONDITION EVALUATION 2023 FIELD INSPECTION SUMMARY

Retaining Wall #1 (RT) along 33EB between off Ramp to NB Humboldt Parkway and Pedestrian Bridge.



PHOTO 1  
PANEL 103  
Description:  
The railing coping concrete and the underlying wall face are spalled 1" deep with exposed rebar. Rebar exhibits approximately 15% section loss. The remaining coping concrete is delaminated. The wall face has minor map-cracking with efflorescence and rust staining.  
The bottom steel bridge rail tube is broken and detached from the railing post.



PHOTO 2  
PANEL 105  
Description:  
The wall railing system coping is cracked at mid-height. The crack is 80% of the wall panel length. The wall face has minor map-cracking with staining.  
There are two (2) full height vertical cracks in the wall face under two of the railing posts. There is map-cracking and delamination of the concrete approximately 12 inches wide adjacent to the crack over 50% of length.  
The bottom steel bridge rail tube is missing from the railing posts.

# PIN 5512.52 – NY33 RETAINING WALL CONDITION EVALUATION 2023 FIELD INSPECTION SUMMARY

Retaining Wall #1 (RT) along 33EB between off Ramp to NB Humboldt Parkway and Pedestrian Bridge.



PHOTO 3  
PANEL 106

Description:

The wall railing system coping is cracked at mid-height. The crack is approximately 80% of the wall panel length.

The wall face has minor map-cracking with staining. There are two (2) spall areas with exposed rebar (rebar section loss is 30%) at the first chamfer line at 12 ft. and 19 ft. from the panel begins. There is map-cracking and delamination of the concrete approximately 3 ft by 3 ft adjacent to the end panel joint.



PHOTO 4  
PANEL 112

Description:

The wall railing system coping is cracked under the railing posts. The wall face is map-cracked with staining.

There are multiple vertical cracks in the wall face mirroring the underlying vertical reinforcing.

Concrete spalls and delamination are found between 5 ft and 9 ft from the roadway surface.

# PIN 5512.52 – NY33 RETAINING WALL CONDITION EVALUATION 2023 FIELD INSPECTION SUMMARY

Retaining Wall #1 (RT) along 33EB between off Ramp to NB Humboldt Parkway and Pedestrian Bridge.



PHOTO 5  
PANEL 120  
Description:  
The lower 4 ft of the wall surface is spalled and delaminated over 50% of the area.  
The multiple spalls have exposed rebar.  
There is a half height vertical crack in the wall face at 13 ft from the panel begin.



PHOTO 6  
PANEL 126  
Description:  
There is a full height vertical crack in the wall face near mid span. The lowest panel has cracking mirroring the underlying vertical reinforcement. The lower two panels are cracked, spalled and delaminated over 60% of the area. the remainder of the wall is in good condition.

# PIN 5512.52 – NY33 RETAINING WALL CONDITION EVALUATION 2023 FIELD INSPECTION SUMMARY

Retaining Wall #1 (RT) along 33EB between off Ramp to NB Humboldt Parkway and Pedestrian Bridge.



PHOTO 7

PANEL 131

**Description:**

The bottom three wall panels are delaminated over most of their area. The begin wall joint is delaminated approximately two-thirds the wall height by one foot wide. The lowest panel has a large spall with exposed rebar (rebar has 60% section loss).



PHOTO 8

PANEL 132

**Description:**

The bottom wall panel is spalled over 30% of its area with exposed rebar, and is 100% delaminated. The second panel is map-cracked and delaminated over 20% of its area.

# PIN 5512.52 – NY33 RETAINING WALL CONDITION EVALUATION 2023 FIELD INSPECTION SUMMARY

Retaining Wall #1 (RT) along 33EB between off Ramp to NB Humboldt Parkway and Pedestrian Bridge.



PHOTO 9  
PANEL 134

Description:

The lower three sections of the wall are heavily map-cracked with rust staining and some efflorescence. There is a full height crack at 18 ft from the panel begin. The concrete adjacent to the wall end joint is spalled with exposed rebar (rebar is exhibiting 50% section loss)



PHOTO 10  
PANEL 144

Description:

The lower three sections of the wall are heavily map-cracked with rust staining. The wall face has vertical cracking at 2-foot intervals. This mirrors the underlying rebar placement.

The wall railing system coping is map cracked with efflorescence under the railing posts.

# PIN 5512.52 – NY33 RETAINING WALL CONDITION EVALUATION 2023 FIELD INSPECTION SUMMARY

Retaining Wall #1 (RT) along 33EB between off Ramp to NB Humboldt Parkway and Pedestrian Bridge.



PHOTO 11

PANEL 158

**Description:**

The lower three sections of the wall are heavily map-cracked with rust staining and some efflorescence.

There is a full height crack at 17 ft from the panel begin. The concrete adjacent to each wall joint is heavily delaminated and spalled. with exposed rebar (rebar is exhibiting 25% section loss).

The lowest wall section is 90% delaminated (where not spalled), section 2 is 30% delaminated and section 3 exhibits 50% delamination.



PHOTO 12

PANEL 167

**Description:**

The concrete wall face is map cracked, stained and spalled with exposed rebar. The rebar shows approximately 15% section loss. The spalled areas are in the lower section and are located at both ends of the panel at 10 ft, 18 ft, 22 ft and 26 ft from the panel begin.

The various wall sections are delaminated. The lower section exhibits 70% delamination, section 2 is delaminated over 60% of its area and section 3 is 40% delaminated.

# PIN 5512.52 – NY33 RETAINING WALL CONDITION EVALUATION 2023 FIELD INSPECTION SUMMARY

Retaining Wall #1 (RT) along 33EB between off Ramp to NB Humboldt Parkway and Pedestrian Bridge.



PHOTO 13  
PANEL 171  
Description:  
The bottom wall section is heavily delaminated, spalled and map cracked. The map cracking is at 2-foot intervals mirroring the underlying rebar placement. Section 2 is delaminated and map cracked over 60% of its area. Section 3 is delaminated approximately 3 ft at both ends of the wall adjacent to the joint with other panels. Section 4 is delaminated for 3 ft from at the end wall joint.



PHOTO 14  
PANEL 174  
Description:  
The bottom wall section is heavily delaminated, spalled and map cracked over 90% of its area. The map cracking is at 2-foot intervals mirroring the underlying rebar placement.  
Section 2 is delaminated and map cracked over 75% of its area.  
Section 3 exhibits vertical cracking and map cracking in its lower half.

# PIN 5512.52 – NY33 RETAINING WALL CONDITION EVALUATION 2023 FIELD INSPECTION SUMMARY

Retaining Wall #1 (RT) along 33EB between off Ramp to NB Humboldt Parkway and Pedestrian Bridge.



PHOTO 15  
PANEL 176

Description:

The bottom wall section is heavily delaminated, spalled and map cracked over 80% of its area. The map cracking is at 2-foot intervals mirroring the underlying rebar placement.

Section 2 is delaminated and map cracked over 50% of its area. Section 3 is map cracked with several vertical cracks in the concrete surface.



PHOTO 16  
PANEL 177

Description:

The bottom wall section is heavily delaminated (60% of the wall section) and map cracked throughout. The map cracking is at 2-foot intervals mirroring the underlying rebar placement. Section 2 and 3 are delaminated and map cracked over 60% of their areas.

The wall railing system coping is map cracked and delaminated over 30% of its surface. The map cracked areas are stained with rust and some efflorescence.

# PIN 5512.52 – NY33 RETAINING WALL CONDITION EVALUATION 2023 FIELD INSPECTION SUMMARY

Retaining Wall #1 (RT) along 33EB between off Ramp to NB Humboldt Parkway and Pedestrian Bridge.



PHOTO 17  
PANEL 178  
Description:  
The bottom wall panel is heavily delaminated and map cracked throughout. The map cracking is at 2-foot intervals mirroring the underlying rebar placement. Section 2 and 3 are delaminated and map cracked over 50% of their areas.  
The wall railing system coping is map cracked and delaminated over 30% of its surface. The map cracked areas are stained with rust and some efflorescence.



PHOTO 18  
PANEL 190  
Description:  
The bottom wall section is heavily delaminated, spalled and map cracked. The map cracking is at 2-foot intervals mirroring the underlying rebar placement.  
Section 2 is map cracked over 35% of its area.  
Section 3 exhibits map cracking throughout.  
The wall railing system coping is cracked at mid-height. The crack is full length with staining.

# PIN 5512.52 – NY33 RETAINING WALL CONDITION EVALUATION 2023 FIELD INSPECTION SUMMARY

Retaining Wall #1 (RT) along 33EB between off Ramp to NB Humboldt Parkway and Pedestrian Bridge.



PHOTO 19  
PANEL 196

Description:

The wall panel is heavily delaminated and map cracked throughout. The vertical map cracking is at 2-foot intervals mirroring the underlying rebar placement.

The wall railing system coping is map cracked and delaminated full length.



PHOTO 20  
PANEL 199

Description:

The wall panel is heavily delaminated and map cracked throughout.

The wall railing system coping is cracked and delaminated full length.

# PIN 5512.52 – NY33 RETAINING WALL CONDITION EVALUATION 2023 FIELD INSPECTION SUMMARY

Retaining Wall #1 (RT) along 33EB between off Ramp to NB Humboldt Parkway and Pedestrian Bridge.



PHOTO 21  
PANEL 130 (Back side of coping)

Description:  
Safety walk is broken, cracked, and heaved around the manhole.  
Map cracking is present on the rail coping, typical for entire wall.



PHOTO 22  
Back of coping (somewhere between Panel 185 and 193)

Description:  
Singular spall area under rail post on back side of coping. The longitudinal rebar is exposed.

PIN 5512.52 Kensington Expressway  
Retaining Wall #1 (RT) along 33EB between Off Ramp to NB Humboldt Parkway and Pedestrian Bridge

## Field Sheets

FILE NAME = \\06cashlab\06\02150716.01\_kensington Preliminary Design\Drawings\Highway\Plan\set2\0551252\_cph\_pin\_11A.dgn  
 DATE = 2/7/2023  
 TIME = 12:56:26 PM

PROJECT MANAGER

CHECK



DRAFTING

CHECK

DESIGN

JOB MANAGER



DESIGN SUPERVISOR

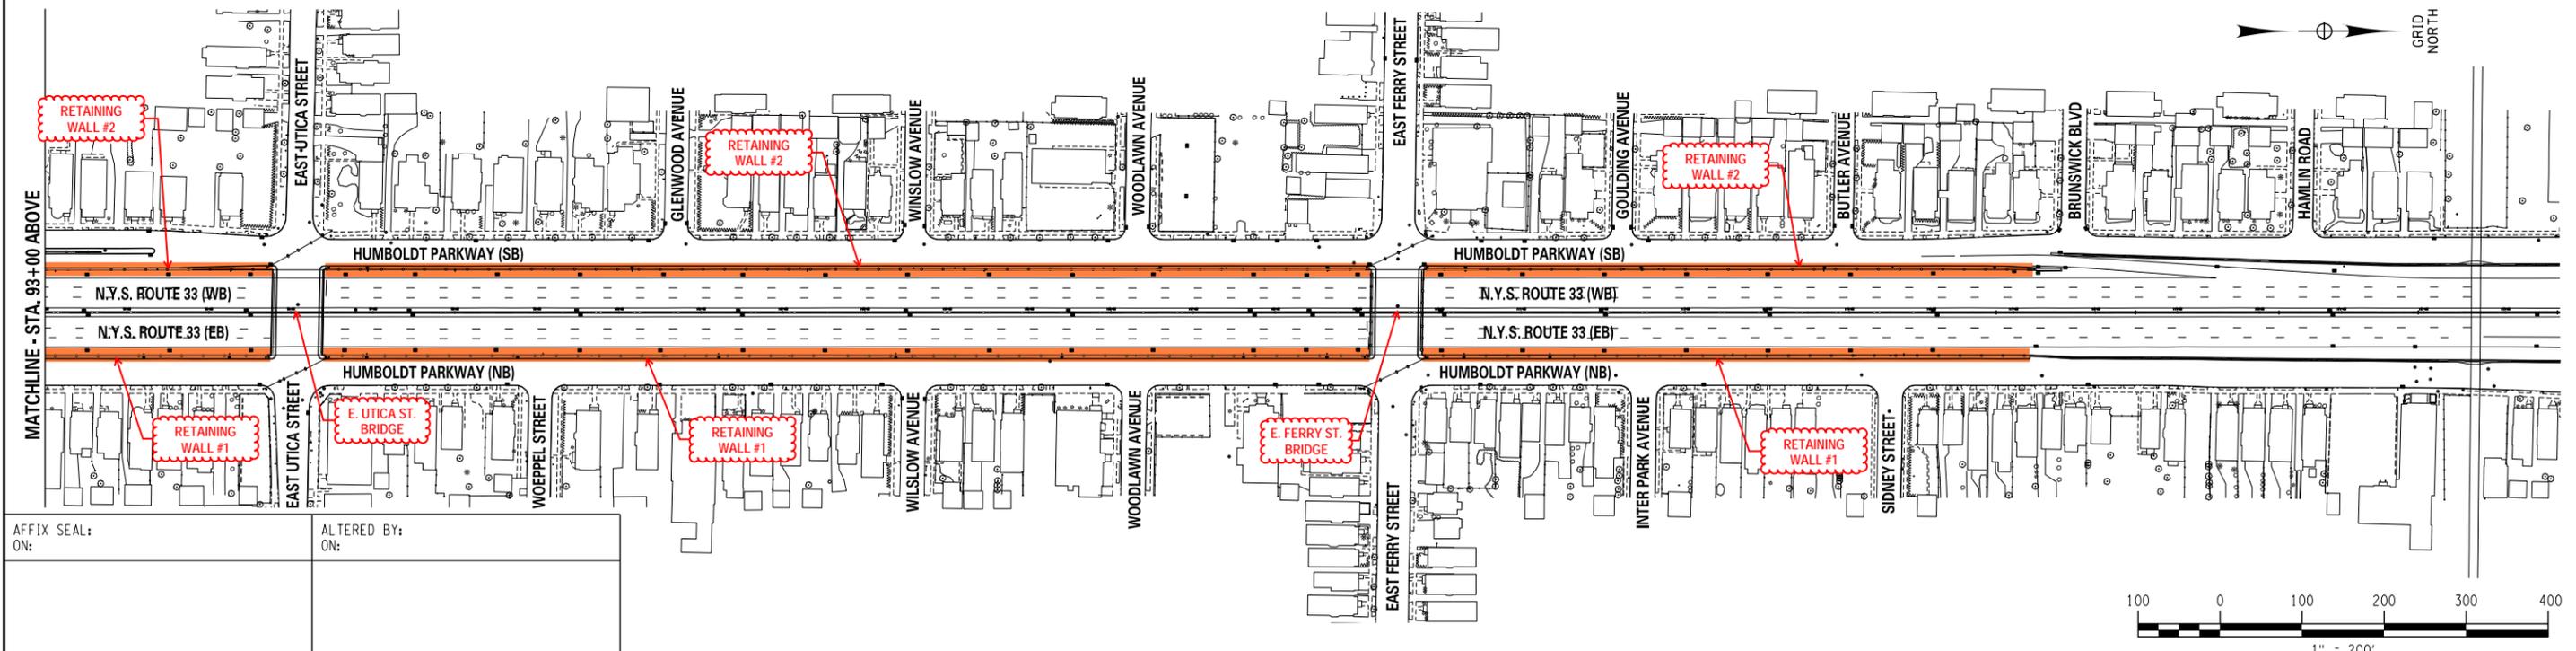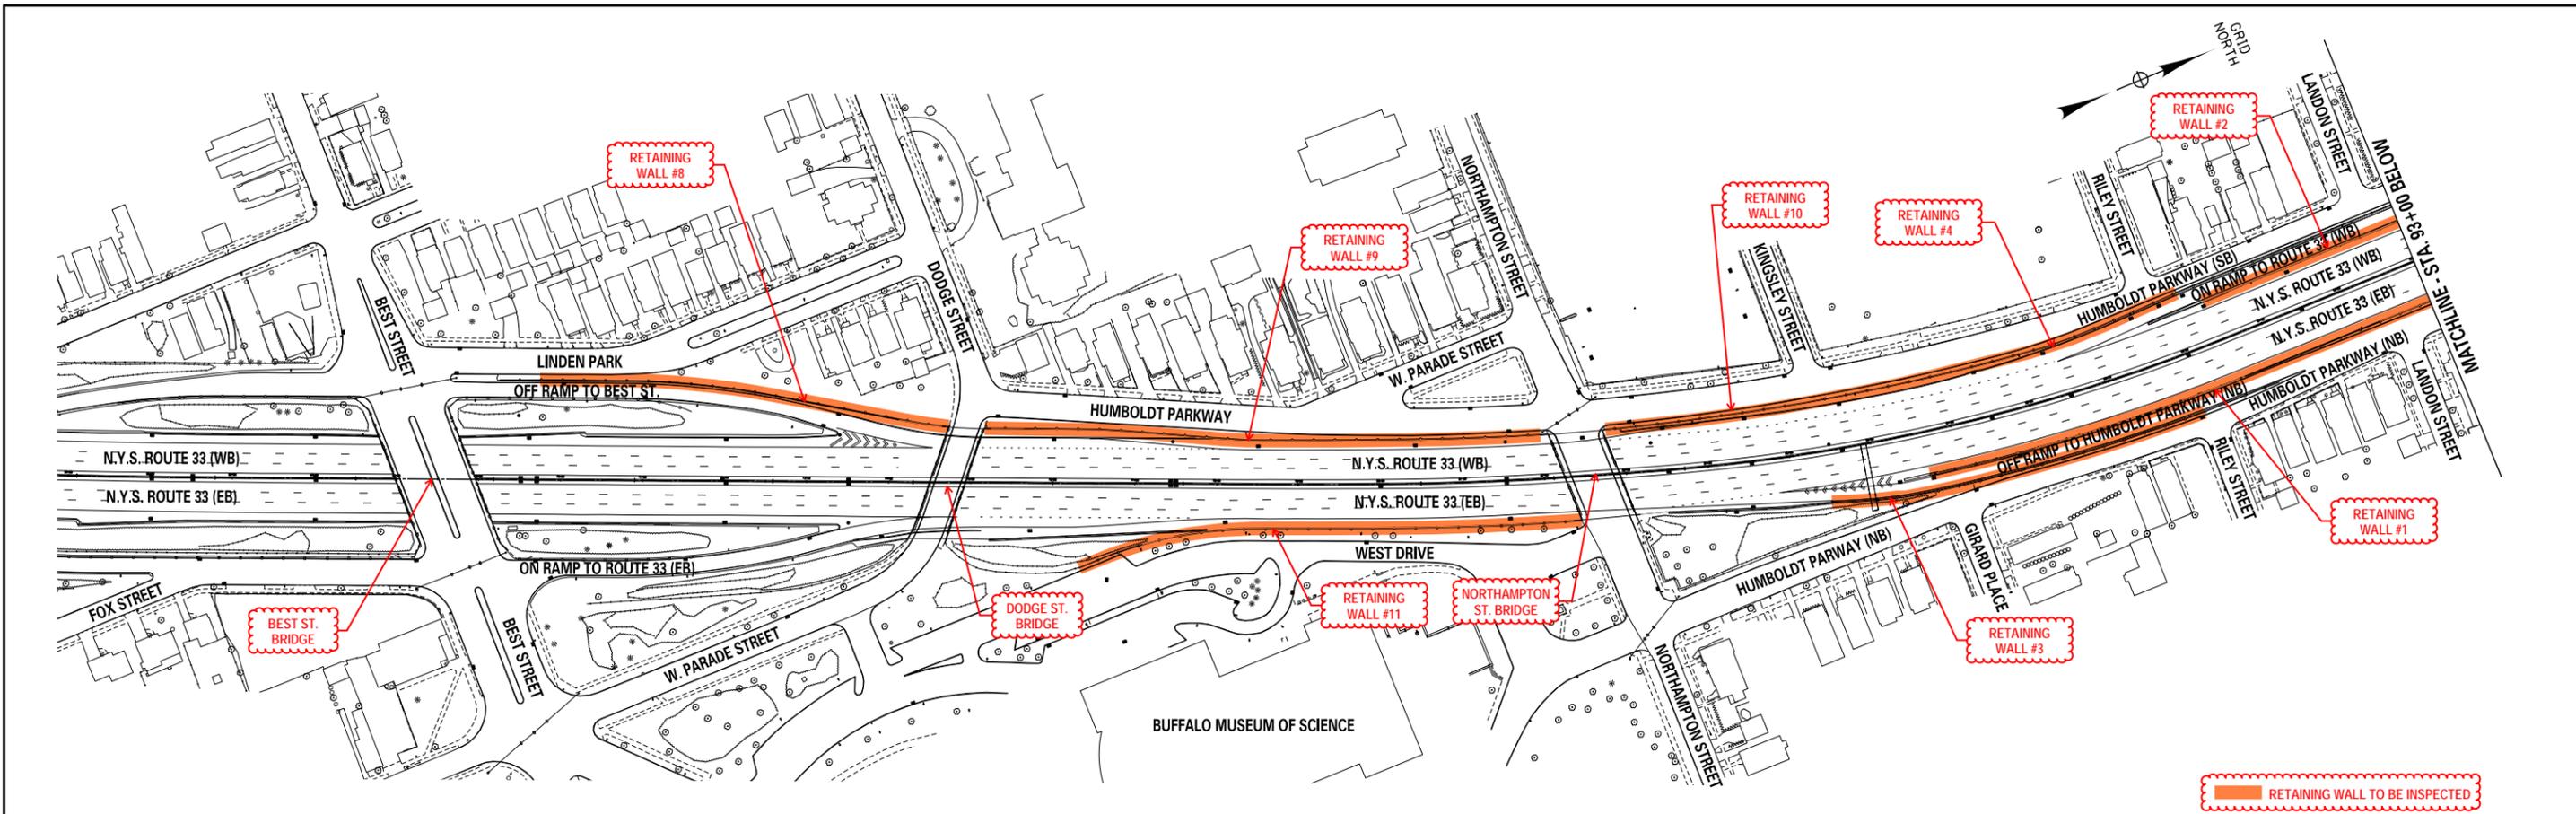

|                    |                    |
|--------------------|--------------------|
| AFFIX SEAL:<br>ON: | ALTERED BY:<br>ON: |
|--------------------|--------------------|


|  |                       |             |         |          |   |                 |
|--|-----------------------|-------------|---------|----------|---|-----------------|
| AS-BUILT REVISIONS<br>DESCRIPTION OF ALTERATIONS:  | STATE ROUTE 33        | PIN 5512.52 | BRIDGES | CULVERTS | ALL DIMENSIONS IN FT UNLESS OTHERWISE NOTED | CONTRACT NUMBER |
|  | KENSINGTON EXPRESSWAY |             |         |          |   |                 |
|  | CITY OF BUFFALO       |             |         |          |   |                 |
|  | COUNTY: ERIE          |             |         |          |   |                 |
| IT IS A VIOLATION OF LAW FOR ANY PERSON, UNLESS THEY ARE ACTING UNDER THE DIRECTION OF A LICENSED PROFESSIONAL ENGINEER, ARCHITECT, LANDSCAPE ARCHITECT, OR LAND SURVEYOR, TO ALTER AN ITEM IN ANY WAY. IF AN ITEM BEARING THE STAMP OF A LICENSED PROFESSIONAL IS ALTERED, THE ALTERING ENGINEER, ARCHITECT, LANDSCAPE ARCHITECT, OR LAND SURVEYOR SHALL STAMP THE DOCUMENT AND INCLUDE THE NOTATION "ALTERED BY" FOLLOWED BY THEIR SIGNATURE, THE DATE OF SUCH ALTERATION, AND A SPECIFIC DESCRIPTION OF THE ALTERATION. |                       |             |         |          |   |                 |
| <b>KENSINGTON EXPRESSWAY</b><br><b>RETAINING WALL LOCATION PLAN</b>  |                       |             |         |          | DRAWING NO. 1<br>SHEET NO.                  |                 |
|  |                       |             |         |          |   |                 |

General: Map cracking on coping

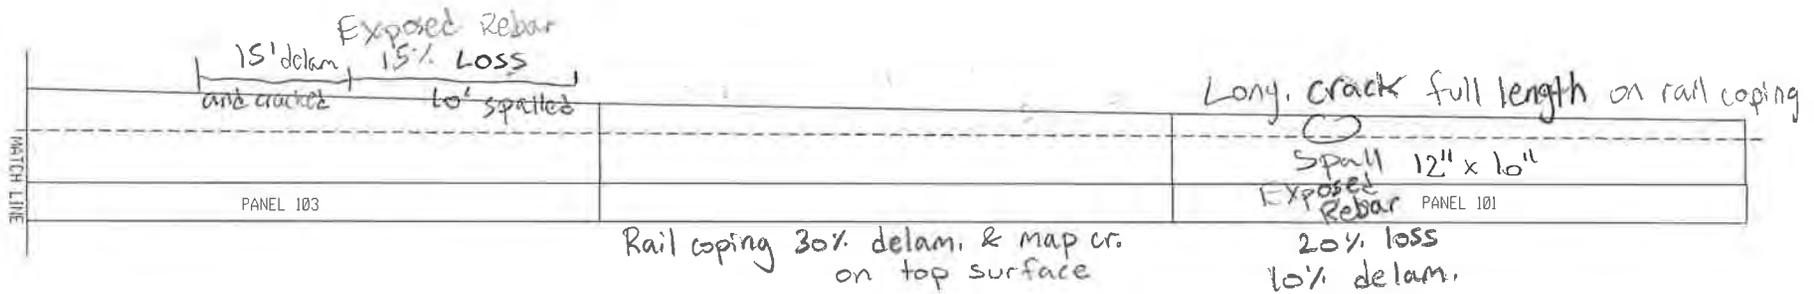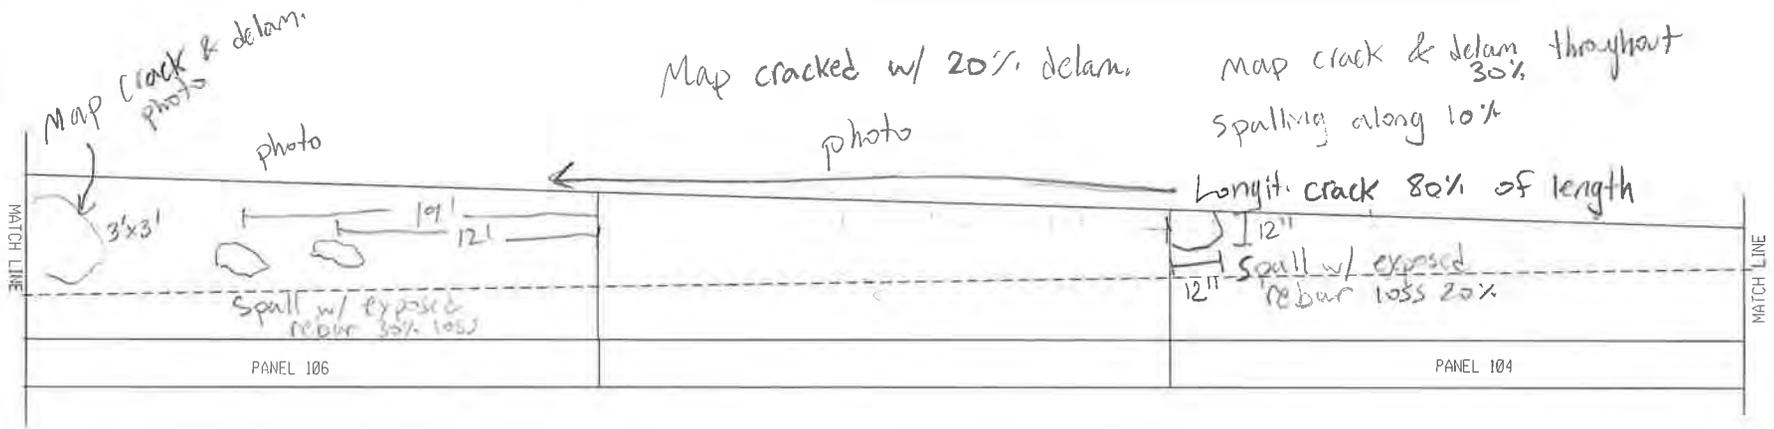

delaminated


RW 1 PANELS 106-101

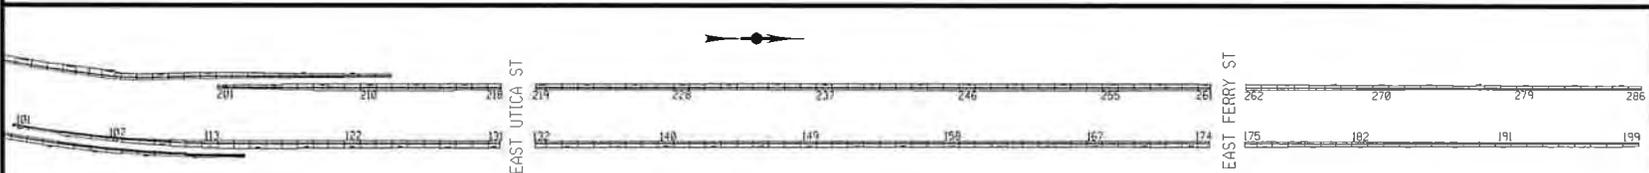

BY: RIM  
 DATE: 5/3/23  
 SCALE: 1" = 10'

Map cracking under rail posts

General: Distress on coping under rail posts

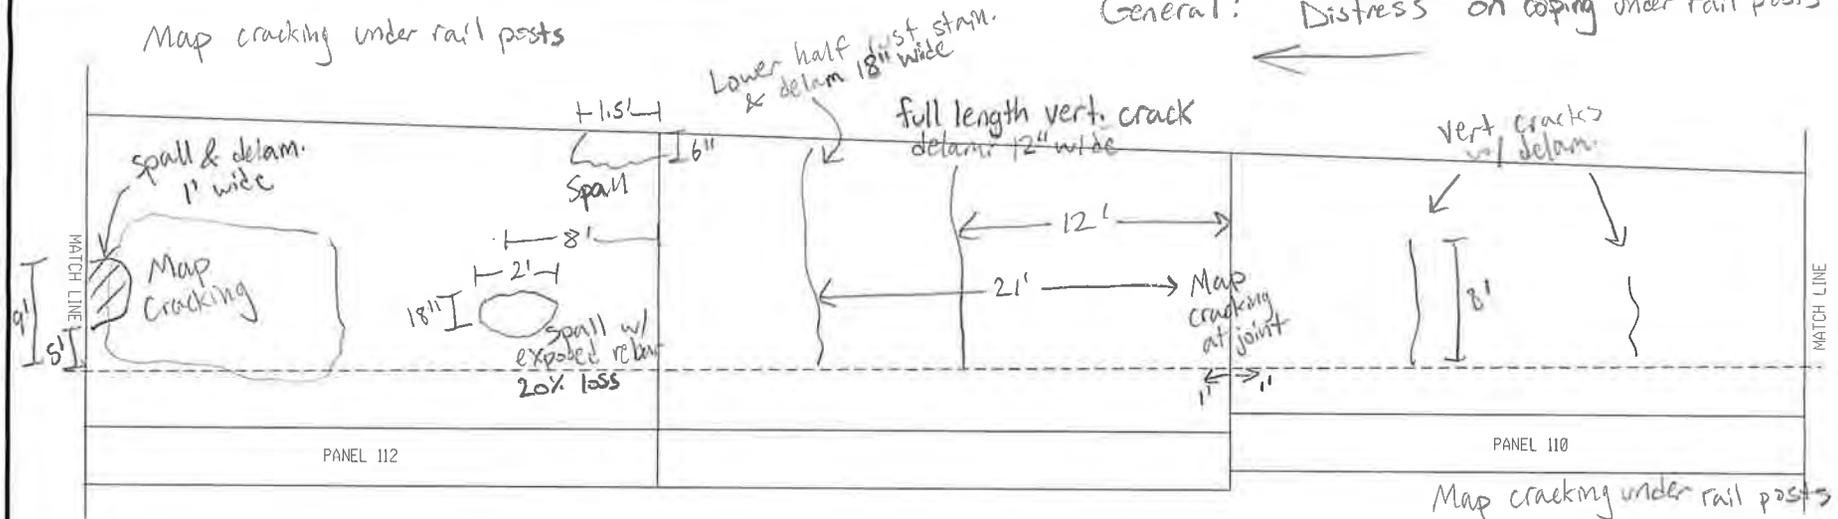

10% delam. throughout map cracked throughout more so at rail posts

spall under rail post


full length vert. crack delam 12\"/>

delam. 50%, map cracked, photo stained

General Map cracking and staining throughout



General: Map cracking on coping

### RW 1 PANELS 112-107

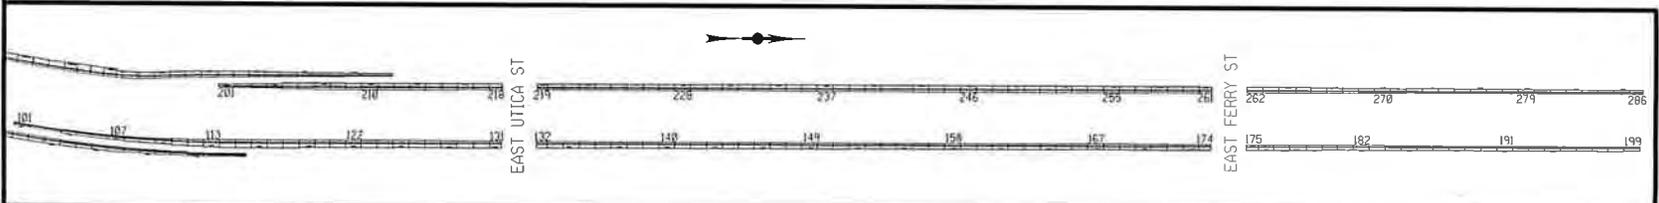


BY: RIM  
 DATE: 5/3/23  
 SCALE: 1" = 10'

Coping - Crack @ mid height - full length (top)

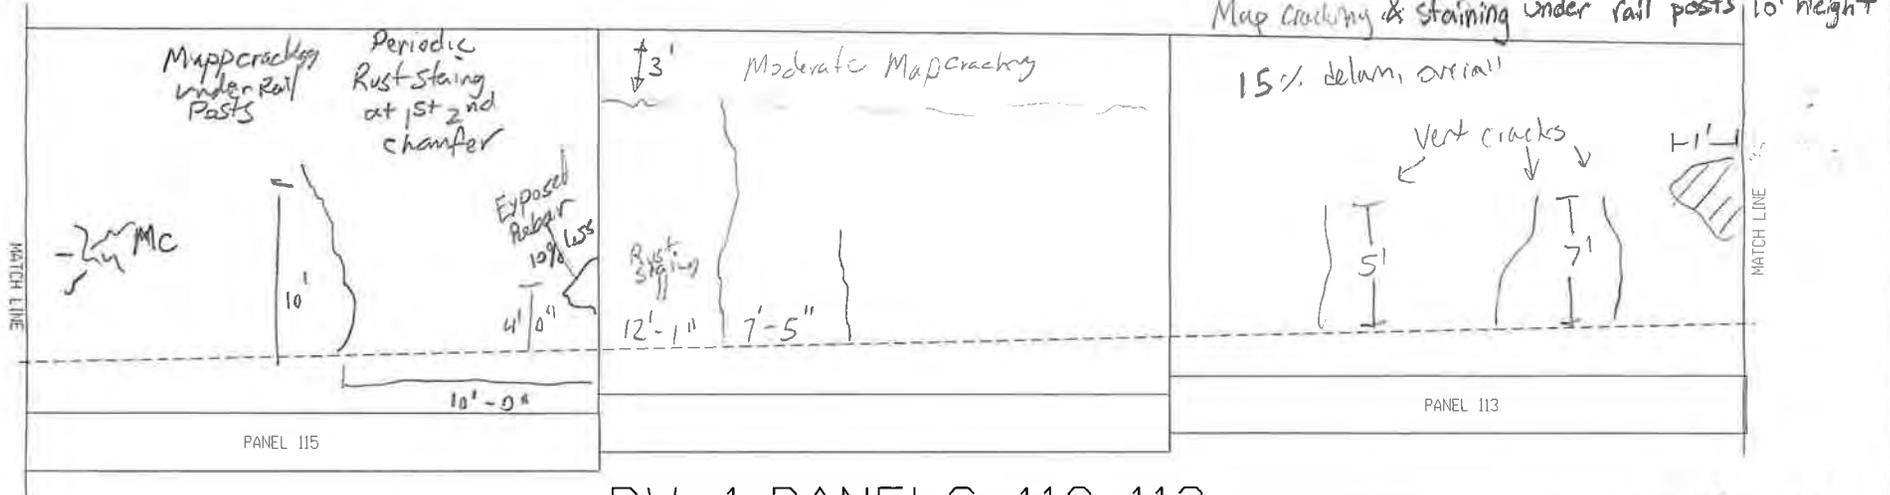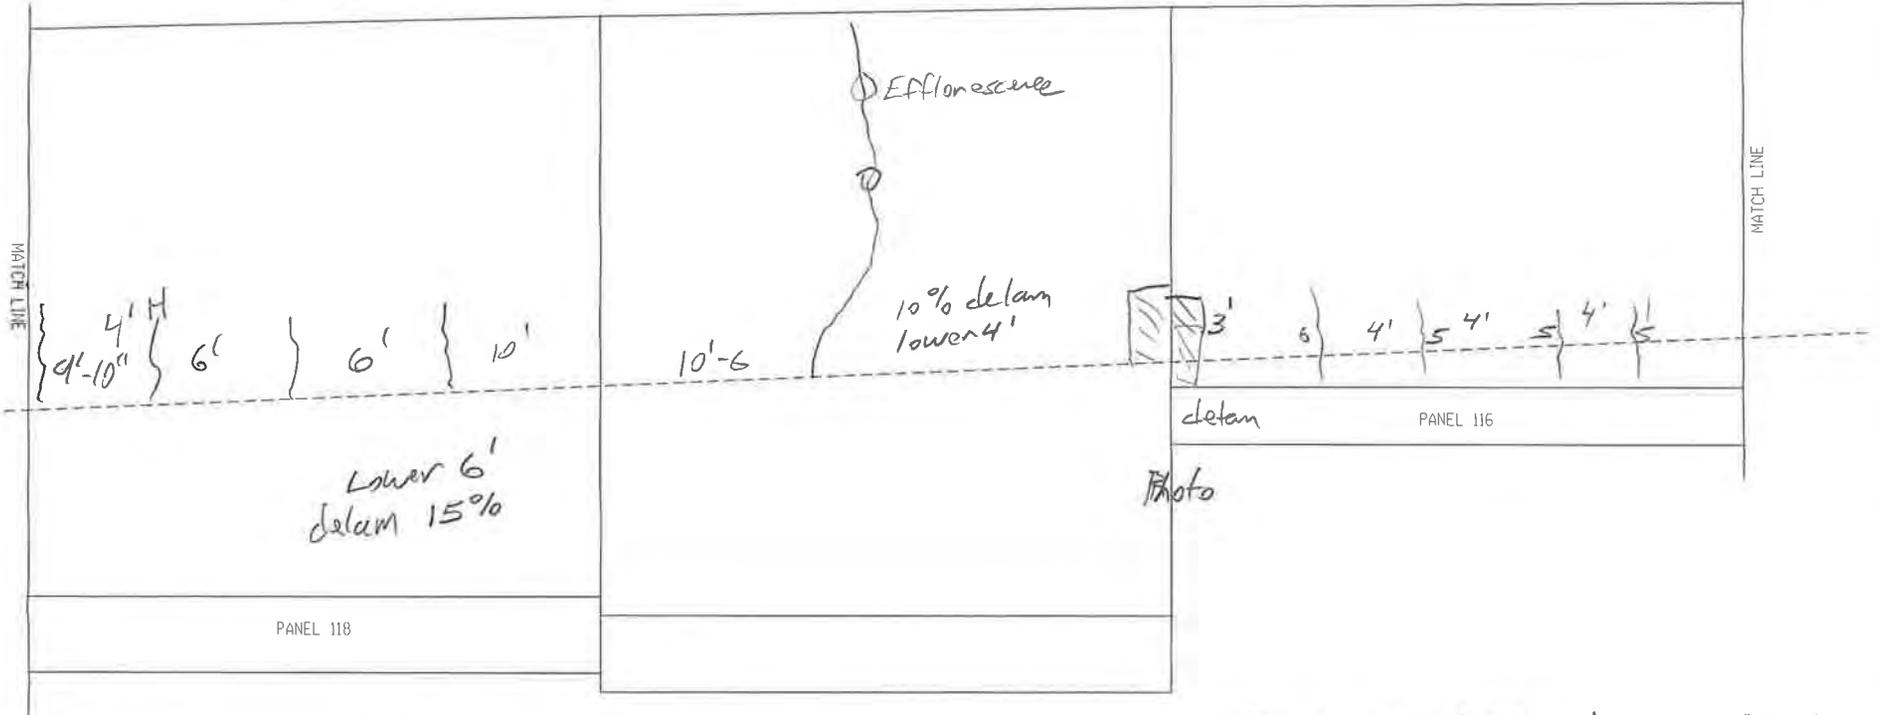


RW 1 PANELS 118-113

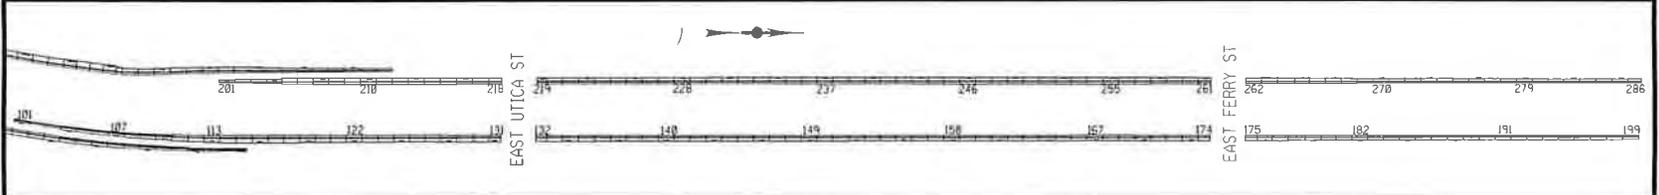


BY: MJE  
 DATE: 5/4/23  
 SCALE: 1" = 10'

119 has light  
can be viewed  
from face

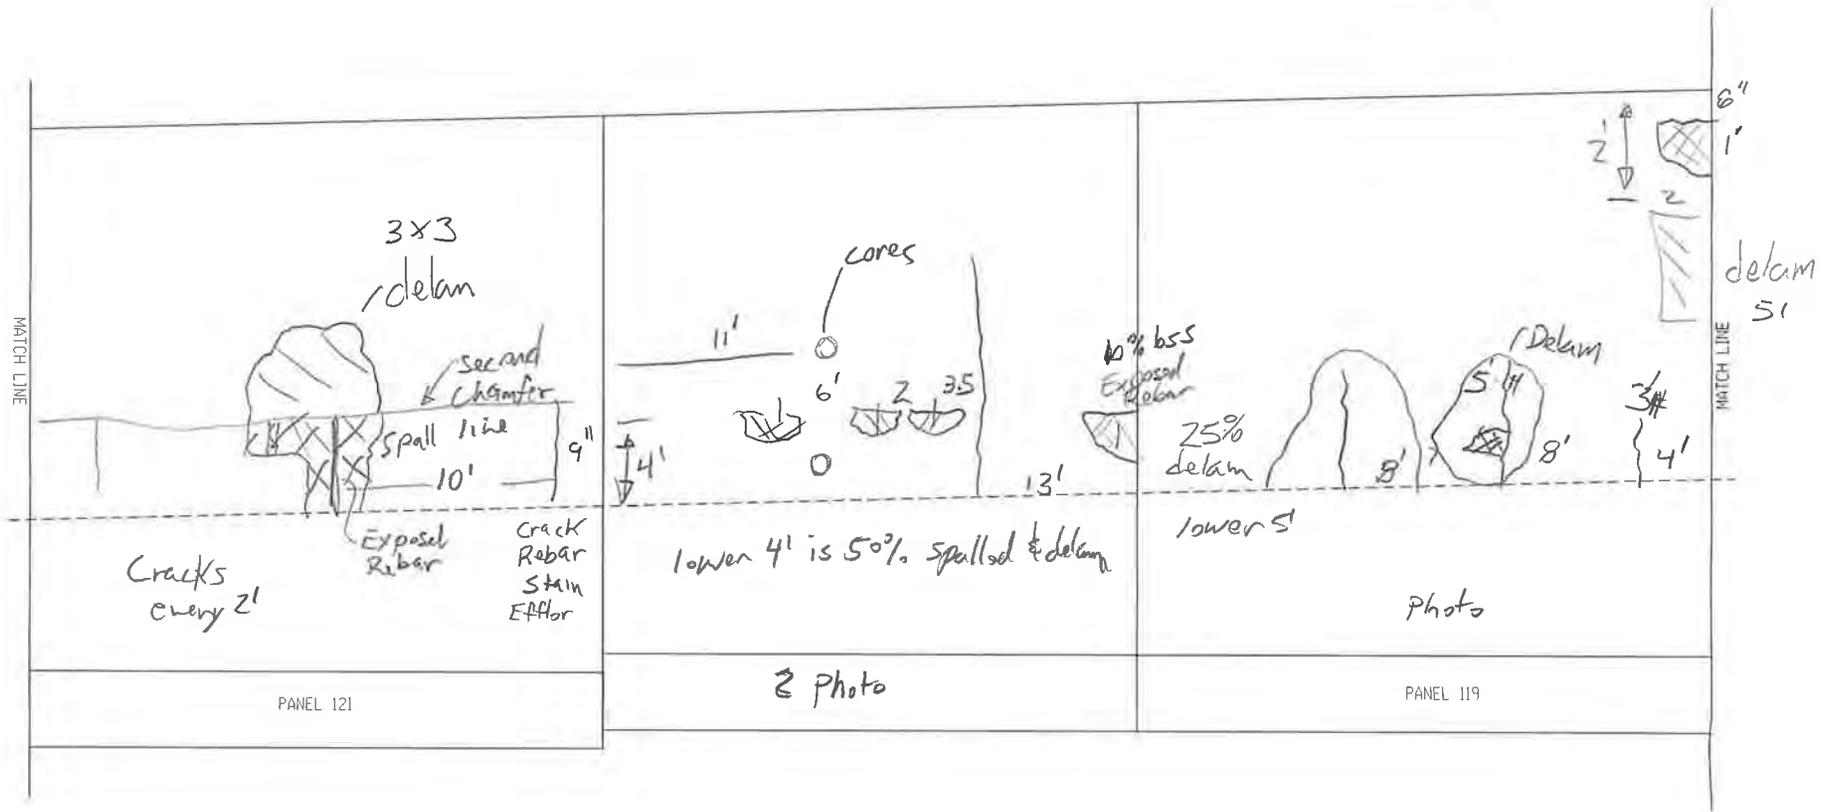


RW 1 PANELS 121-119

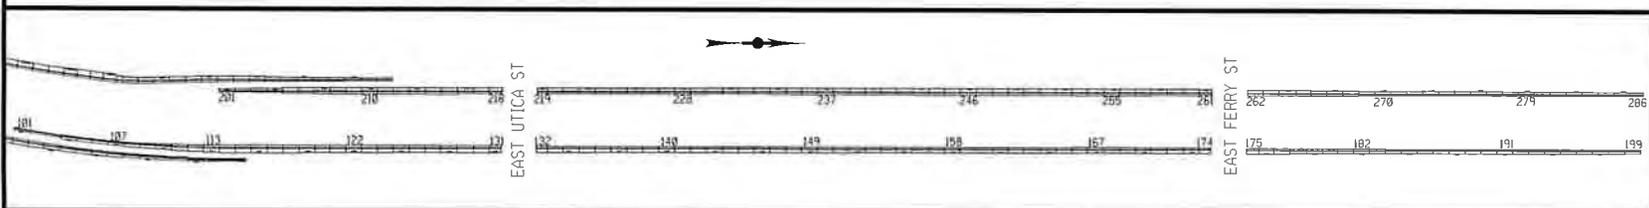

BY: MJE  
 DATE: 5/4/23  
 SCALE: 1' = 10'



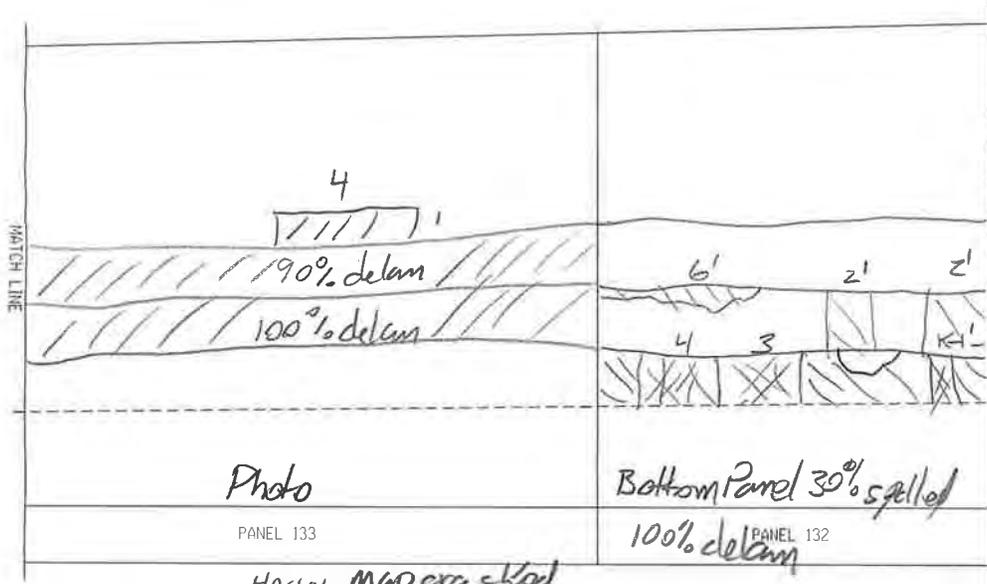

Photo


PANEL 133

Heavy mapcracked

Bottom Panel 30% spalled  
100% delam

PANEL 132

Photo

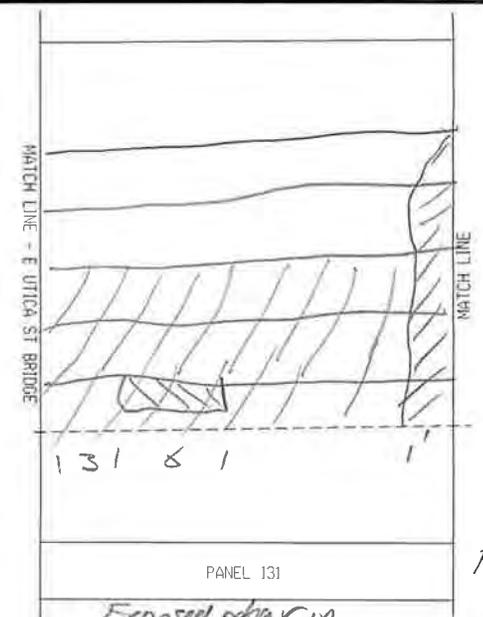


13% delam  
6% delam

PANEL 131

Exposed rebar in  
spill 60' section

Photo

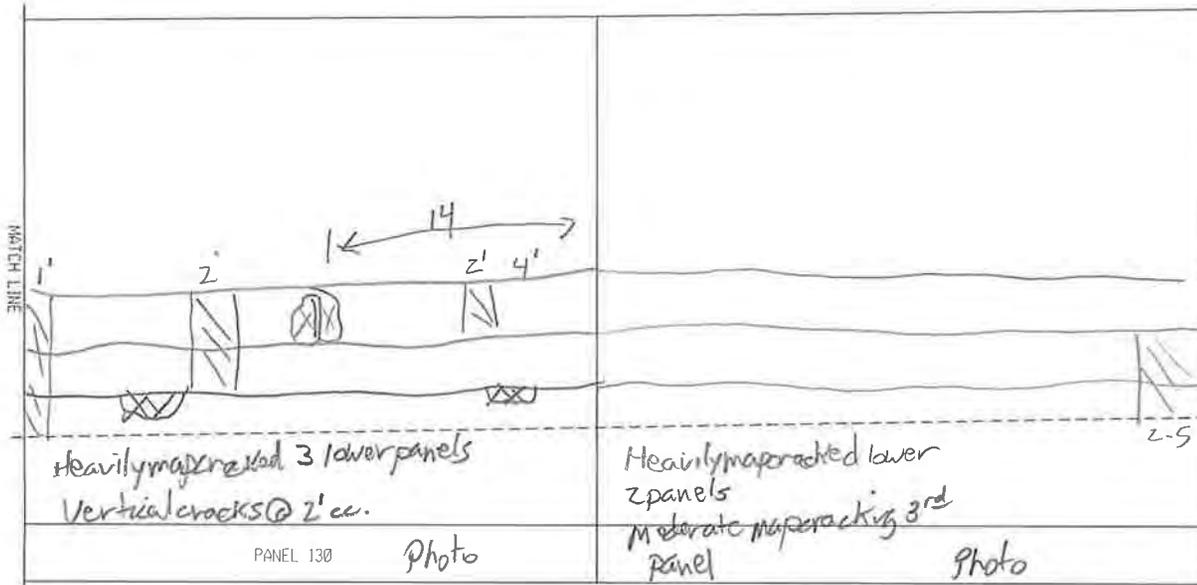


Heavily mapcracked 3 lower panels  
Vertical cracks @ 2' cc.

PANEL 130

Photo

Heavily mapcracked lower  
2 panels  
Moderate mapcracking 3rd  
panel

Photo


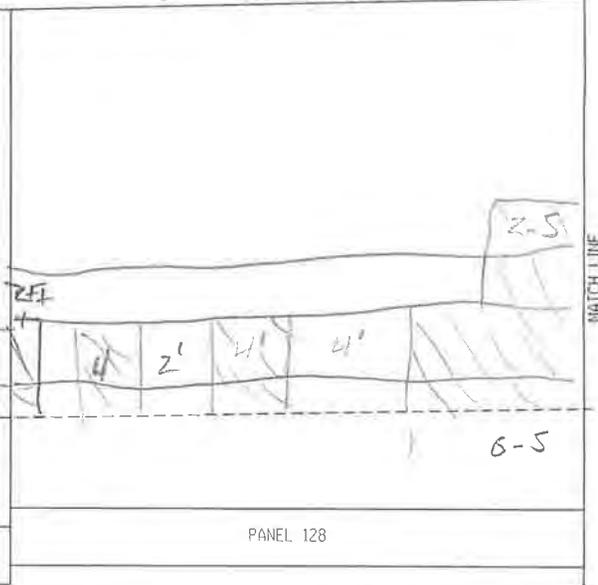


2.5% delam

6.5% delam

PANEL 128

RW 1 PANELS 133-128

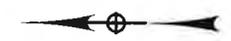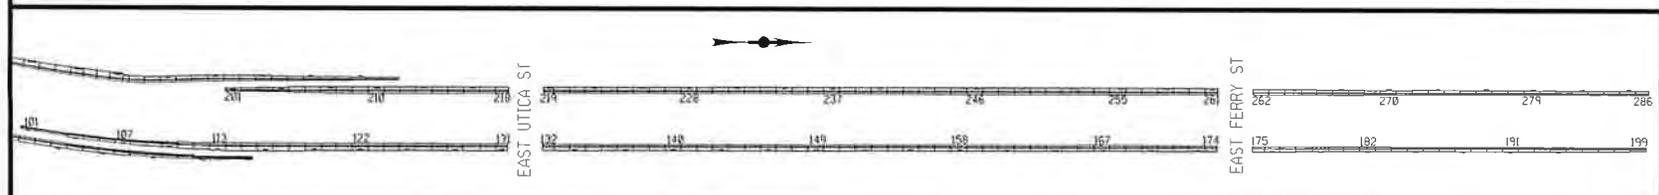

BY: MJE  
DATE: 5/4/23  
SCALE: 1" = 10'



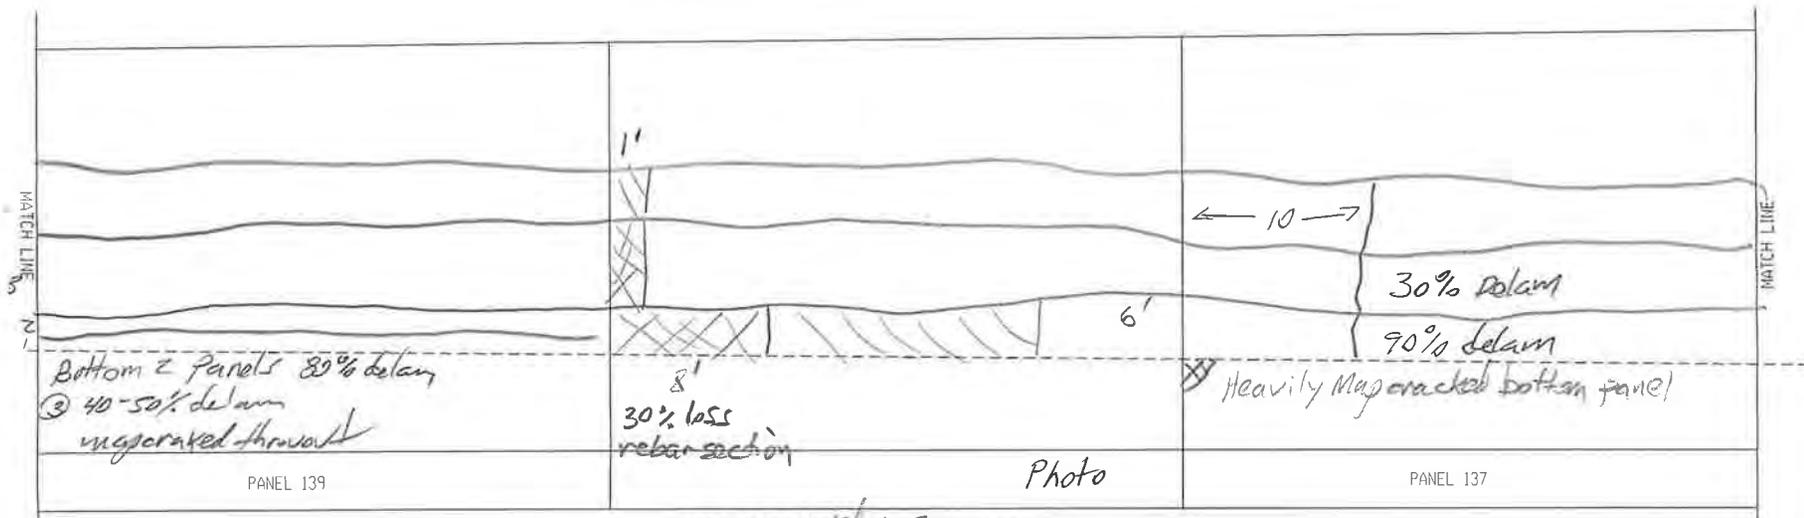


Photo  
 Mapcracked 1-2  
 ① delam & spalled 70%  
 ② 40% delam

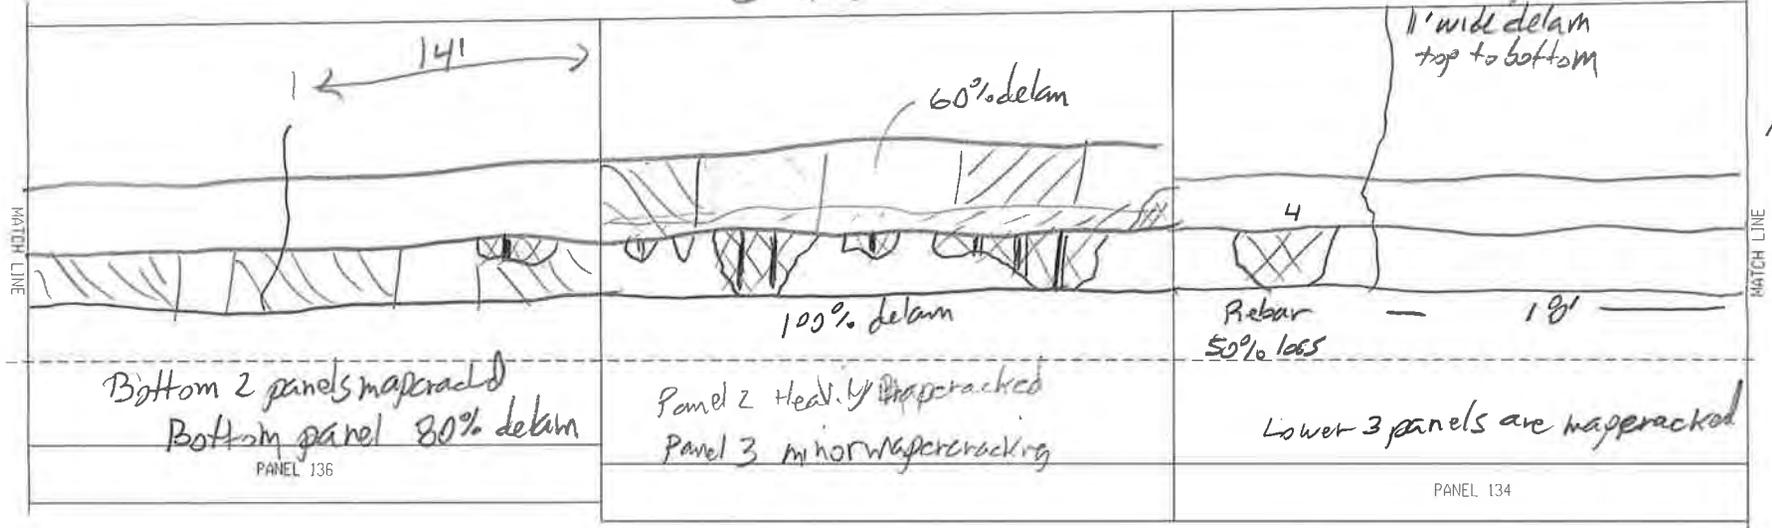


RW 1 PANELS 139-134

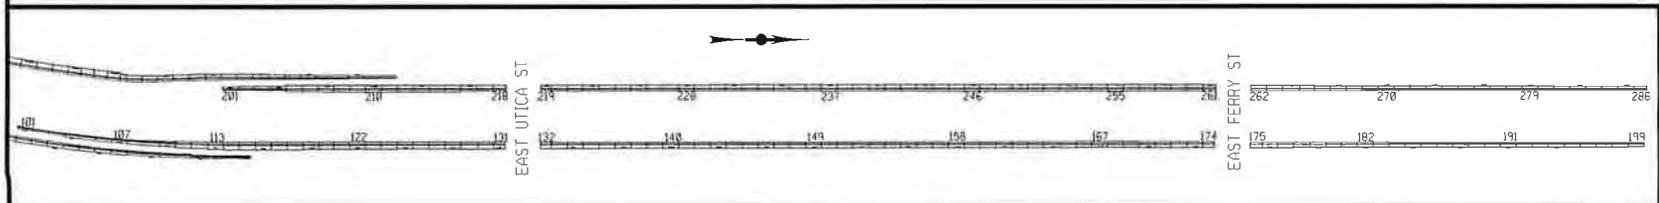

BY: MJE  
 DATE: 5/4/23  
 SCALE: 1" = 10'


Rail coping cracked at mid height with efflorescence and rust staining Photo

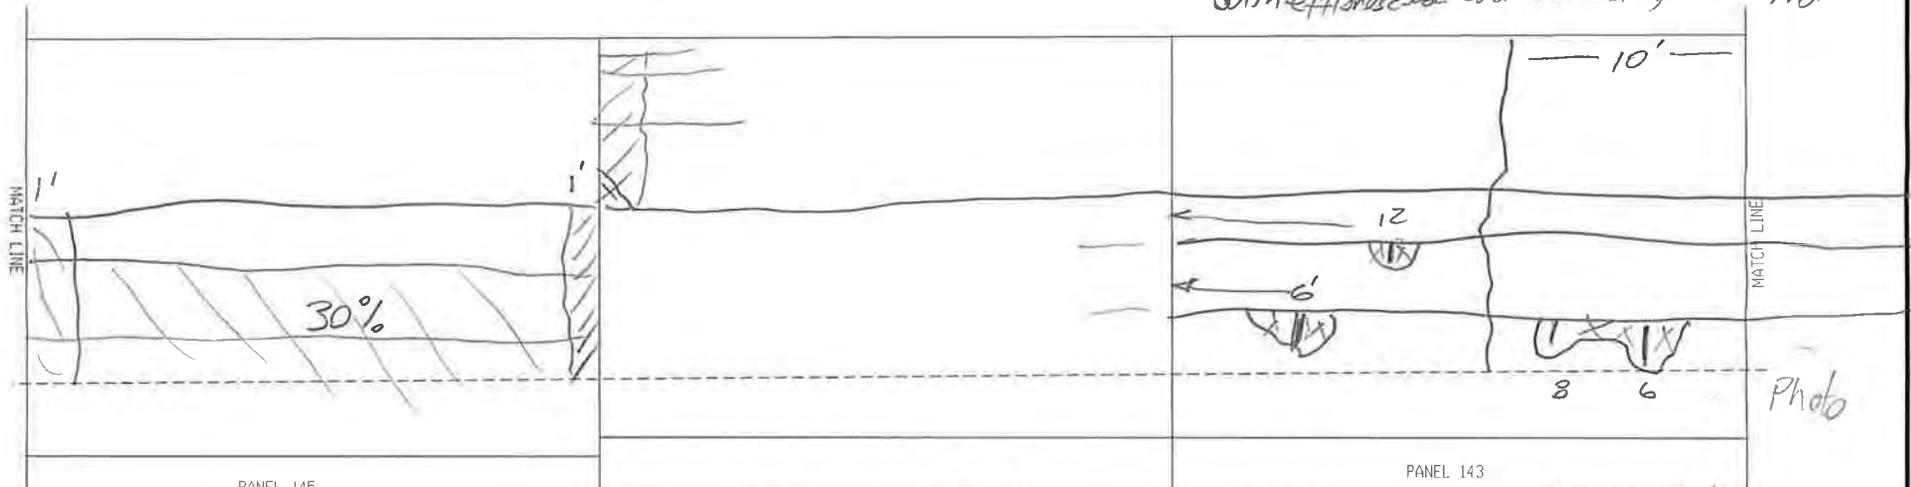


Bottom 2 panels heavily mapcracked cracking every 2 ft at rebar lines Rust staining throughout

Heavily Mapcracked with cracking at rebar lines 60-70% delam Photo


Bottom 2 panels heavily mapcracked 70% delam Panel 3 - 25% delam

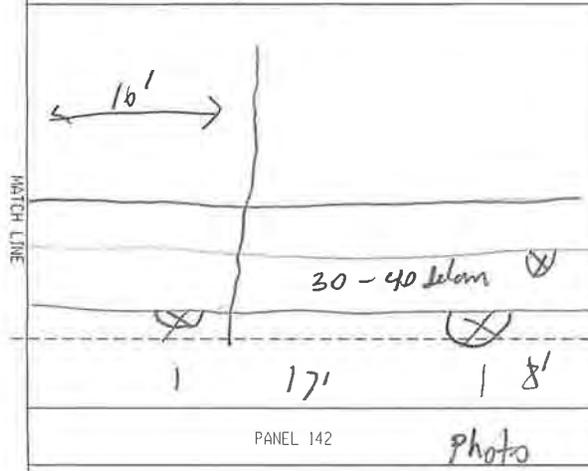

Panel 1 & 2 Heavy mapcracking Photo


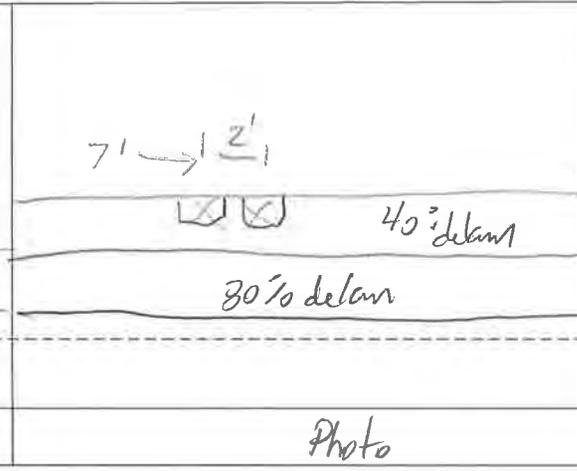


Photo

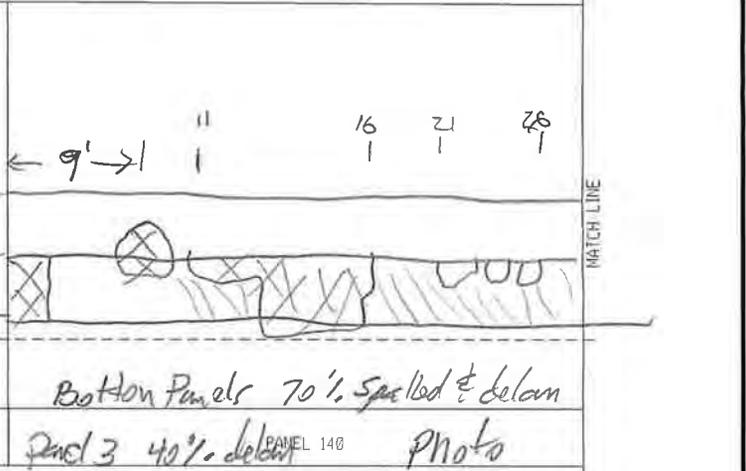


Bottom Panels 70% spalled & delam Panel 3 40% delam with mapcracking Photo

RW 1 PANELS 145-140

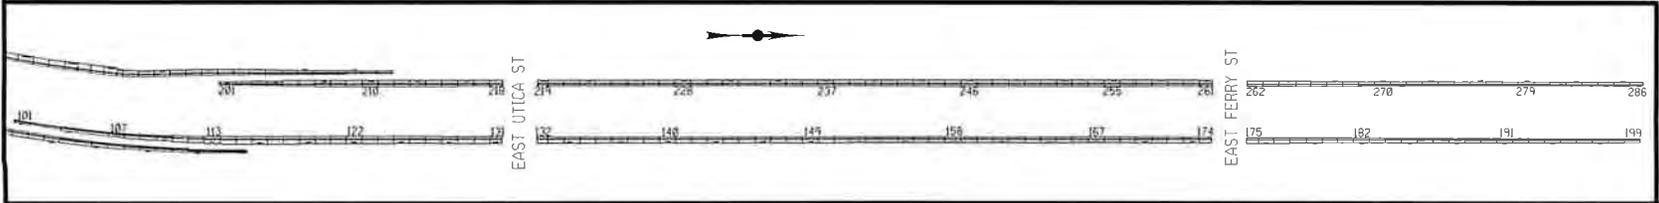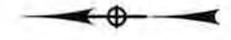

BY: MJE  
 DATE: 5/4/23  
 SCALE: 1' = 10'

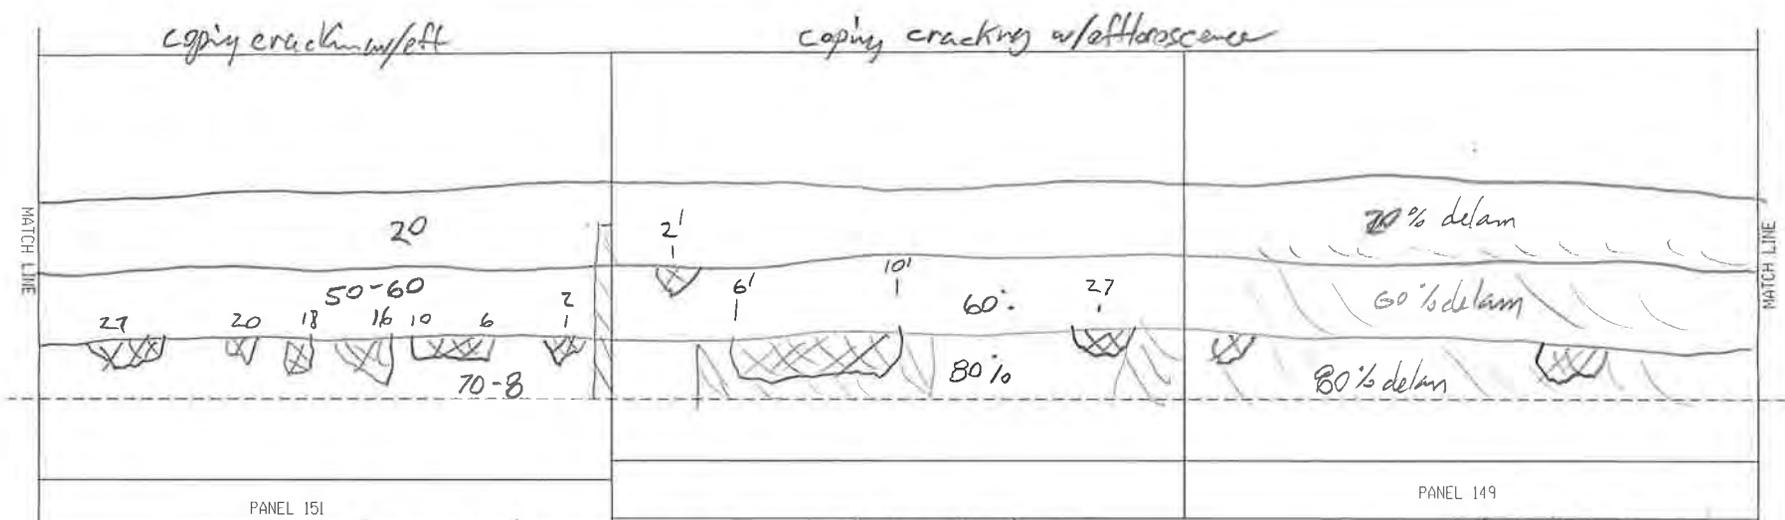


①② Heavily mapcracked and spalled with extensive delam

③ Mapcracking

② Mapcracked through out Photo

Heavily mapcracked bottom 2 panels 3 minor mapcracking

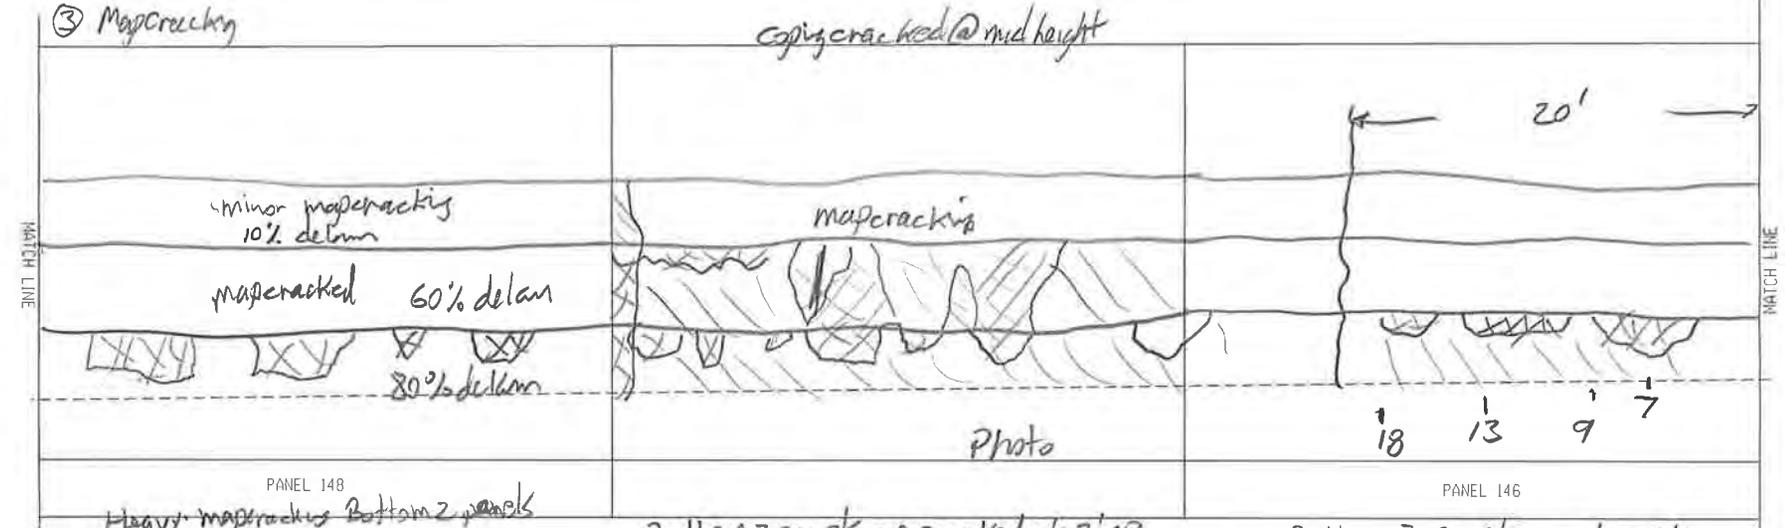


Heavy mapcracking Bottom 2 panels

Bottom 2 panels are cracked at 2' sp with spally delam, rust staining 75% delam

Bottom 2 panels are heavily mapcracked with spalling 60% delam

Panel 3 light mapcracking 20% delam


RW 1 PANELS 151-146

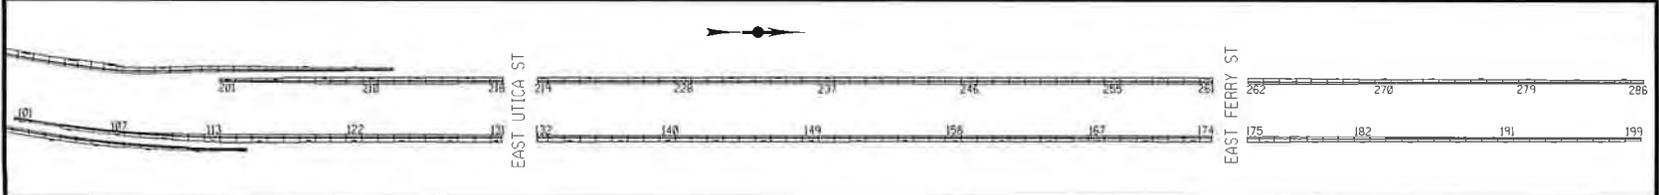

BY: MJE

DATE: 5/4/23

SCALE: 1" = 10'

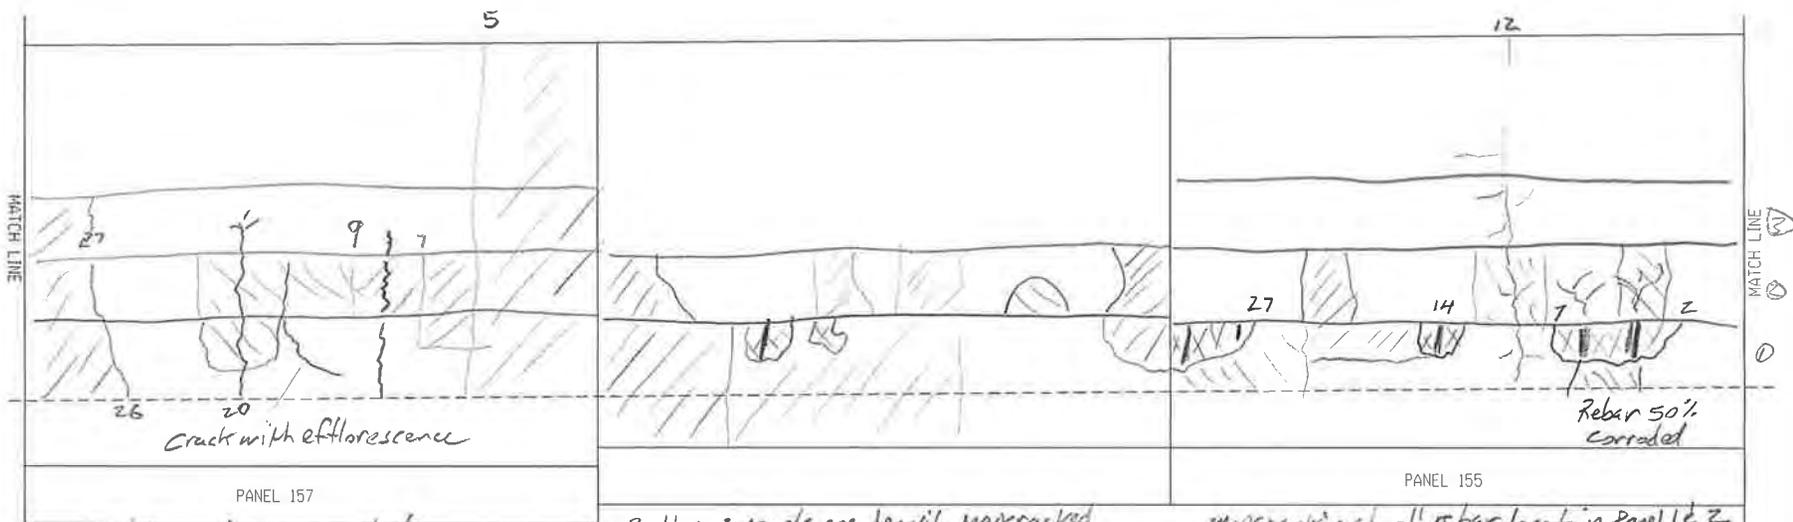

PANEL 157  
 Panel 1 & 2 heavily mapcracked  
 ① 60% delam  
 ② 70% delam  
 ③ 20% delam


Photo

Bottom 2 panels are heavily mapcracked  
 mapcracking follows rebar pattern  
 rust staining  
 Bottom panel 20% delam  
 Panel 2 60% delam

Photo

Mapcracking at all rebar location Panel 1 & 2  
 ① is 50% delam  
 ② 40%  
 ③ 20%

Photo

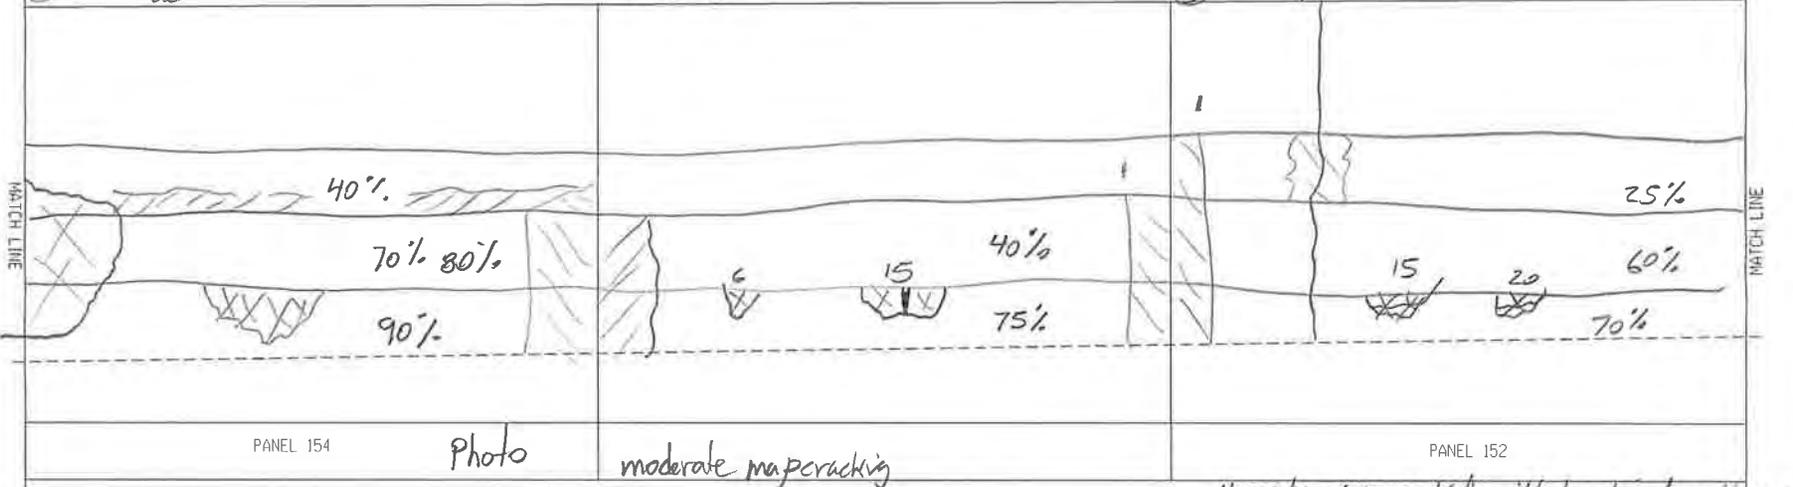


PANEL 154  
 Panel 1 & 2 heavily mapcracked with spalling  
 & del delam

Photo


moderate mapcracking

PANEL 152  
 Heavily mapcracked with localized spalling  
 and delam

RW 1 PANELS 157-152

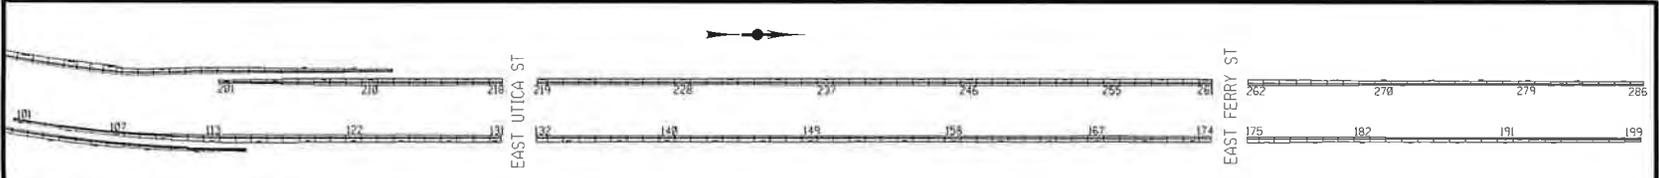

BY: MJE  
 DATE: 5/4/23  
 SCALE: 1" = 10'

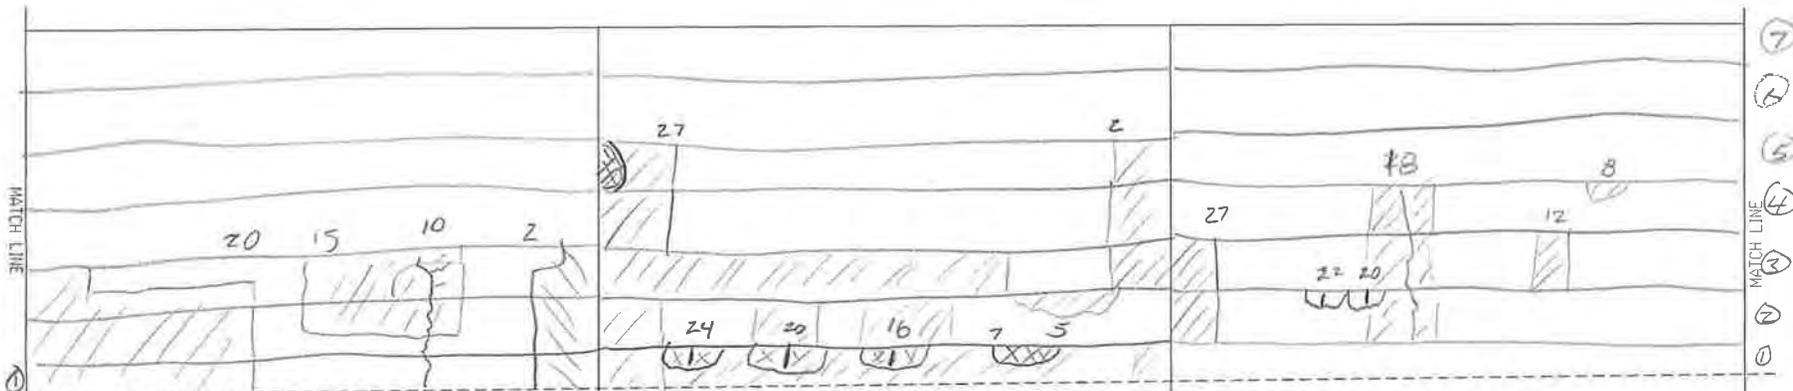

delam ① 40% ② 50% ③ 50%

PANEL 163


Bottom 2 panels are heavily mapcracked moderate mapcrack  
3 Photo

① 80% delam  
② 60%  
③ 90%

PANEL 161

Bottom 3 panels are Heavily mapcracked with spalling and exposed rebar and rust staining  
Cracking follow rebar pattern rebar section loss 30%

Bottom 3 panels are heavily mapcracked with rust staining

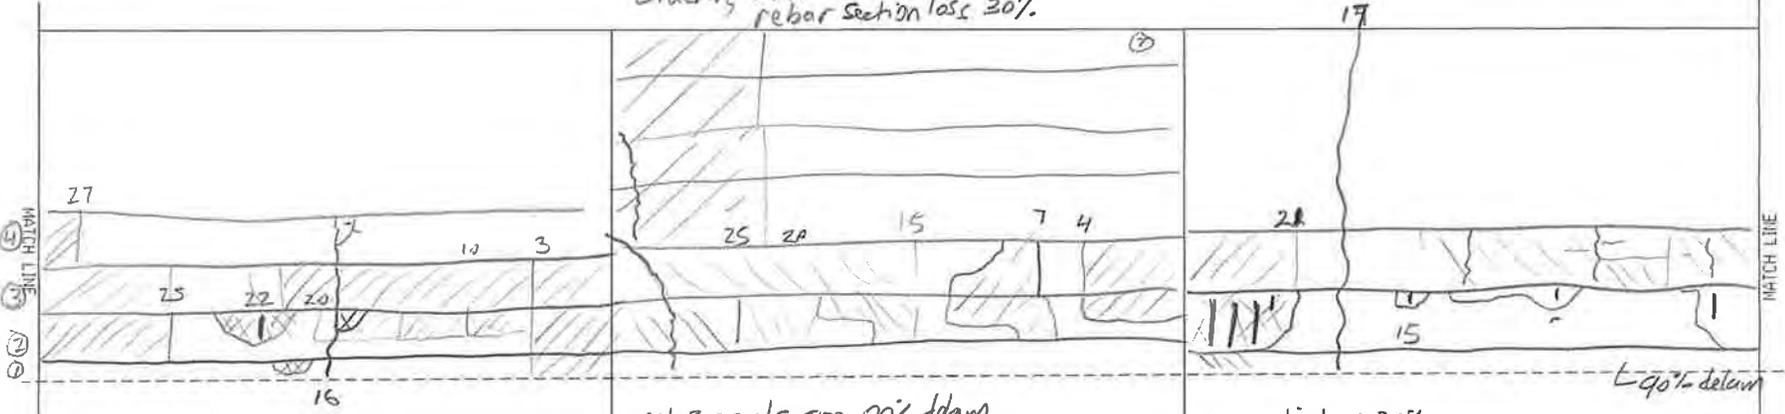

PANEL 160

3 lower panels are heavily mapcracked with rust staining  
panels ①②③ 80% delam Photo

All 3 panels are 80% delam

Bottom ③ panels are mapcracked with rust staining  
④-⑦ 20% delam


PANEL 158

Bar section loss 25%


② 30% delam  
③ 50% delam

Photo

RW 1 PANELS 163-158

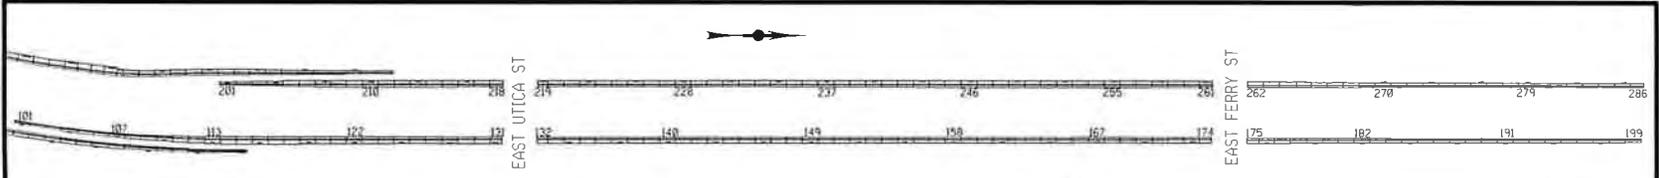

BY: MJE  
DATE: 5/4/23  
SCALE: 1" = 10'

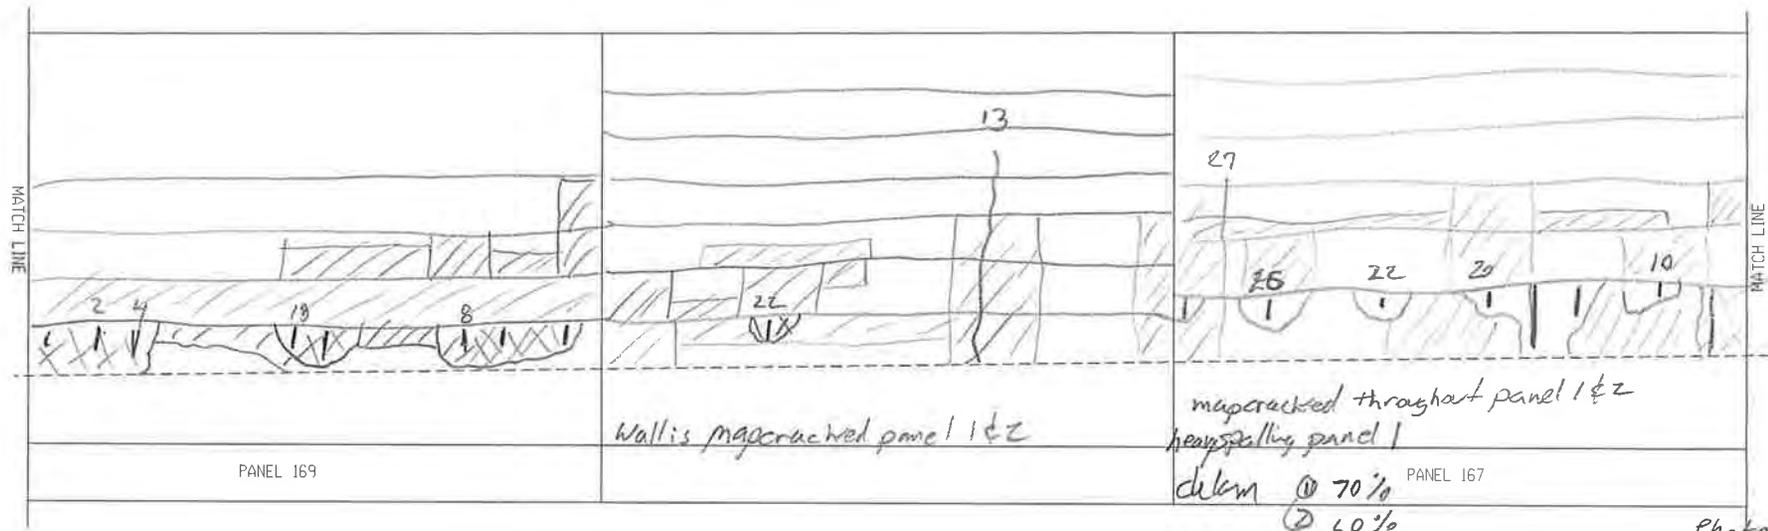


PANEL 169

Wall is moderately rebarcracked panel 1 & 2

rebarcracked throughout panel 1 & 2  
heavily spalling panel 1

- delam
- ① 70%
  - ② 60%
  - ③ 40%

Photo

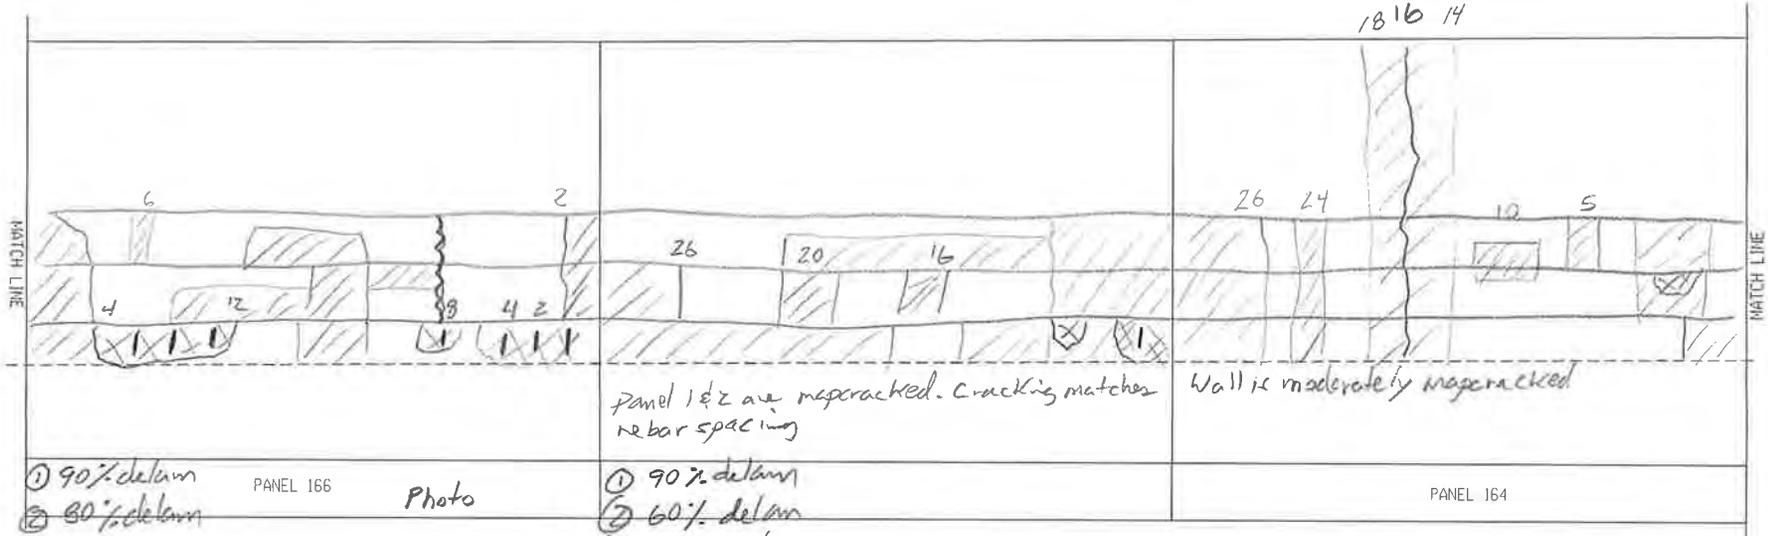

PANEL 166

Photo

- ① 90% delam
- ② 80% delam
- ③ 30% delam


Panel 1 & 2 are rebarcracked. Cracking matches rebar spacing

- ① 90% delam
- ② 60% delam
- ③ 20% delam


Wall is moderately rebarcracked

PANEL 164


RW 1 PANELS 169-164

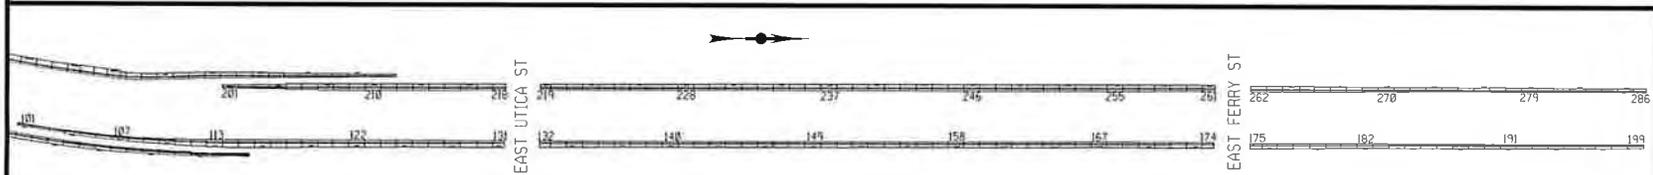


BY: MJE  
 DATE: 5/4/23  
 SCALE: 1" = 10'

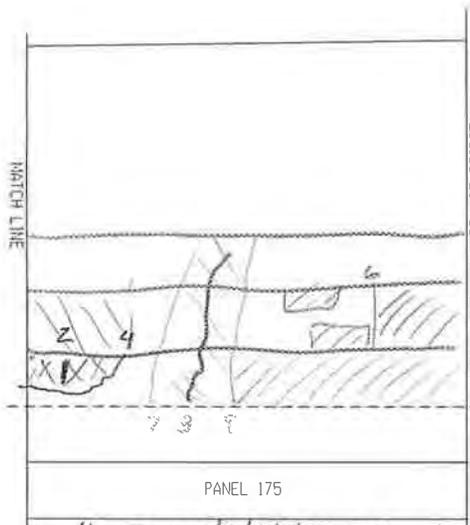


Bottom 2 panels heavily mapcracked with rust & staining - spalling exposed rebar  
 ① 70% delam  
 ② 50% delam

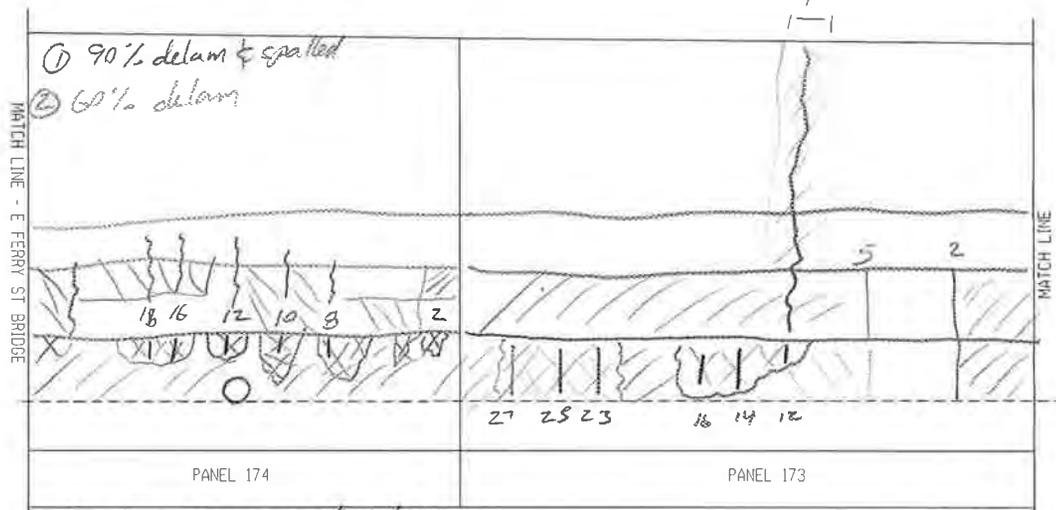


Non functioning weep at midspan weep full of silt  
 Heavily mapcracked with delam and spalling conc. Photo

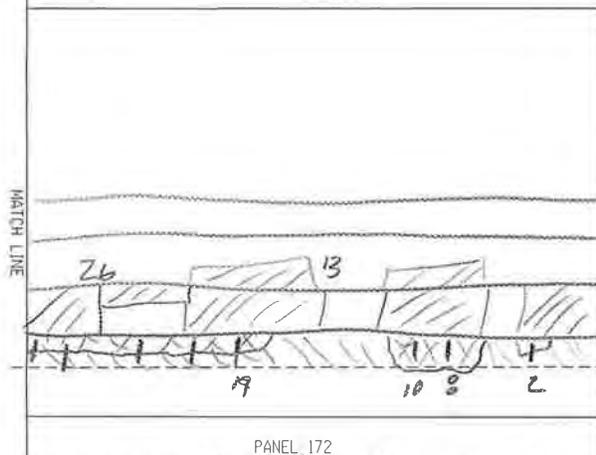

Heavy spalling delam and mapcracking  
 ① 90% delam  
 ② 70% delam  
 ③ 20% delam

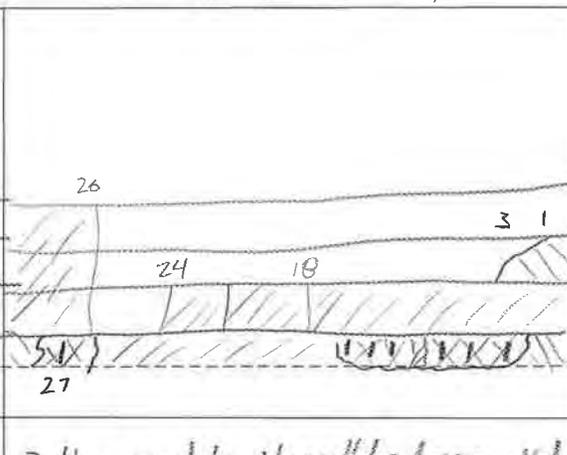


Bottom panel heavily spalled and mapcracked mapcracking mirrors rebar placement Photo

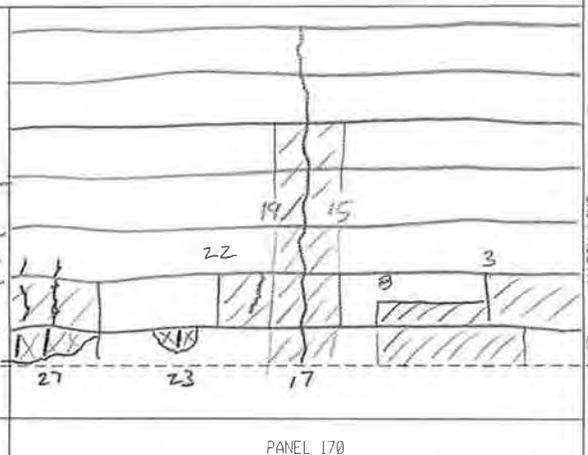


Lower 2 panels are mapcracked & spalled exposing some rebar. Core is delam  
 ① 60% delam  
 ② 60% delam  
 ③ 20% delam

Coping  
 ⑦  
 ⑧  
 ⑨  
 ⑩  
 ⑪  
 ⑫  
 ⑬  
 ⑭  
 ⑮  
 ⑯  
 ⑰  
 ⑱  
 ⑲  
 ⑳  
 ㉑  
 ㉒  
 ㉓  
 ㉔  
 ㉕  
 ㉖  
 ㉗  
 ㉘  
 ㉙  
 ㉚  
 ㉛  
 ㉜  
 ㉝  
 ㉞  
 ㉟  
 ㊱  
 ㊲  
 ㊳  
 ㊴  
 ㊵  
 ㊶  
 ㊷  
 ㊸  
 ㊹  
 ㊺  
 ㊻  
 ㊼  
 ㊽  
 ㊾  
 ㊿  
 ①  
 ②  
 ③  
 ④  
 ⑤  
 ⑥  
 ⑦  
 ⑧  
 ⑨  
 ⑩  
 ⑪  
 ⑫  
 ⑬  
 ⑭  
 ⑮  
 ⑯  
 ⑰  
 ⑱  
 ⑲  
 ⑳  
 ㉑  
 ㉒  
 ㉓  
 ㉔  
 ㉕  
 ㉖  
 ㉗  
 ㉘  
 ㉙  
 ㉚  
 ㉛  
 ㉜  
 ㉝  
 ㉞  
 ㉟  
 ㊱  
 ㊲  
 ㊳  
 ㊴  
 ㊵  
 ㊶  
 ㊷  
 ㊸  
 ㊹  
 ㊺  
 ㊻  
 ㊼  
 ㊽  
 ㊾  
 ㊿

RW 1 PANELS 175-170

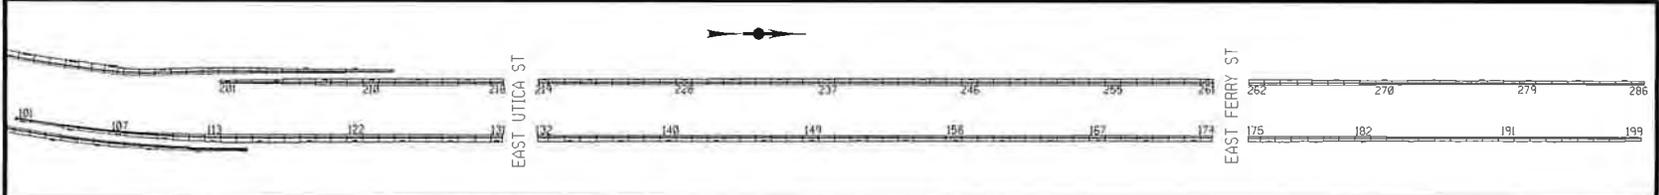


BY: MSE  
 DATE: 5/14/23  
 SCALE: 1" = 10'

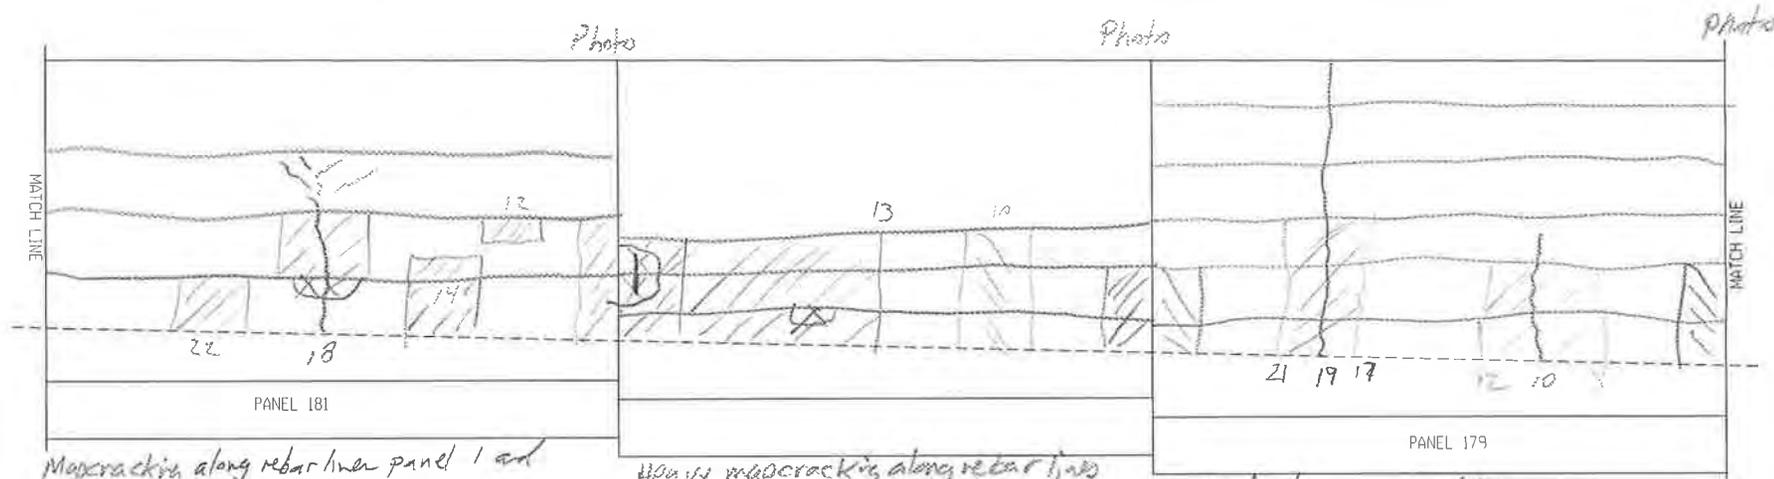

Mapcracking along rebar lines panel 1 and some panel 2  
 ① 30%  
 ② 25%

Heavy mapcracking along rebar lines on lower 2 panels - moderate on 3rd panel  
 ① 50% delam ③ 35%  
 ② 50% delam

Moderate mapcracking  
 ① 50% delam ③ 10% delam  
 ② 50% delam

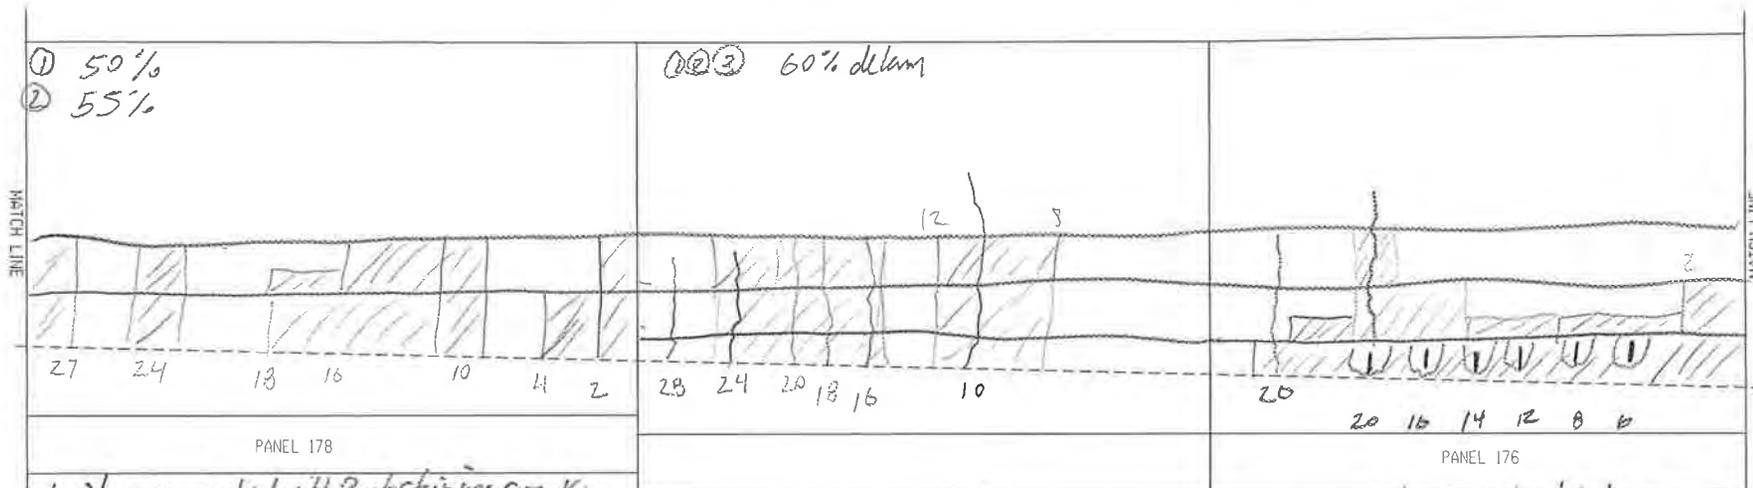

① 50%  
 ② 55%


①②③ 60% delam

Heavily mapcracked with rust staining, crack in mirrors vertical rebar spacing - cracks every 2 ft.


Mapcracking along rebar lines

Mapcracked with rust staining  
 ① 80% delam  
 ③ 50% delam

RW 1 PANELS 181-176

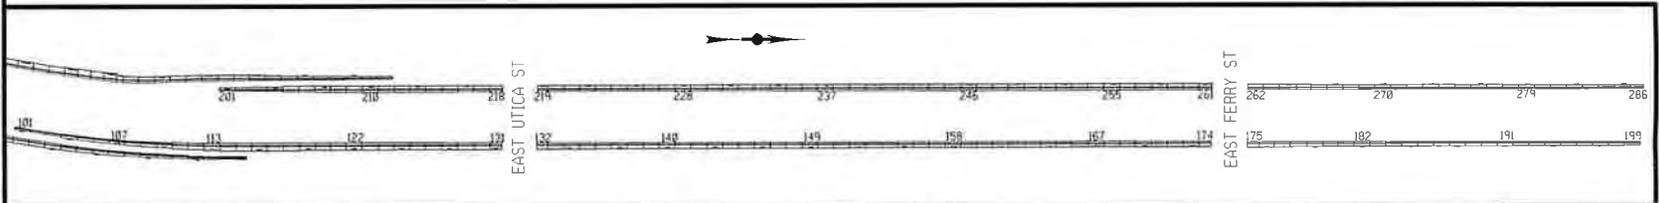


BY: MJE  
 DATE: 5/4/23  
 SCALE: 1" = 10'

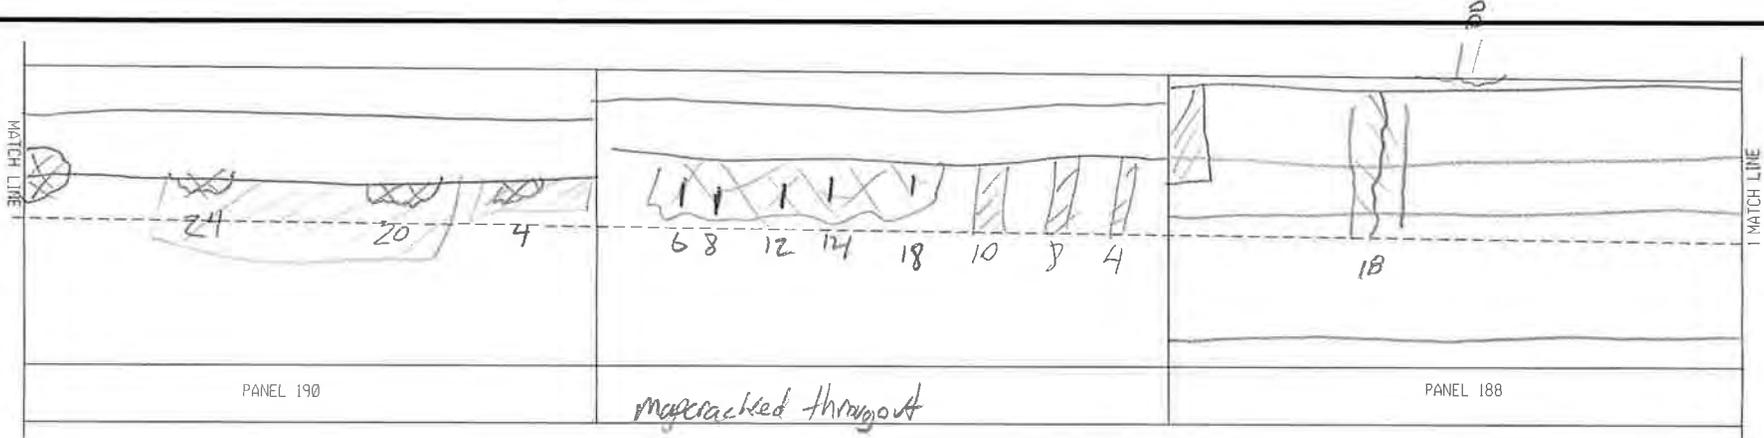

PANEL 190

*mapcracked throughout*


PANEL 188

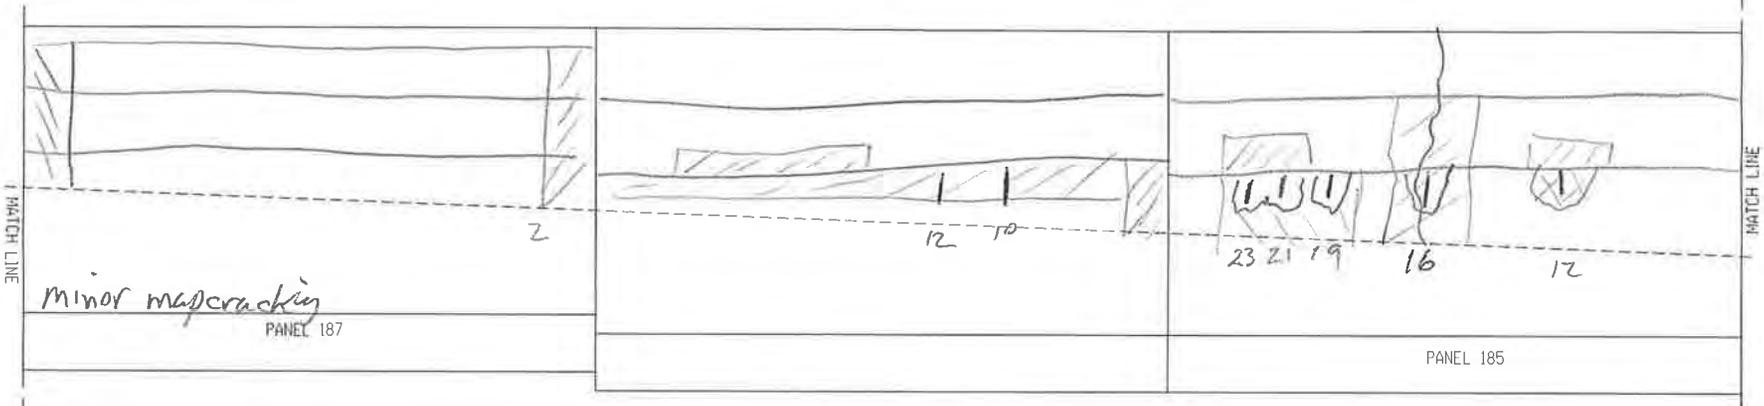

*minor mapcracking*

PANEL 187

PANEL 185

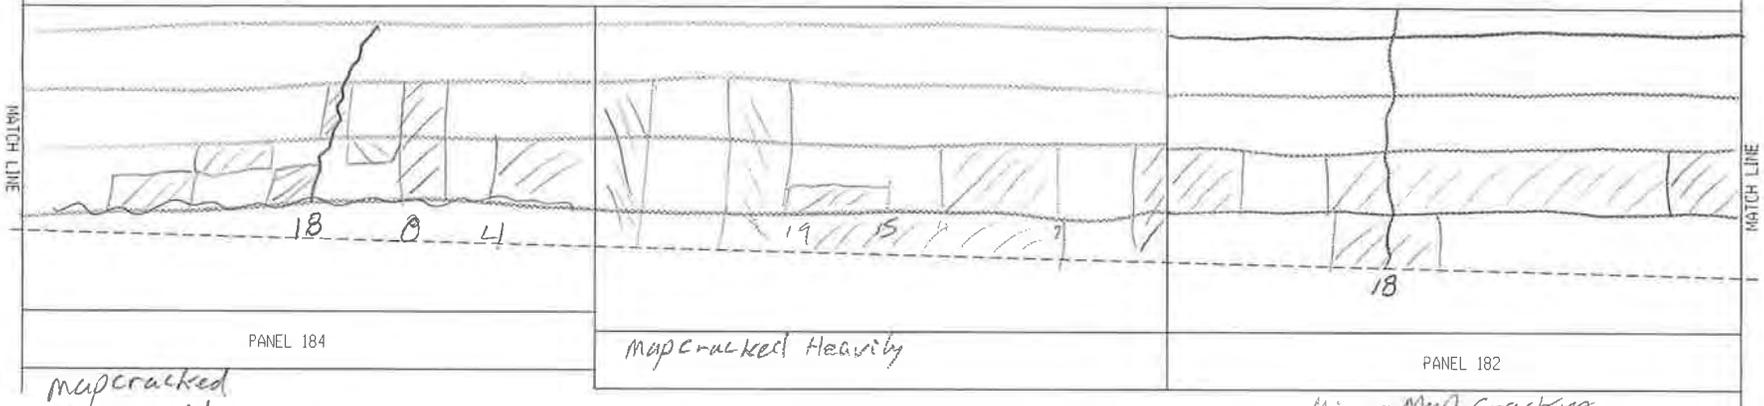

*mapcracked*  
 Ⓚ 60% - delam  
 Ⓚ 20% - delam


PANEL 184

*mapcracked Heavily*

PANEL 182

*Minor Map Cracking*

RW 1 PANELS 190-182

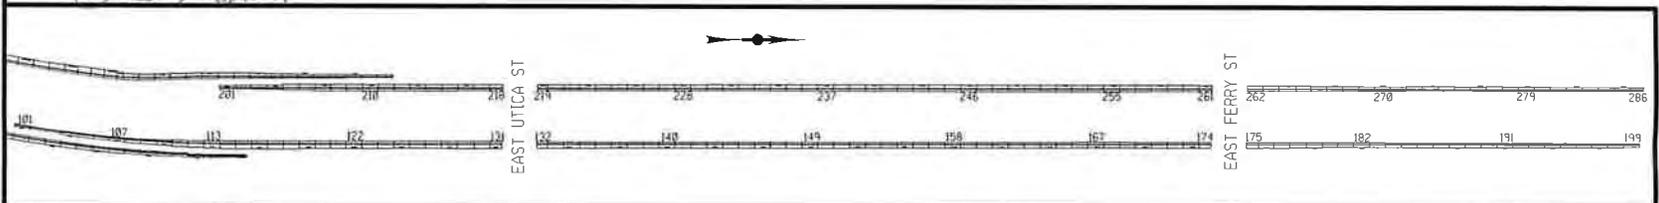

BY: MJE  
 DATE: 5/4/23  
 SCALE: 1" = 10'



## Retaining Wall Coping Inspection 5/30/2023

### Retaining Wall 1

#### Adjacent to wall 3 (ramp):

- Bottom railing tube of steel BR rail is detached in several areas
- Mid-height cracking of coping 60% of length

#### Northampton to E Utica:

- Manhole adjacent to wall lighting standard, safety walk is broken and heaved

#### E Utica to E Ferry:

- Horizontal crack in coping
- map cracking, staining, delam, and broken d clips for full length

#### E Ferry to Wall end:

- Horizontal crack in coping
- Typical intermittent map-cracking
- Impact damage to rail at Inter Park intersection
- Singular spall area under rail post midway between Inter Park and Sidney St

#### General:

- D-clips intermittently broken throughout

PIN 5512.52 Kensington Expressway  
Retaining Wall #1 (RT) along 33EB between Off Ramp to NB Humboldt Parkway and Pedestrian Bridge

## Calculations



300 State Street, Suite 201 • Rochester, NY 14614  
 Phone 585.454.6110 • Fax 585.454.3066  
 www.labellapc.com

PROJECT

Kensington Inspections

PIN

5512.52

CALC. BY

CAM

DATE

5/26/2023

Condition Estimates

- Retaining Wall 1
  - Condition 2 - map cracks, stains, isolated delam, minor cracks
  - Condition 3 - spalls, widespread delam, major cracks
  - Areas with multiple forms of deterioration were measured under only one category. Condition 3 categories were prioritized over condition 2.

| Panel | Minor/Map Crack (sf) | Major Cracks (ft) | Spalls (sf) | Widespread Delam (sf) | Isolated Delam (sf) | Other (staining, efflor., etc.) |
|-------|----------------------|-------------------|-------------|-----------------------|---------------------|---------------------------------|
| 101   | 29.0                 |                   | 1.0         |                       |                     |                                 |
| 102   | 9.0                  |                   |             |                       | 9.0                 |                                 |
| 103   |                      |                   | 15.0        |                       | 30.0                |                                 |
| 104   |                      |                   | 8.5         |                       | 28.5                |                                 |
| 105   | 33.7                 |                   |             |                       | 25.3                |                                 |
| 106   | 162.9                |                   | 2.0         |                       | 9.0                 |                                 |
| 107   | 48.6                 |                   | 1.0         |                       | 15.0                |                                 |
| 108   | 60.8                 | 10.9              | 3.0         |                       |                     |                                 |
| 109   | 52.9                 |                   |             |                       | 29.4                |                                 |
| 110   | 66.2                 |                   | 16.0        |                       |                     |                                 |
| 111   | 36.2                 | 59.3              |             |                       |                     |                                 |
| 112   | 267.8                |                   | 7.8         |                       |                     |                                 |
| 113   | 56.5                 | 12.0              | 1.0         |                       | 68.7                |                                 |
| 114   | 112.5                | 19.5              |             |                       |                     |                                 |
| 115   | 99.4                 | 14.0              | 9.0         |                       |                     | 15.0                            |
| 116   | 22.5                 | 21.0              |             |                       | 3.0                 |                                 |
| 117   | 22.5                 | 19.0              |             |                       | 12.0                |                                 |
| 118   | 22.5                 | 16.0              |             |                       | 11.0                |                                 |
| 119   |                      | 15.0              | 2.0         |                       | 47.5                |                                 |
| 120   |                      |                   | 30.0        | 30.0                  |                     |                                 |
| 121   |                      |                   | 9.0         | 9.0                   |                     |                                 |
| 122   |                      |                   |             | 189.5                 | 7.2                 |                                 |
| 123   |                      | 12.4              |             | 53.0                  |                     |                                 |
| 124   |                      |                   |             | 144.0                 |                     |                                 |
| 125   |                      |                   |             | 63.0                  |                     |                                 |
| 126   |                      |                   | 52.2        | 360.0                 |                     |                                 |
| 127   | 41.4                 | 4.5               | 10.3        | 6.0                   | 4.3                 |                                 |
| 128   |                      |                   |             | 99.0                  |                     |                                 |
| 129   | 112.5                |                   |             |                       | 15.0                |                                 |
| 130   | 24.0                 |                   | 15.0        |                       | 27.0                |                                 |
| 131   |                      |                   | 9.0         | 273.0                 |                     |                                 |
| 132   | 34.5                 |                   | 45.0        | 72.0                  |                     |                                 |
| 133   | 63.0                 |                   |             | 175.0                 |                     |                                 |
| 134   |                      | 17.0              |             |                       |                     |                                 |
| 135   | 18.0                 |                   | 45.0        | 99.0                  |                     |                                 |
| 136   | 22.5                 | 6.0               | 3.0         | 69.0                  |                     |                                 |
| 137   |                      |                   |             | 108.0                 |                     |                                 |
| 138   | 43.5                 | 27.0              |             | 48.0                  |                     |                                 |
| 139   | 40.5                 |                   |             | 141.0                 |                     |                                 |
| 140   | 9.0                  |                   | 29.7        | 141.2                 |                     |                                 |



300 State Street, Suite 201 • Rochester, NY 14614  
 Phone 585.454.6110 • Fax 585.454.3066  
 www.labellapc.com

PROJECT

Kensington Inspections

PIN

5512.52

CALC. BY

CAM

DATE

5/26/2023

Condition Estimates

- Retaining Wall 1

| Panel | Minor/Map Crack (sf) | Major Cracks (ft) | Spalls (sf) | Widespread Delam (sf) | Isolated Delam (sf) | Other (staining, efflor., etc.) |
|-------|----------------------|-------------------|-------------|-----------------------|---------------------|---------------------------------|
| 141   | 45.0                 |                   | 3.0         | 58.8                  |                     |                                 |
| 142   | 44.5                 | 3.0               | 6.0         | 48.1                  |                     |                                 |
| 143   | 58.8                 |                   | 20.3        | 113.3                 |                     |                                 |
| 144   | 48.1                 |                   | 11.0        | 160.3                 |                     |                                 |
| 145   | 30.0                 |                   |             |                       | 72.0                |                                 |
| 146   | 50.8                 | 9.0               | 16.0        | 98.4                  | 18.0                |                                 |
| 147   | 45.0                 |                   |             | 180.0                 |                     |                                 |
| 148   | 18.0                 |                   |             | 144.0                 | 9.0                 |                                 |
| 149   | 36.9                 |                   |             | 144.0                 | 18.0                |                                 |
| 150   | 56.3                 |                   | 2.0         | 148.5                 |                     |                                 |
| 151   | 36.0                 |                   |             | 153.0                 | 18.0                |                                 |
| 152   |                      | 8.9               |             | 175.5                 |                     |                                 |
| 153   |                      |                   |             | 126.0                 |                     |                                 |
| 154   |                      |                   |             | 234.0                 |                     |                                 |
| 155   |                      | 12.5              |             | 126.0                 |                     |                                 |
| 156   |                      |                   |             | 135.0                 |                     |                                 |
| 157   |                      |                   |             | 141.0                 | 19.8                |                                 |
| 158   | 22.5                 | 11.1              | 43.0        | 112.6                 |                     |                                 |
| 159   | 10.5                 |                   |             | 168.0                 | 72.0                |                                 |
| 160   | 22.5                 |                   | 11.3        | 171.0                 |                     |                                 |
| 161   | 90.9                 | 9.0               | 12.0        |                       | 37.5                |                                 |
| 162   |                      |                   |             | 183.0                 | 30.0                |                                 |
| 163   | 78.0                 |                   |             | 120.0                 |                     |                                 |
| 164   | 36.0                 | 7.9               |             | 180.0                 | 27.5                |                                 |
| 165   | 38.6                 |                   |             | 153.0                 |                     |                                 |
| 166   | 20.3                 |                   | 38.0        | 145.8                 |                     |                                 |
| 167   | 23.0                 |                   | 40.0        | 125.0                 |                     |                                 |
| 168   |                      | 4.5               | 4.0         | 150.2                 |                     |                                 |
| 169   | 15.3                 |                   | 40.0        | 178.5                 |                     |                                 |
| 170   |                      | 6.0               | 13.0        | 163.2                 |                     |                                 |
| 171   |                      |                   | 36.0        | 135.0                 | 29.0                |                                 |
| 172   | 16.2                 |                   | 45.0        | 121.5                 |                     |                                 |
| 173   |                      |                   | 33.0        | 45.6                  |                     |                                 |
| 174   | 18.1                 |                   |             | 118.8                 |                     |                                 |
| 175   |                      |                   |             | 74.8                  |                     |                                 |
| 176   | 12.2                 | 9.0               |             | 121.5                 | 6.0                 |                                 |
| 177   | 28.1                 | 3.0               |             | 112.5                 |                     |                                 |
| 178   | 50.3                 |                   |             | 109.5                 |                     |                                 |
| 179   | 22.5                 | 6.6               |             | 99.0                  |                     |                                 |
| 180   | 47.6                 |                   | 18.0        | 97.5                  |                     |                                 |
| 181   | 82.3                 |                   |             | 58.5                  |                     |                                 |
| 182   | 25.9                 | 7.7               |             | 106.5                 |                     |                                 |
| 183   | 54.3                 |                   |             | 136.5                 |                     |                                 |
| 184   | 55.5                 | 6.0               |             | 93.0                  |                     |                                 |
| 185   | 36.6                 | 5.0               | 8.0         | 99.0                  |                     |                                 |



300 State Street, Suite 201 • Rochester, NY 14614  
 Phone 585.454.6110 • Fax 585.454.3066  
 www.labellapc.com

PROJECT

Kensington Inspections

PIN

5512.52

CALC. BY

CAM

DATE

5/26/2023

Condition Estimates

- Retaining Wall 1

| Panel              | Minor/Map Crack (sf) | Major Cracks (ft) | Spalls (sf)   | Widespread Delam (sf) | Isolated Delam (sf) | Other (staining, efflor., etc.) |               |               |
|--------------------|----------------------|-------------------|---------------|-----------------------|---------------------|---------------------------------|---------------|---------------|
| 186                | 31.0                 |                   | 19.5          | 64.8                  |                     |                                 |               |               |
| 187                | 38.1                 |                   | 16.0          |                       | 36.0                |                                 |               |               |
| 188                | 66.9                 | 18.0              | 4.0           |                       | 4.5                 |                                 |               |               |
| 189                | 120.4                |                   | 22.5          |                       | 57.0                |                                 |               |               |
| 190                | 63.5                 |                   | 15.3          |                       | 67.5                |                                 |               |               |
| 191                | 85.8                 |                   | 19.5          |                       | 28.5                |                                 |               |               |
| 192                | 56.2                 |                   | 0.5           |                       | 37.9                |                                 |               |               |
| 193                | 49.3                 |                   | 14.8          |                       | 28.7                |                                 |               |               |
| 194                | 49.1                 |                   |               |                       | 28.6                |                                 |               |               |
| 195                | 45.3                 |                   | 15.5          |                       | 8.9                 |                                 |               |               |
| 196                | 35.5                 |                   | 33.9          |                       | 4.2                 |                                 |               |               |
| 197                | 45.1                 |                   | 35.1          |                       | 4.5                 |                                 |               |               |
| 198                | 44.5                 |                   | 23.4          |                       |                     |                                 |               |               |
| 199                | 33.9                 |                   | 24.6          |                       | 1.3                 |                                 |               |               |
| <b>Total (sf):</b> | <b>3552.87</b>       | <b>190.39</b>     | <b>958.40</b> | <b>7709.85</b>        | <b>1006.18</b>      | <b>15.00</b>                    | <b>COND 2</b> | <b>COND 3</b> |
|                    |                      | (sf)              |               |                       |                     |                                 | 4575          | 8859          |

PIN 5512.52 Kensington Expressway  
Retaining Wall #1 (RT) along 33EB between Off Ramp to NB Humboldt Parkway and Pedestrian Bridge

# Wall Inventory Sheet

## INVENTORY, INSPECTION, AND DATA COLLECTION

|                                       |   | WALL INSPECTION LOCATION<br>INFORMATION & NOTES |
|---------------------------------------|---|---|
| PRIMARY OWNER                         | NYS DOT - New York State Department of Transportation   |   |
| REGION                                | 05-Region 05 - Buffalo  |   |
| COUNTY                                | 3-County 3 - Erie   |   |
| RESIDENCY                             | 534 - Erie North Residency  |   |
| NYS ROUTE                             | Rte. 33   |   |
| REFERENCE MARKER                      | 3353011032  |   |
| LONGITUDE                             | 78.84325  |   |
| LATITUDE                              | 42.90887  |   |
| ADDITIONAL<br>LOCATION<br>DESCRIPTION | Located along the right shoulder of E.B. Kensington from the off-ramp to N.B. Humboldt Parkway and extending beyond Sidney Street supporting N.B. Humboldt Parkway (approximately 2,935 ft. long, 21 ft. maximum exposed height). The east abutments for the E. Utica and E. Ferry Street Overpass Bridges are not considered as part of RW #1. |   |
| TYPE OF SERVICE<br>PROVIDED           | Support/Protect a Roadway   |   |
| WALL TYPE                             | Cantilever - Concrete   |   |
| LEGACY RETAINING<br>WALL TYPE         |   |   |
| WALL FACING TYPE                      | Cast - in -Place Concrete   |   |
| WALL BACKFILL<br>REINFORCEMENT TYPE   | N/A   |   |
| ADDITIONAL WALL<br>DESCRIPTION        |   |   |
| WALL LENGTH                           | 2,935 Ft  |   |
| WALL MAXIMUM<br>HEIGHT                | 21 Ft   |   |
| WALL AREA                             | 66790 SF  |   |
| YEAR BUILT                            | 1970  |   |
| CONTRACT NUMBER                       | C 68-2  |   |
| AADT                                  | 76,347  |   |
| QC REVIEWER                           |   |   |
| QC APPROVED DATE                      |   |   |
| SITE ACCESS NOTES                     | With WZTC in place to close the adjacent shoulder and travel lane, access was performed by walking and extension ladder.  |   |
| INSPECTION<br>FREQUENCY               |   |   |
| LAST INSPECTION<br>STATUS             |   |   |
| INSTRUMENTED                          | N/A   |   |
| MONITORED BY                          | ----  |   |
| INSTRUMENTATION<br>COMMENT            | ----  |   |
| CONSEQUENCE OF<br>FAILURE             | 3-Major   |   |
| WALL POSITION                         | Between Roads   |   |
| GENERAL NOTES                         |   |   |
| RETAINING WALL<br>DATABASE ID         |   |   |
| NUMBER OF ERRORS<br>AND WARNINGS      |   |   |
| USER UPDATE                           |   |   |
| SUBMISSION DATE                       |   |   |
| DATE UPDATE                           |   |   |

**NY33 RETAINING WALL CONDITION EVALUATION 2023**  
**KENSINGTON EXPRESSWAY PROJECT**  
**PIN 5512.52**  
**CITY OF BUFFALO, ERIE COUNTY**  
**RETAINING WALL 2**



Prepared By:

Merton J. Edwards, PE (NYSPE 064981)  
Inspection Team Leader | Sr. Structural Engineer  
Date: 5/30/2023

Reviewed By:

Stephen L. Gauthier, PE (NYSPE 0075775)  
Quality Control Engineer | Sr. Structural Engineer  
Date: 6/16/2023

 **LaBella**  
Powered by partnership.  
300 State Street  
Rochester, New York 14614  
ph: 585-454-6110  
[www.labellapc.com](http://www.labellapc.com)

# PIN 5512.52 – NY33 RETAINING WALL CONDITION EVALUATION 2023 FIELD INSPECTION SUMMARY

STRUCTURE: Retaining Wall #2 (LT) along 33WB between On Ramp from SB Humboldt Parkway and Pedestrian Bridge

STRUCTURE TYPE: Reinforced Concrete Cantilever Wall on Spread Footings  
Year Built: 1970

CURRENT INSPECTION: 05/01/23 – 5/09/23 (LaBella Inspections)

LAST KNOWN INSPECTION: Unknown

CONDITION STATE: FAIR

## RETAINING WALL INSPECTION & DOCUMENTATION:

Inspection of the retaining walls will be in conformance with the NYSDOT Retaining Wall Inventory and Inspection Program Manual, October 2018. Inspection of the following elements will be inspected and documented as appropriate:

### - Inspection:

The following inspection procedure was followed:

- Walls were checked for signs of settlement, rotation, or bulging. Walls faces were checked for vertical alignment using a smart level. The walls being evaluated are vertical with no batter.
- Construction joints between sections of the wall were examined for misalignment, and near the ground line for fill material washing out from between panels or joint.
- Walls were inspected for erosion material in front of the wall, for heaving of material in front of the wall, and for settlement of fill behind the wall
- Examined the wall for deterioration of the material, such as cracking, spalling, and/or corrosion, noting the width, length, depth, and/or orientation of the deterioration. Photographs are provide documenting defects found.
- Wall façades were reviewed for evidence of water seepage, efflorescence, or rust staining.
- Examined the base of walls for evidence of water flow where the water table may be within the retained earth.
- Examined and probed drains for signs of clogging. Examined drainage around ends of wall and note if embankments have been experiencing erosion.
- Examined site grading for any locations that may prohibit proper drainage from behind the wall looking for evidence of ponding above the wall, such as debris accumulation in the lower spots.
- Ascertain why water is not draining properly and note in the inspection.
- Inspected roadway components above wall for signs or joint separation, potholes, and areas of settlement.
- Examined vegetation growth along and above the wall for root infiltration creating undesirable stresses on the wall. Documented any induce cracking, bulging or failure.
- Examined the wall system for vehicular damage, and document the location and degree of damage.

GENERAL OBSERVATIONS:

1. Retaining Wall Panels are generally 30'-0" in length. The wall cap is 9" with horizontal chamfered panels spaced 3'-0" vertically, from the top of the wall. The wall cap is 9" with horizontal chamfered panels spaced 3'-0" vertically, from the top of the wall. There is some variation in panel length due to the location of bridges within the corridor. For specific panel lengths see the DOCUMENTION Section of this report.
2. The lower 6-10 ft of the subject retaining wall was found to be in FAIR-POOR condition with extensive map cracking, dampness, isolated rust staining, concrete spalls and widespread delamination. For specific conditions found and photographs of the of wall panels, see the DOCUMENTION Section of this report.
3. The upper portions of theses wall panels were generally found to be in GOOD-FAIR condition except for a few locations. The top of wall rail coping is map cracked under approximately 50% of the railing posts and has horizontal cracking along the coping at mid height for approximately 40% of the wall length. For specific conditions found, photographs of the of wall panels, and condition calculations see the attached sections of this report.

| General:                    |   |
|-----------------------------|---|
| DEFECT                      | DESCRIPTION   |
| Misalignment                | None noted. No tipping or rotation of the wall panels was observed.   |
| Settlement                  | The safety walk at the intersection with East Ferry St is sunken. The safety walk is heaving at the intersection with East Utica St as well as at a manhole near East Ferry St. |
| Sinkhole (cavity) Formation | None noted.   |

| Concrete Cracks:                                    |  |
|---|--|
| DEFECT  | DESCRIPTION  |
| Insignificant Cracks / (cracks < 0.012 inches wide) | Most wall panels exhibit minor cracking. Cracking is predominately vertical and seems to mirror the rebar spacing underneath.  |
| Map cracks  | Most wall panels are exhibiting some map cracking. The map cracking is most prevalent in the bottom 6 feet of the panels and at the top of walls under railing posts.    |
| Moderate Cracks (0.012 - 0.05 inches wide)          | Many wall panels exhibit moderate cracking. These cracks, where they exist, are predominately vertical, full height cracks located at or near the midpoint of the panel. |
| Wide Cracks (cracks > 0.05 inches wide)             | A few panels exhibit wide cracking. These cracks, where they exist, are predominately vertical, full height cracks located at or near the midpoint of the panel.         |

| Additional Concrete Distress: |   |
|-------------------------------|---|
| DEFECT                        | DESCRIPTION   |
| Spalling / Delamination       | Every wall panel is exhibiting delamination. Delamination amounts vary from approximately 15% to 60% of the exposed wall face. Many wall panels exhibit spalling. Spalling is predominately found at the wall joints to adjacent wall panels and in vertical rebar areas in the lower 6 to 10 feet of wall. |
| Staining                      | Staining, both efflorescence and rust staining, is evident on every wall panel. The amount of staining varies and is best noted in the photo documentation.   |
| Exposed Rebar                 | Rebar is exposed in many of the spalled areas noted during the inspection. Most of the exposed rebar is vertically placed reinforcement. Exposed rebar was noted to have between 15% and 60% section loss.  |

| Notes:   |
|--|
| <p>RW 2 consists of 86 panels numbered west (south) to east (north) from 201 to 286. The retaining wall supports the Humboldt Parkway above State Route 33 (Kensington Expressway).</p> <p>Located along the right shoulder of W.B. Kensington from the on-ramp from S.B. Humboldt Parkway and extending to Riley Street supporting S.B. Humboldt Parkway (Approximately 2,552 ft. long, 20 ft. maximum exposed height). The east abutments for the E. Utica and E. Ferry Street Overpass Bridges are not considered as part of RW #2.</p> |

**INVENTORY, INSPECTION, AND DATA COLLECTION**

| Element                       | Total Qty | Units | Condition State |      |       |        |
|-------------------------------|-----------|-------|-----------------|------|-------|--------|
|                               |           |       | 1               | 2    | 3     | 4      |
|                               |           |       | GOOD            | FAIR | POOR  | SEVERE |
| RW.01 - Entire Wall           | 1         | Each  | 0.71            | 0.08 | 0.21  |        |
| RW.02 - Wall Facing           | 51260     | SF    | 34802           | 4484 | 11974 |        |
| RW.03 - Ground Surface, Front | 2522      | FT    | 2522            |      |       |        |
| RW.04 - Ground Surface, Back  | 2522      | FT    | 2510            |      | 12    |        |
| RW.05 - Weep Holes            | N/A       | Each  | ---             | ---  | ---   | ---    |
| 800 - Scour                   | N/A       | FT    | ---             | ---  | ---   | ---    |

PIN 5512.52 Kensington Expressway


Retaining Wall #2 (LT) along 33WB between On Ramp from SB Humboldt Parkway and Pedestrian Bridge

#### INSPECTION RESULTS/ RECOMMENDATIONS

- **Overall Condition State Recommendation: 2 - FAIR**
  - PROJECT DOCUMENTATION CAN BE FOUND IN THE ATTACHED SECTIONS
-

PIN 5512.52 Kensington Expressway  
Retaining Wall #2 (LT) along 33WB between On Ramp from SB Humboldt Parkway and Pedestrian Bridge
 
## Inspection Photos



# PIN 5512.52 – NY33 RETAINING WALL CONDITION EVALUATION 2023 FIELD INSPECTION SUMMARY

Retaining Wall #2 (LT) along 33WB between On-Ramp from SB Humboldt Parkway and Pedestrian Bridge.



PHOTO 1  
PANEL 286  
Description:  
End of RW2.  
Map cracking and rust staining on rail coping.

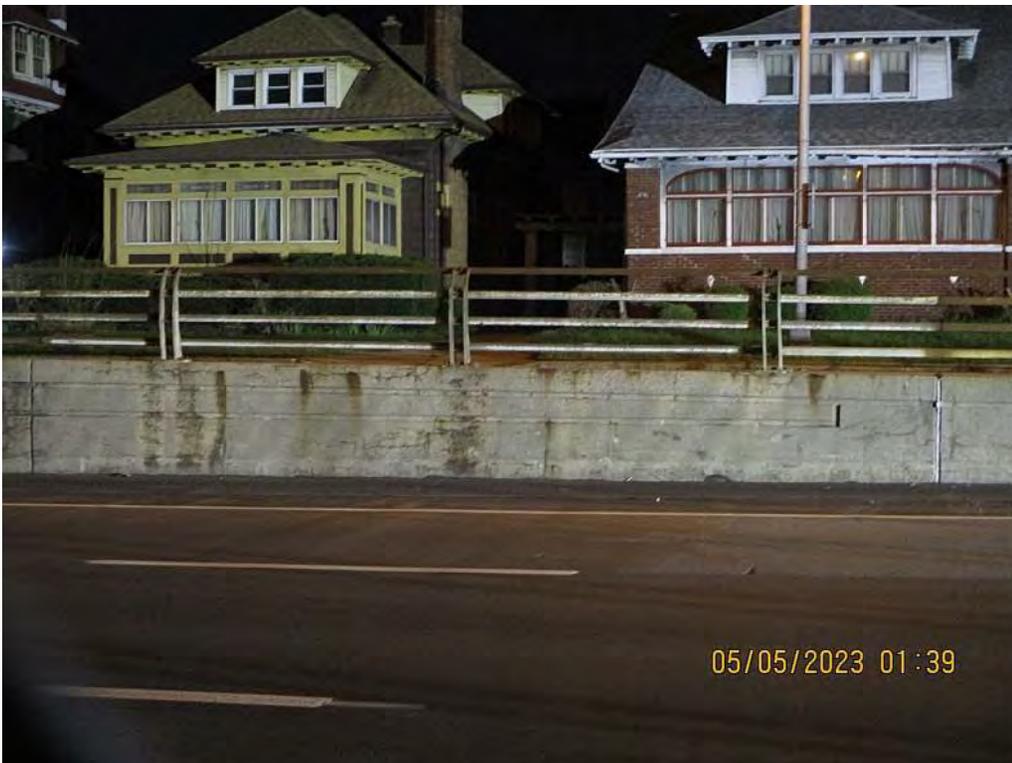


PHOTO 2  
PANEL 283  
Description:  
Map cracking and rust staining on rail coping.  
Map cracking with efflorescence throughout. More concentrated map cracking under rail posts, typical.  
Delamination in top half of panel for 1' from right joint.  
Similar for panels 285-279. Panels 285 and 282-280 have spalls as well.

# PIN 5512.52 – NY33 RETAINING WALL CONDITION EVALUATION 2023 FIELD INSPECTION SUMMARY

Retaining Wall #2 (LT) along 33WB between On-Ramp from SB Humboldt Parkway and Pedestrian Bridge.



PHOTO 3  
PANEL 277

Description:

Cracking along coping and under rail posts, typical.

There are 2 full-height vertical cracks. Panel is 50% delaminated with widespread map cracking.

The bottom panel has many large spalls with exposed rebar, rust staining, and efflorescence.

Panels 278 and 272 are similar.

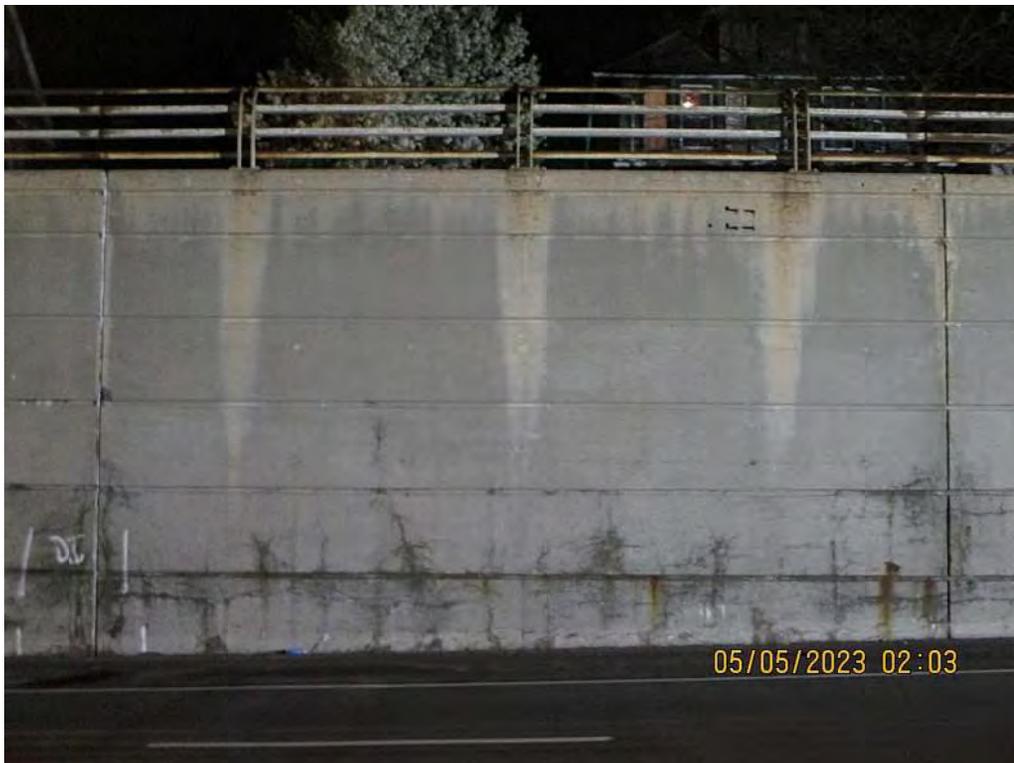


PHOTO 4  
PANEL 266

Description:

Rust staining under rail posts is typical for entire wall.

There is a 9' vertical crack. There is map cracking on the bottom 2 panels. Cracks extend into the third panel near the joints.

The bottom panel is 100% delaminated. The second and third panel are 20%-30% delaminated.

Panels 276, 275, and 267-263 are similar. Panels 273 and 268 are similar with spalls as well.

# PIN 5512.52 – NY33 RETAINING WALL CONDITION EVALUATION 2023 FIELD INSPECTION SUMMARY

Retaining Wall #2 (LT) along 33WB between On-Ramp from SB Humboldt Parkway and Pedestrian Bridge.



PHOTO 5

PANEL 262

Description:

Right of Ferry St bridge west abutment.

Map cracking under rail posts, typical.

Bottom 2 panels are map cracked with rust staining and 50%-60% delamination. Some cracks extend into the third panel which is 20% delaminated.



PHOTO 6

PANEL 261

Description:

Left of Ferry St bridge west abutment.

Map cracking under rail posts, typical.

Map cracking on bottom 2.5 panels. Bottom 2 panels are 100% delaminated, and there are isolated areas of delamination on the third panel.

# PIN 5512.52 – NY33 RETAINING WALL CONDITION EVALUATION 2023 FIELD INSPECTION SUMMARY

Retaining Wall #2 (LT) along 33WB between On-Ramp from SB Humboldt Parkway and Pedestrian Bridge.



PHOTO 7  
PANEL 258  
Description:  
Map cracking bottom 2 panels with 40% delamination. Map cracks extend into third panel near left joint.  
Several large spalls on bottom panel with exposed rebar.

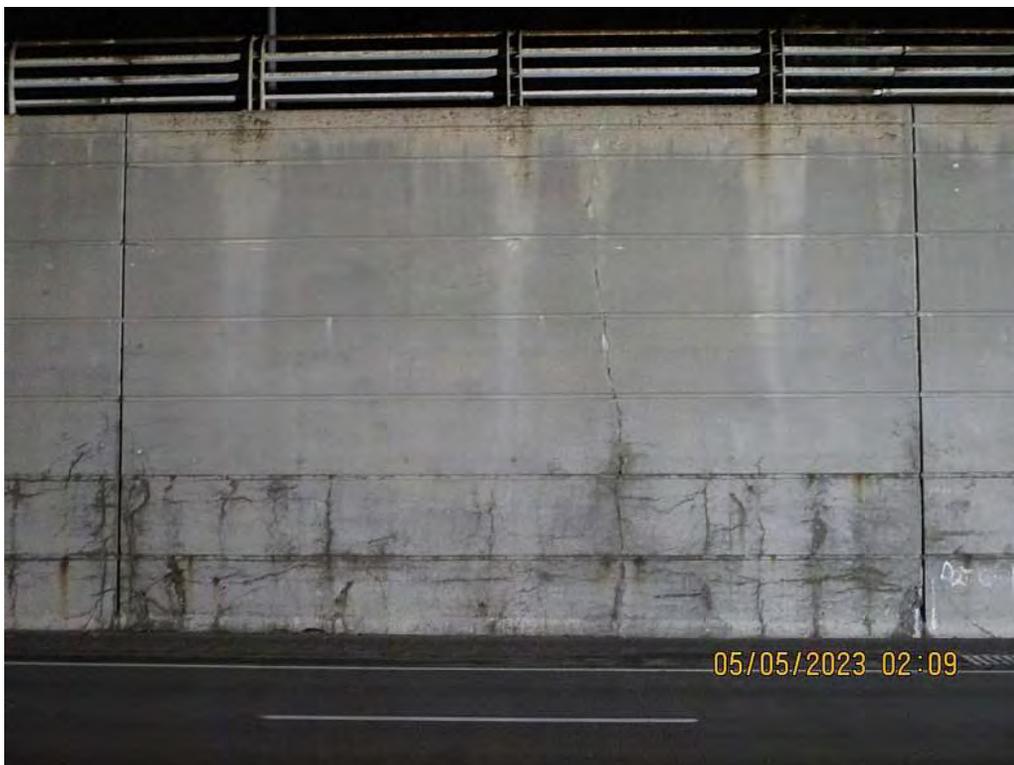


PHOTO 8  
PANEL 256  
Description:  
Map cracking under rail posts, typical.  
Full-height vertical crack with efflorescence near midspan of the panel.  
Map cracking bottom 2 panels with a few rust stains. Bottom panel 100% delaminated, second panel 75% delaminated.  
A few small spalls, most significant is in lower right corner of panel.

# PIN 5512.52 – NY33 RETAINING WALL CONDITION EVALUATION 2023 FIELD INSPECTION SUMMARY

Retaining Wall #2 (LT) along 33WB between On-Ramp from SB Humboldt Parkway and Pedestrian Bridge.



PHOTO 9  
PANEL 248  
Description:  
Map cracking under rail posts, typical.  
Map cracked bottom 2 panels with 90%-100% delamination. Less severe map cracking on third panel with delamination for 6' from right joint.  
Scattered map cracking on top 4 panels.  
There is a spill on the second panel.

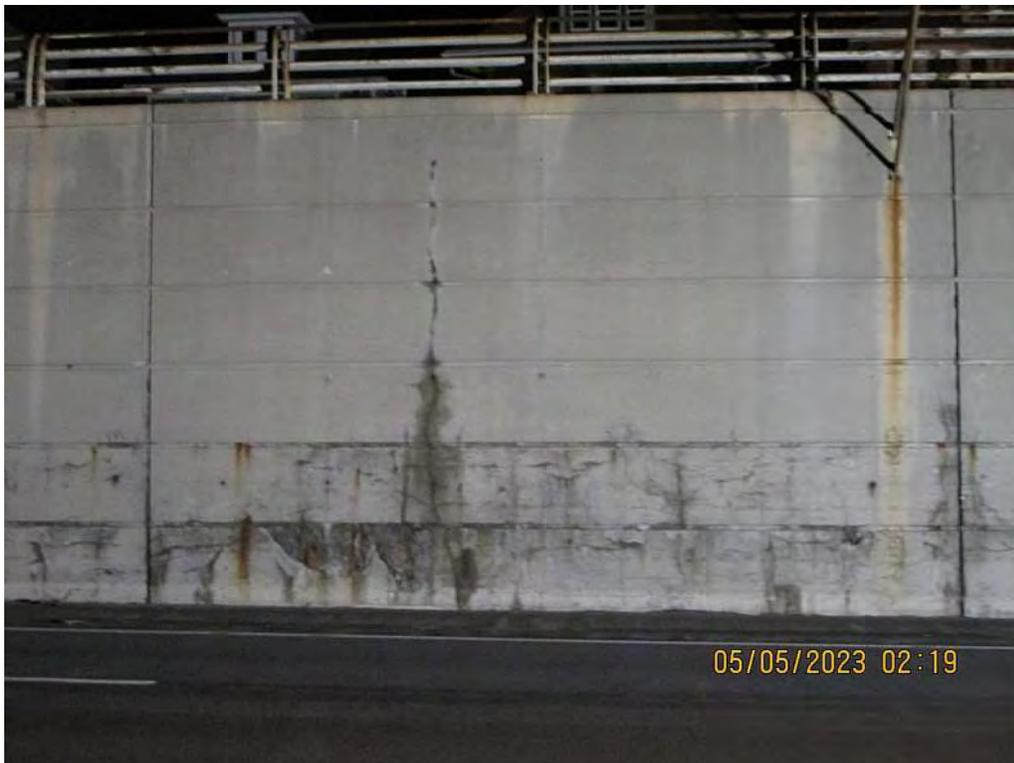


PHOTO 10  
PANEL 238  
Description:  
Full-height vertical crack with efflorescence.  
Bottom 2 panels map cracked with 90%-100% delamination. Some delamination extends into third panel as well.  
Large spill with exposed rebar on bottom panel.  
Rust staining under luminaire and a few isolated stains throughout.

# PIN 5512.52 – NY33 RETAINING WALL CONDITION EVALUATION 2023 FIELD INSPECTION SUMMARY

Retaining Wall #2 (LT) along 33WB between On-Ramp from SB Humboldt Parkway and Pedestrian Bridge.



PHOTO 11  
PANEL 237  
Description:  
Map cracked on bottom 3 panels with areas of rust staining and efflorescence.  
Delaminated 100% on bottom panel, 70% on second panel, and 15% on third panel.  
There is a spall on the right side of the bottom panel.  
Similar to panels 236 and 234.

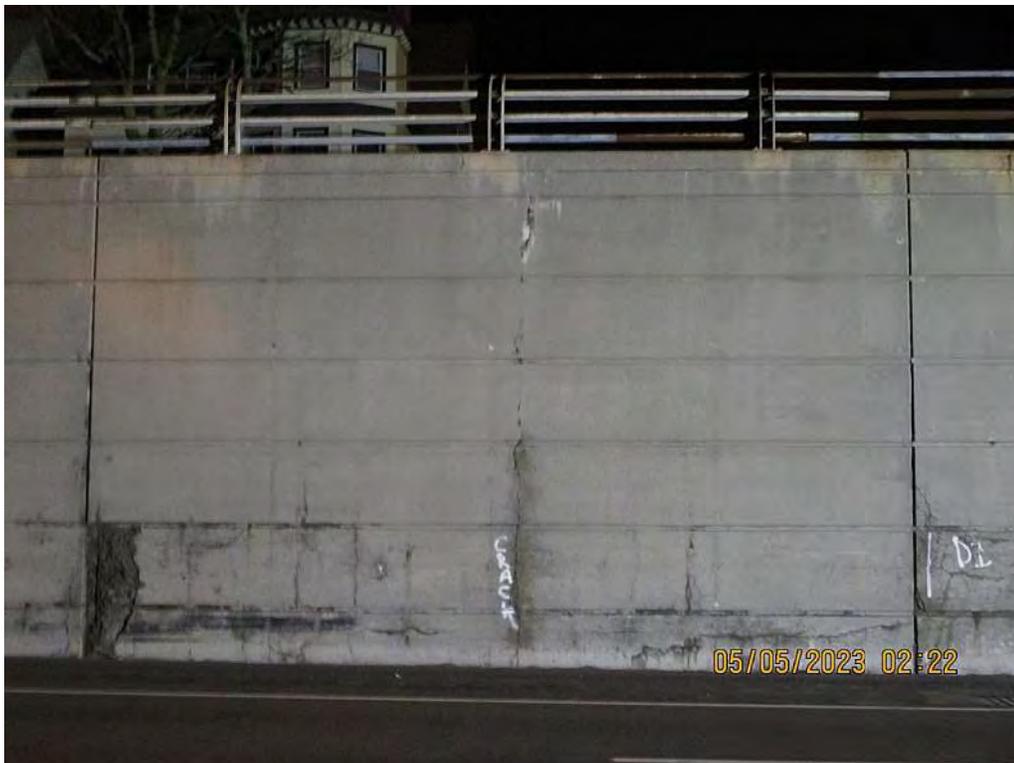


PHOTO 12  
PANEL 232  
Description:  
Map cracked on bottom 2 panels with some vertical cracks extending into the third panel. There are isolated rust stains.  
Full height vertical crack at midspan of the panel with efflorescence.  
Large spall on bottom two panels at left joint. The spall has exposed rebar.  
Similar to panels 235, 223, and 220.

# PIN 5512.52 – NY33 RETAINING WALL CONDITION EVALUATION 2023 FIELD INSPECTION SUMMARY

Retaining Wall #2 (LT) along 33WB between On-Ramp from SB Humboldt Parkway and Pedestrian Bridge.



PHOTO 13  
PANEL 222

Description:

Map cracking under rail posts, typical.

There is map cracking on the bottom 2 panels. The bottom 2 are 100% delaminated and the third panel is 70% delaminated.

There are several spalls. The large spall near the right joint has exposed rebar with 30% loss.

There is a 13' crack near the left joint that is about to spall.

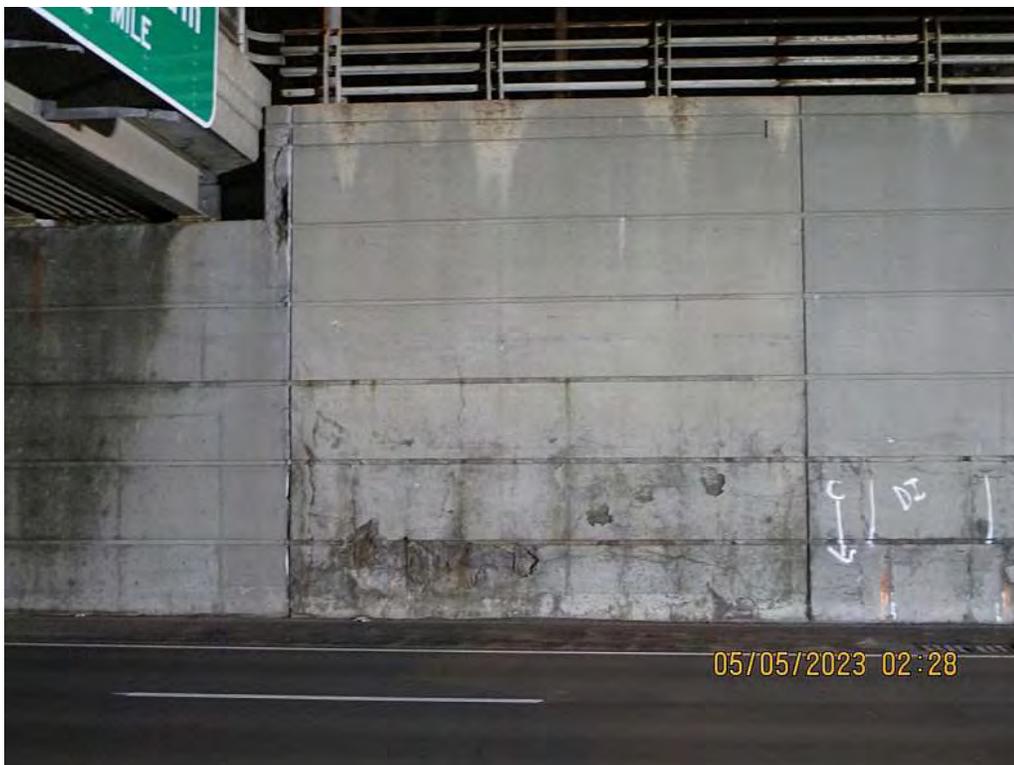


PHOTO 14  
PANEL 219

Description:

Right of East Utica St bridge west abutment.

Map cracking under rail posts, typical.

The bottom 2.5 panels are map cracked and 100% delaminated. Rust staining is present in the chamfer between panels.

There is a 10' vertical crack near the left joint.

There are several spalls including one large spall in the bottom panel with exposed rebar.

# PIN 5512.52 – NY33 RETAINING WALL CONDITION EVALUATION 2023 FIELD INSPECTION SUMMARY

Retaining Wall #2 (LT) along 33WB between On-Ramp from SB Humboldt Parkway and Pedestrian Bridge.



PHOTO 15  
PANEL 218  
Description:  
Left of East Utica St bridge west abutment.  
There is map cracking on the bottom 2 panels throughout and bottom 3 panels near the joints. Panels 1 and 2 are 100% delaminated and panel 3 is 90% delaminated.  
Scattered areas of rust staining are present.  
There are a few spalls on the bottom panel.



PHOTO 16  
PANEL 213  
Description:  
Map cracking on top panel and coping.  
Map cracking on bottom 2 panels. Map cracking continues up to the fourth panel near the left joint. Bottom 3 panels are 100% delaminated.  
There is a 15' crack near the left joint.

# PIN 5512.52 – NY33 RETAINING WALL CONDITION EVALUATION 2023 FIELD INSPECTION SUMMARY

Retaining Wall #2 (LT) along 33WB between On-Ramp from SB Humboldt Parkway and Pedestrian Bridge.



PHOTO 17  
PANEL 208

Description:

Map cracking under rail posts, typical.

Map cracking on bottom 2 panels. Sparser map cracking throughout.

Bottom 2 panels are 100% delaminated with rust staining and efflorescence. Panel 3 is 60% delaminated.

There is a full height crack at midspan of the panel with rust staining and efflorescence.

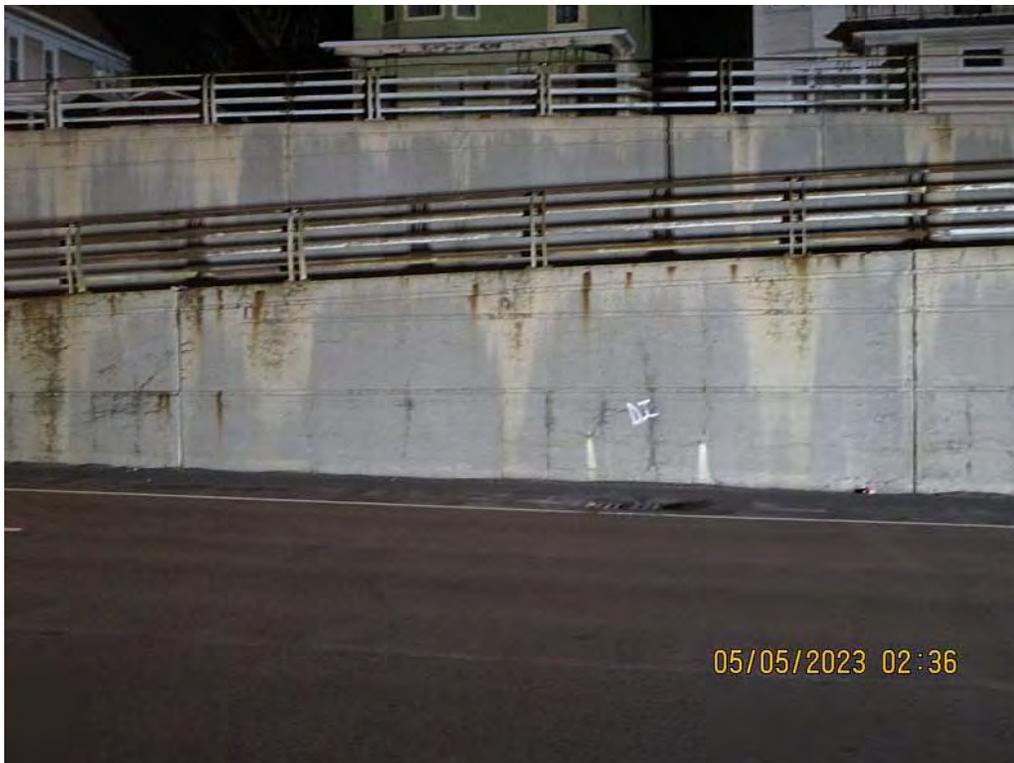


PHOTO 18  
PANEL 204

Description:

Map cracking under rail posts, typical.

Rust staining on top panel and coping.

Scattered map cracking throughout with 50% delamination.

Similar to panel 205.

# PIN 5512.52 – NY33 RETAINING WALL CONDITION EVALUATION 2023 FIELD INSPECTION SUMMARY

Retaining Wall #2 (LT) along 33WB between On-Ramp from SB Humboldt Parkway and Pedestrian Bridge.



PHOTO 19

PANEL 201

Description:

Start of RW2.

Map cracking and rust staining under rail posts.

Sparses map cracking throughout.

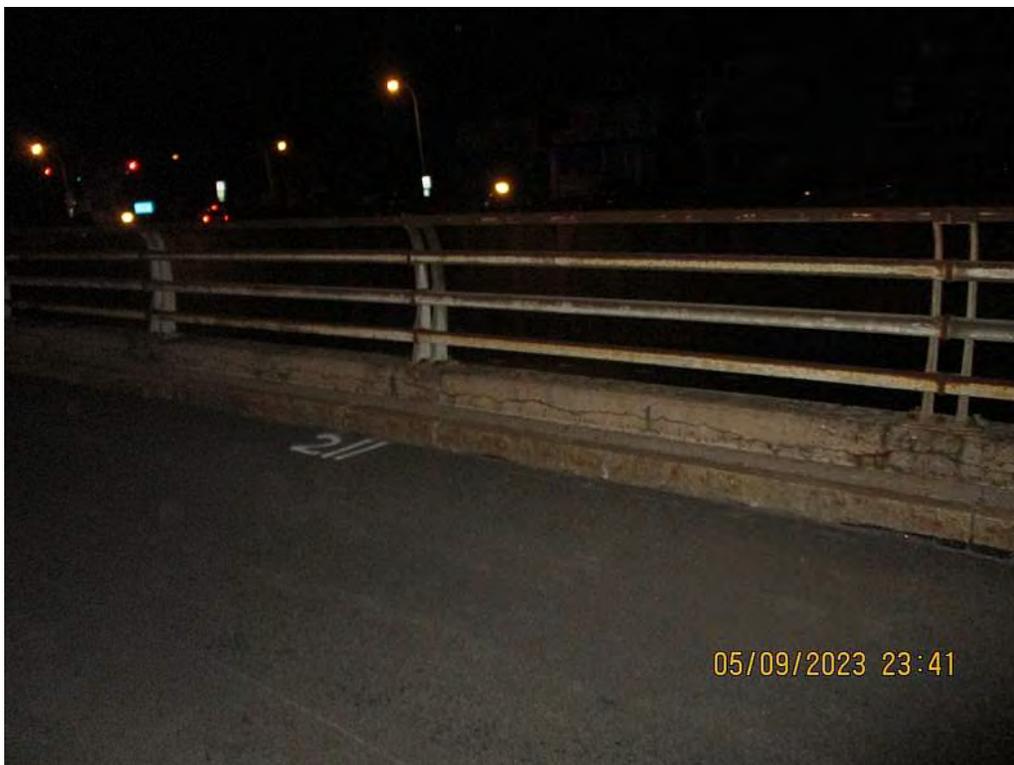


PHOTO 20

PANEL 211 (Back Side of Coping)

Description:

There is a large longitudinal crack on the coping along with general map cracking.

# PIN 5512.52 – NY33 RETAINING WALL CONDITION EVALUATION 2023 FIELD INSPECTION SUMMARY

Retaining Wall #2 (LT) along 33WB between On-Ramp from SB Humboldt Parkway and Pedestrian Bridge.



PHOTO 21  
PANEL 206 (Back Side of Coping)

Description:

Back of coping is spalled with exposed longitudinal rebar and rust staining.

Top of coping is map cracked.

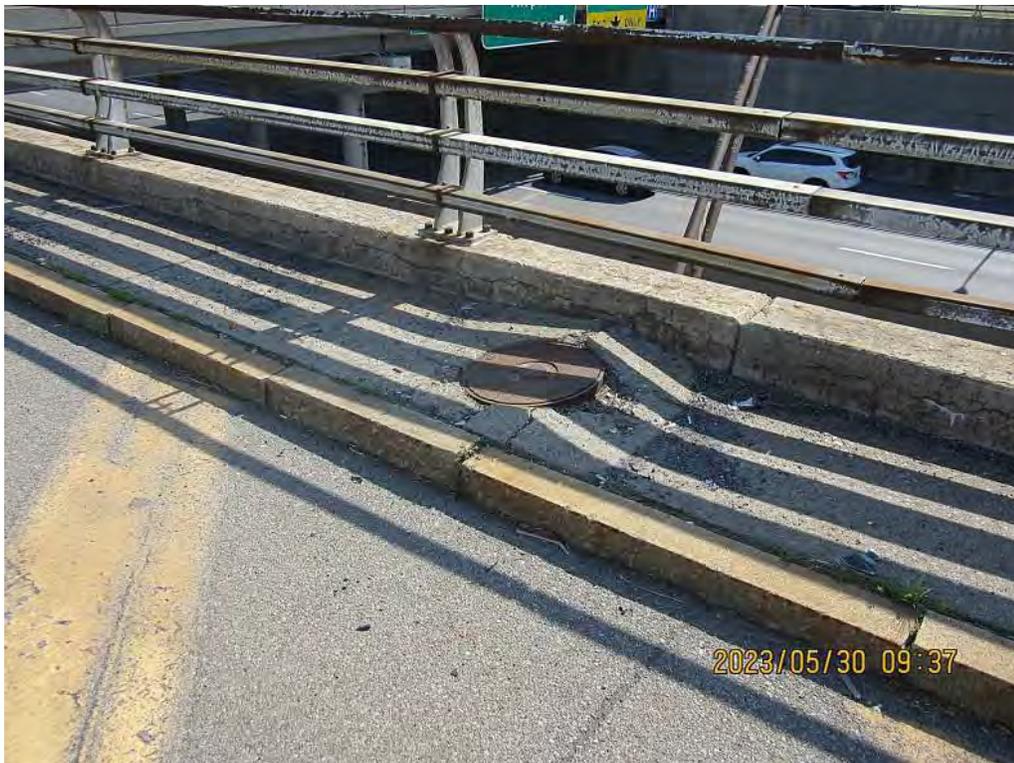


PHOTO 22  
PANEL 260 (Back Side of Coping)

Description:

There is a large longitudinal crack on the coping.

The manhole and safety walk adjacent to the wall are heaving.

Heaving is also present at the intersection with E Ferry St. and sinking is present on the other side of the intersection.

PIN 5512.52 Kensington Expressway  
Retaining Wall #2 (LT) along 33WB between On Ramp from SB Humboldt Parkway and Pedestrian Bridge

# Field Sheets

FILE NAME = \\06cashlab\06\02150716.01\_kensington Preliminary Design\Drawings\Highway\Plan\set2\0551252\_cph\_pin\_1ftA.dgn  
 DATE = 2/7/2023  
 TIME = 12:56:26 PM

PROJECT MANAGER

CHECK



DRAFTING

CHECK

DESIGN

JOB MANAGER

DESIGN SUPERVISOR

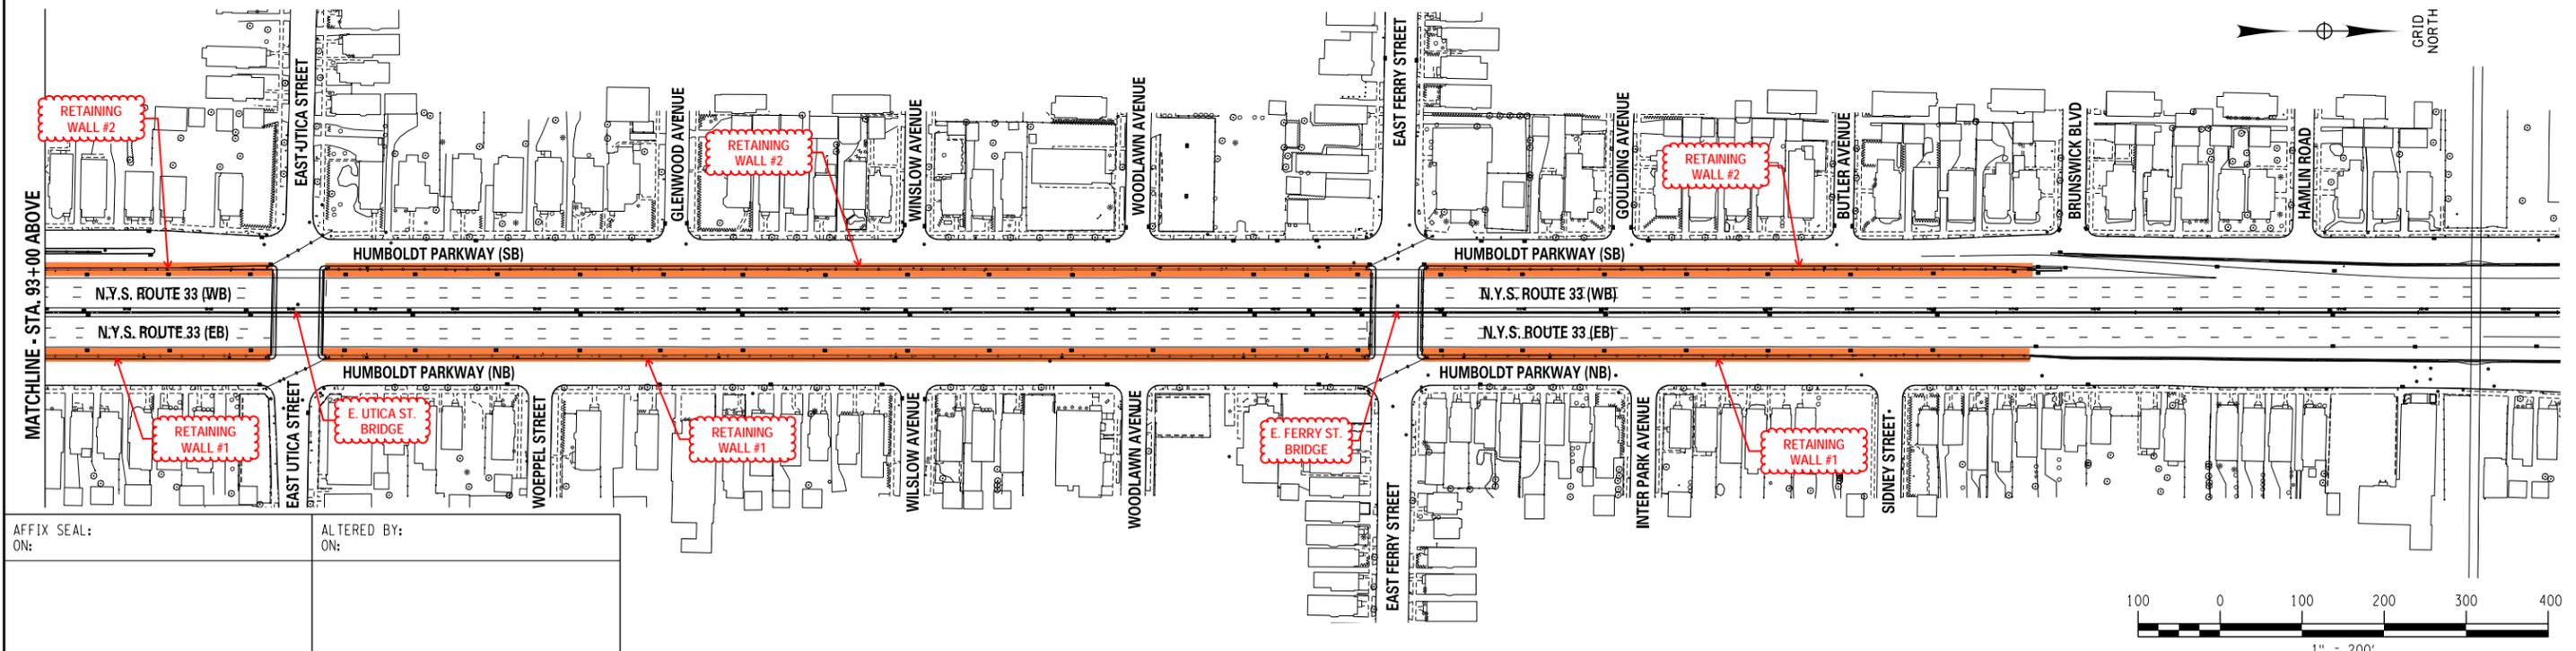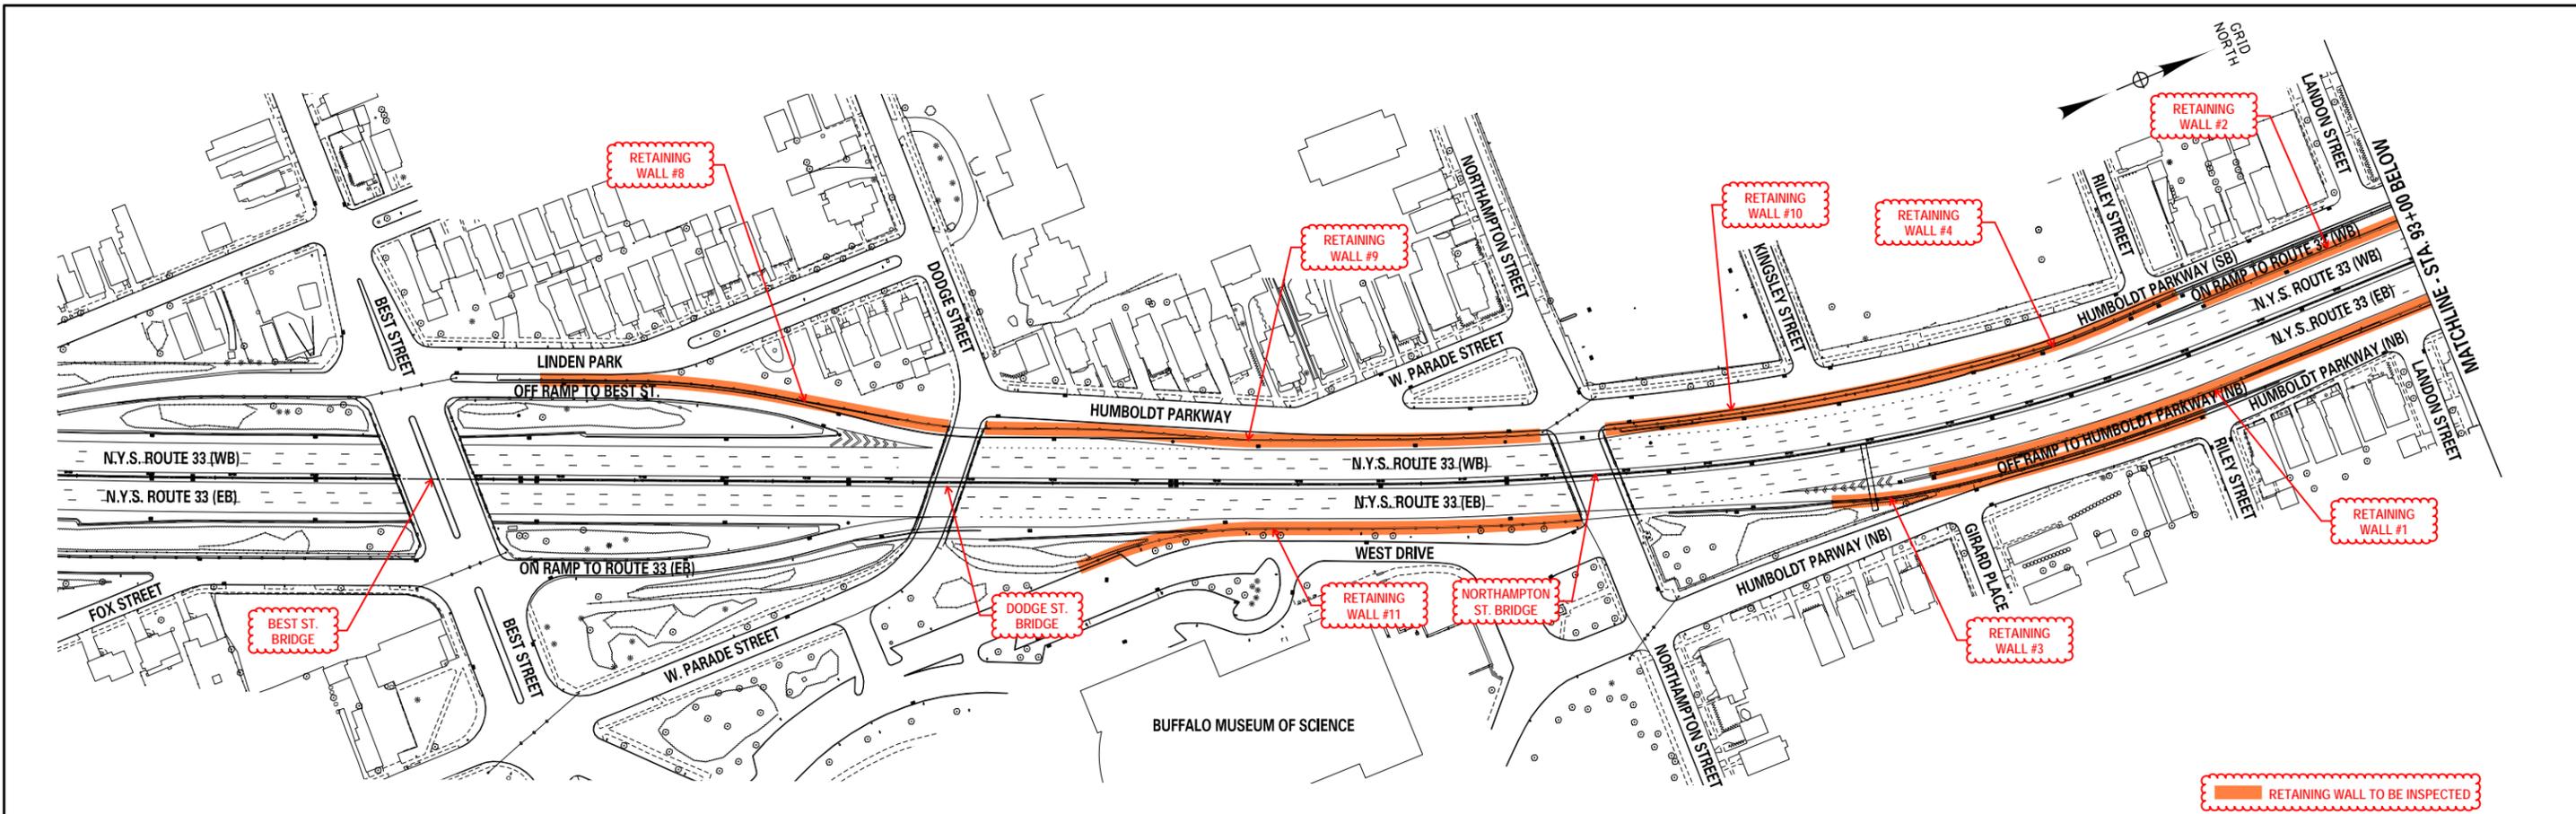

|                    |                    |
|--------------------|--------------------|
| AFFIX SEAL:<br>ON: | ALTERED BY:<br>ON: |
|--------------------|--------------------|


|  |                       |             |         |          |   |                 |
|--|-----------------------|-------------|---------|----------|---|-----------------|
| AS-BUILT REVISIONS<br>DESCRIPTION OF ALTERATIONS:  | STATE ROUTE 33        | PIN 5512.52 | BRIDGES | CULVERTS | ALL DIMENSIONS IN FT UNLESS OTHERWISE NOTED | CONTRACT NUMBER |
|  | KENSINGTON EXPRESSWAY |             |         |          |   |                 |
|  | CITY OF BUFFALO       |             |         |          |   |                 |
|  | COUNTY: ERIE          |             |         |          |   |                 |
| IT IS A VIOLATION OF LAW FOR ANY PERSON, UNLESS THEY ARE ACTING UNDER THE DIRECTION OF A LICENSED PROFESSIONAL ENGINEER, ARCHITECT, LANDSCAPE ARCHITECT, OR LAND SURVEYOR, TO ALTER AN ITEM IN ANY WAY. IF AN ITEM BEARING THE STAMP OF A LICENSED PROFESSIONAL IS ALTERED, THE ALTERING ENGINEER, ARCHITECT, LANDSCAPE ARCHITECT, OR LAND SURVEYOR SHALL STAMP THE DOCUMENT AND INCLUDE THE NOTATION "ALTERED BY" FOLLOWED BY THEIR SIGNATURE, THE DATE OF SUCH ALTERATION, AND A SPECIFIC DESCRIPTION OF THE ALTERATION. |                       |             |         |          |   |                 |
| <b>KENSINGTON EXPRESSWAY</b><br><b>RETAINING WALL LOCATION PLAN</b>  |                       |             |         |          | DRAWING NO. 1<br>SHEET NO.                  |                 |
|  |                       |             |         |          |   |                 |




Map cracked, worst under rail posts

- Map crack + rust stain throughout
- 50% delam.

- Map cracking + rust stain throughout
- 50% delam.

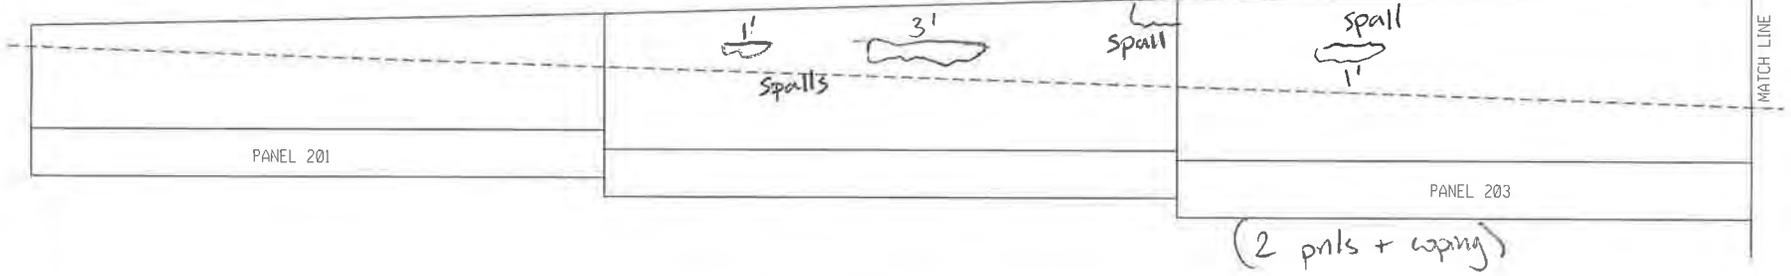

full height crack w/ efflor.

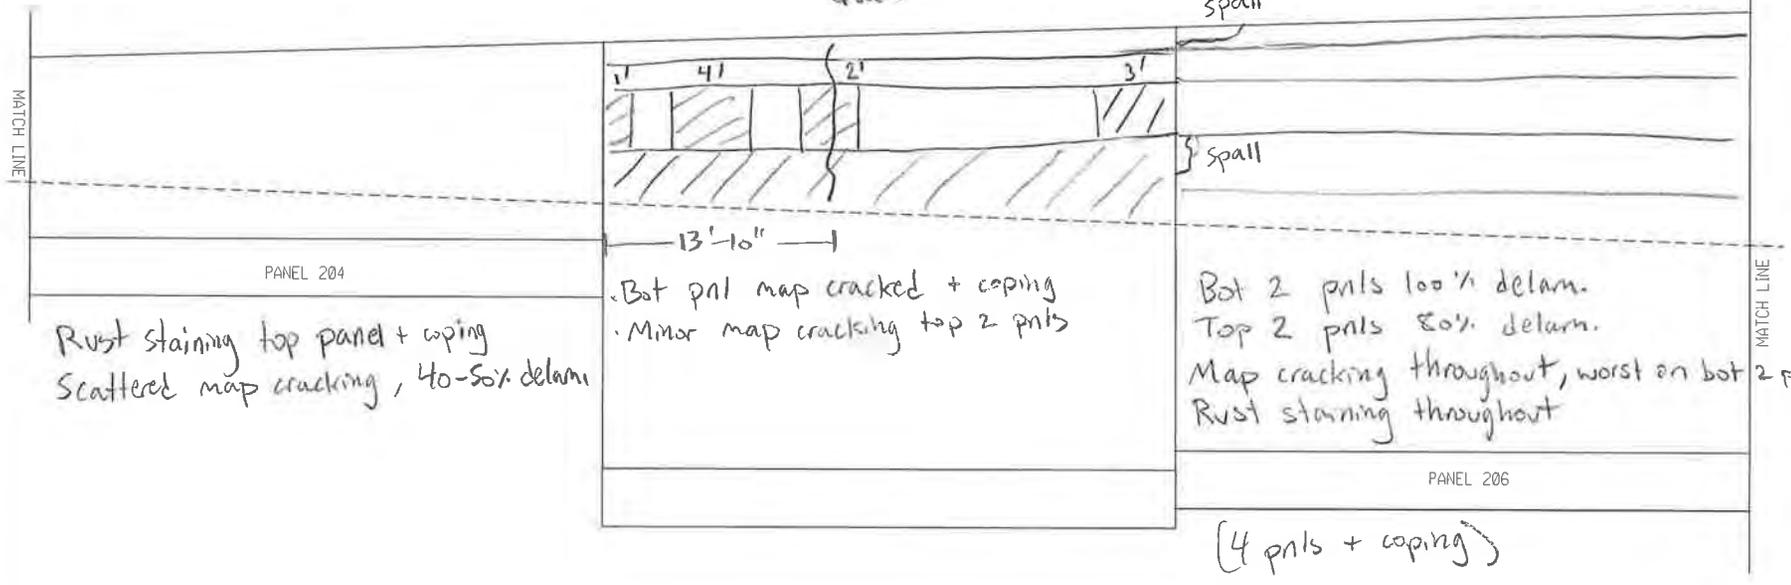



Rust staining top panel + coping  
Scattered map cracking, 40-50% delam

- Bot pnl map cracked + coping
- Minor map cracking top 2 pnls



- Bot 2 pnls 100% delam.
- Top 2 pnls 80% delam.
- Map cracking throughout, worst on bot 2 pnls
- Rust staining throughout

delaminated



RW 2 PANELS 201-206

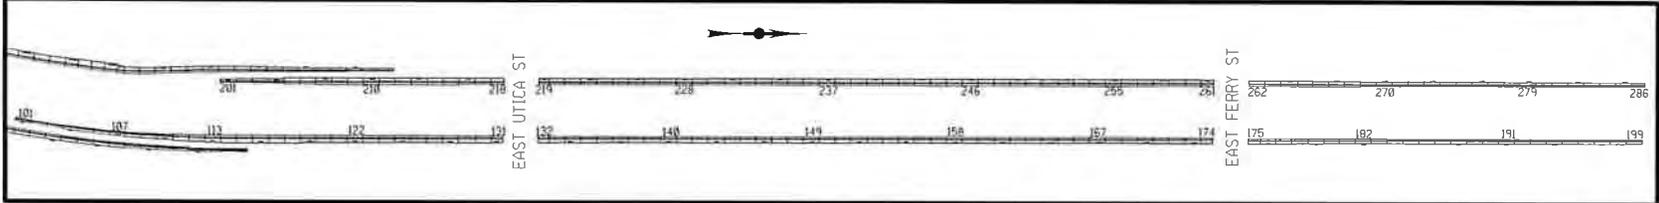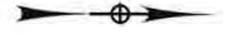

BY: RIM  
DATE: 5/8/23  
SCALE: 1" = 10'

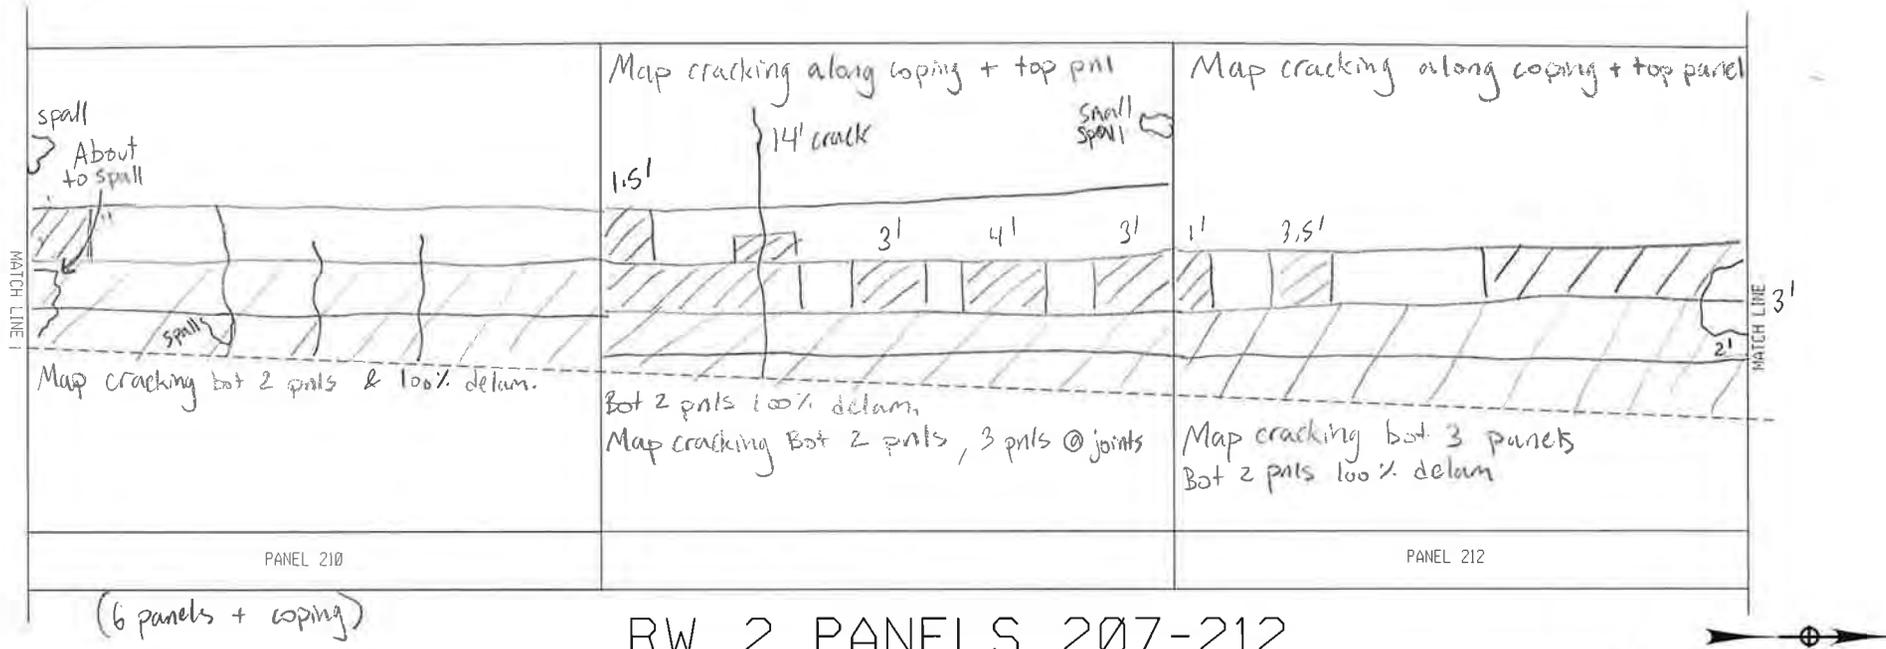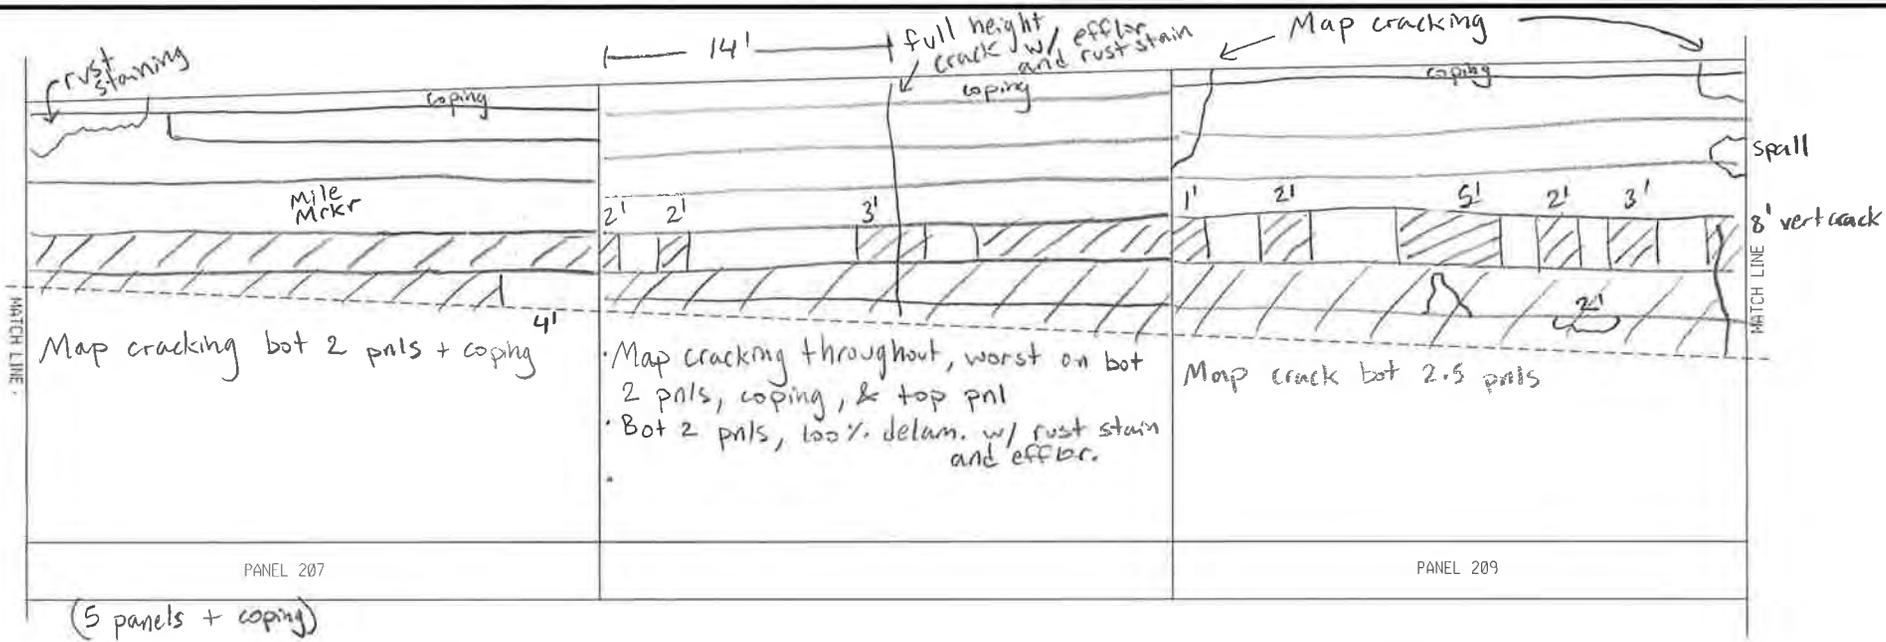

RW 2 PANELS 207-212

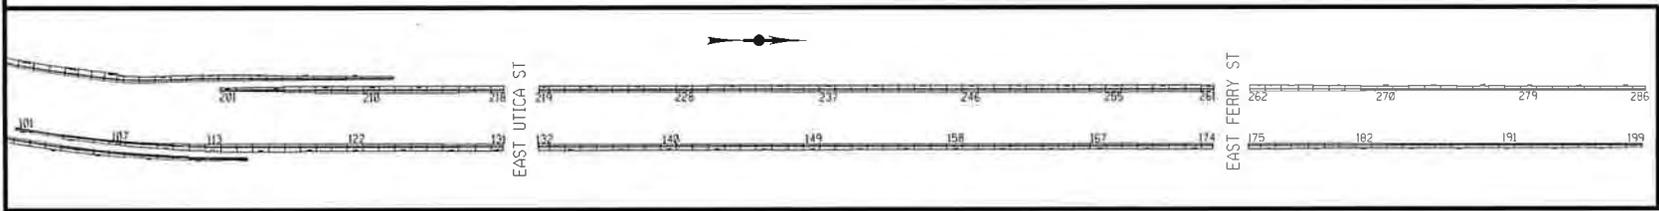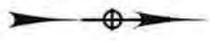


BY: RIM

DATE: 5/8/23

SCALE: 1' = 10'

Cracking along coping

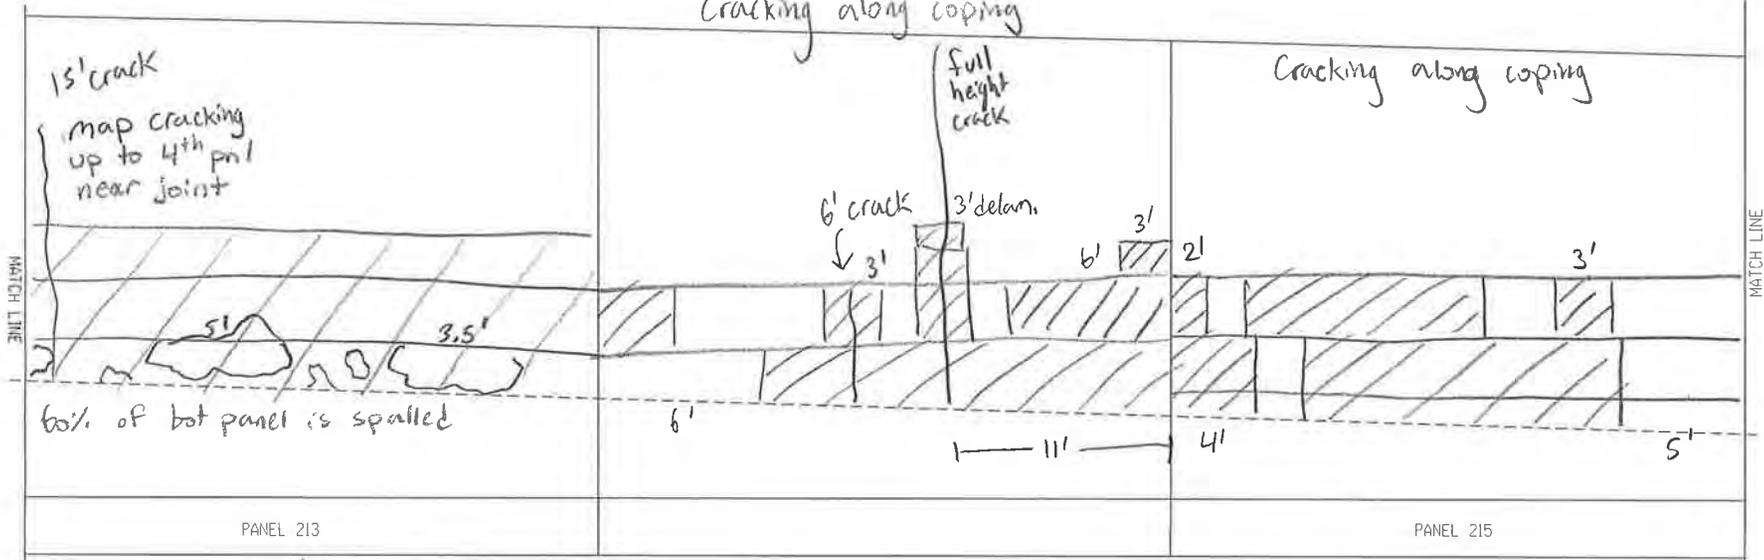


Bot 3 panels 100% delam.  
Bot 2 panels map cracking

Map cracking bot panel, bot 3 near joint

Map cracking bot 2 panels



Map crack Cracking along coping

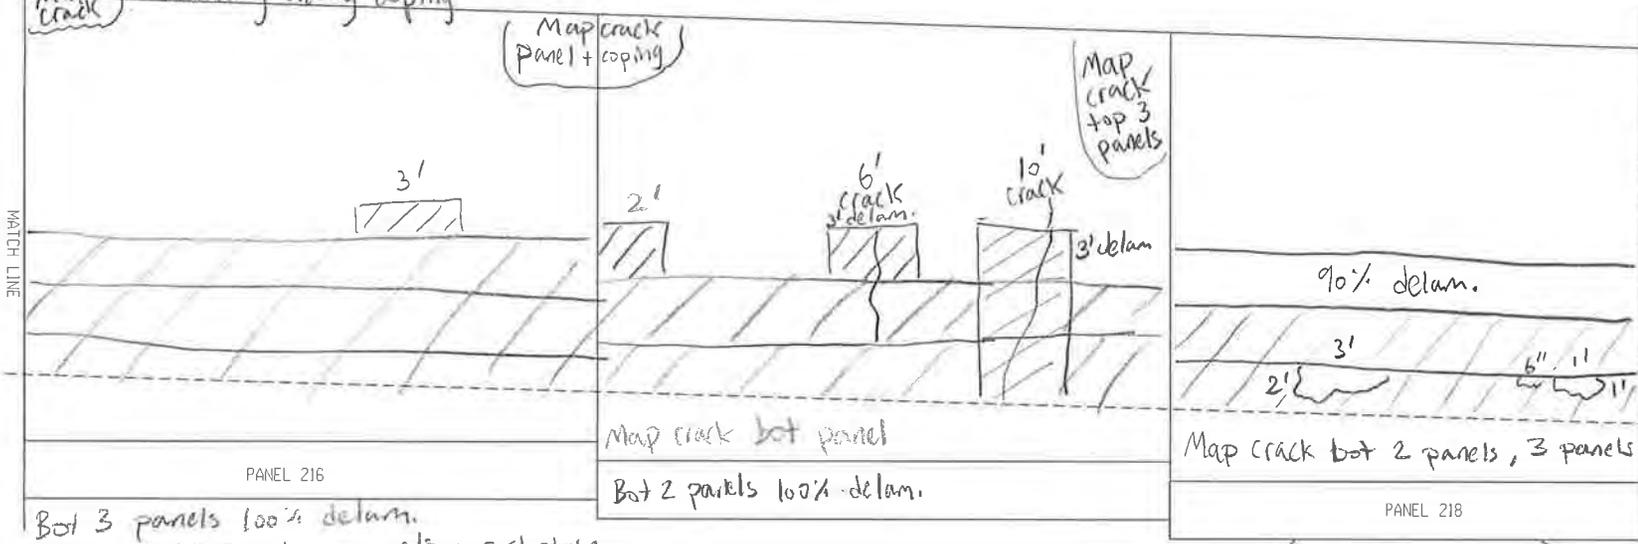

Bot 3 panels 100% delam.  
Map cracking Bot 2 panels + rust stain

Bot 2 panels 100% delam.


RW 2 PANELS 213-218 (7 panels + coping)

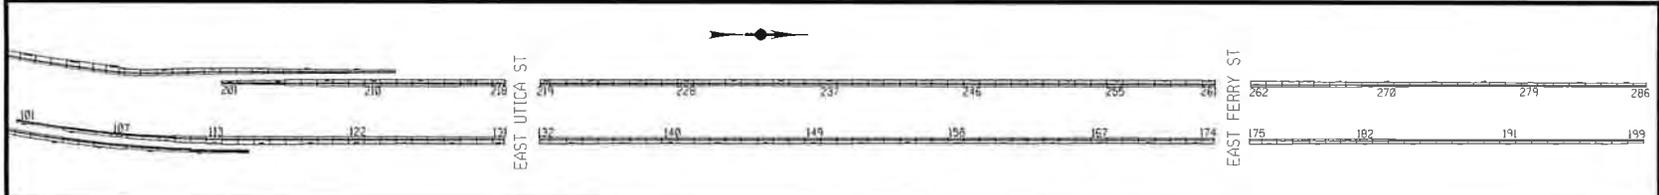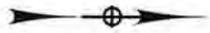

BY: RIM  
DATE: 5/8/23  
SCALE: 1" = 10'


Map crack bot 2 pnls

10' crack

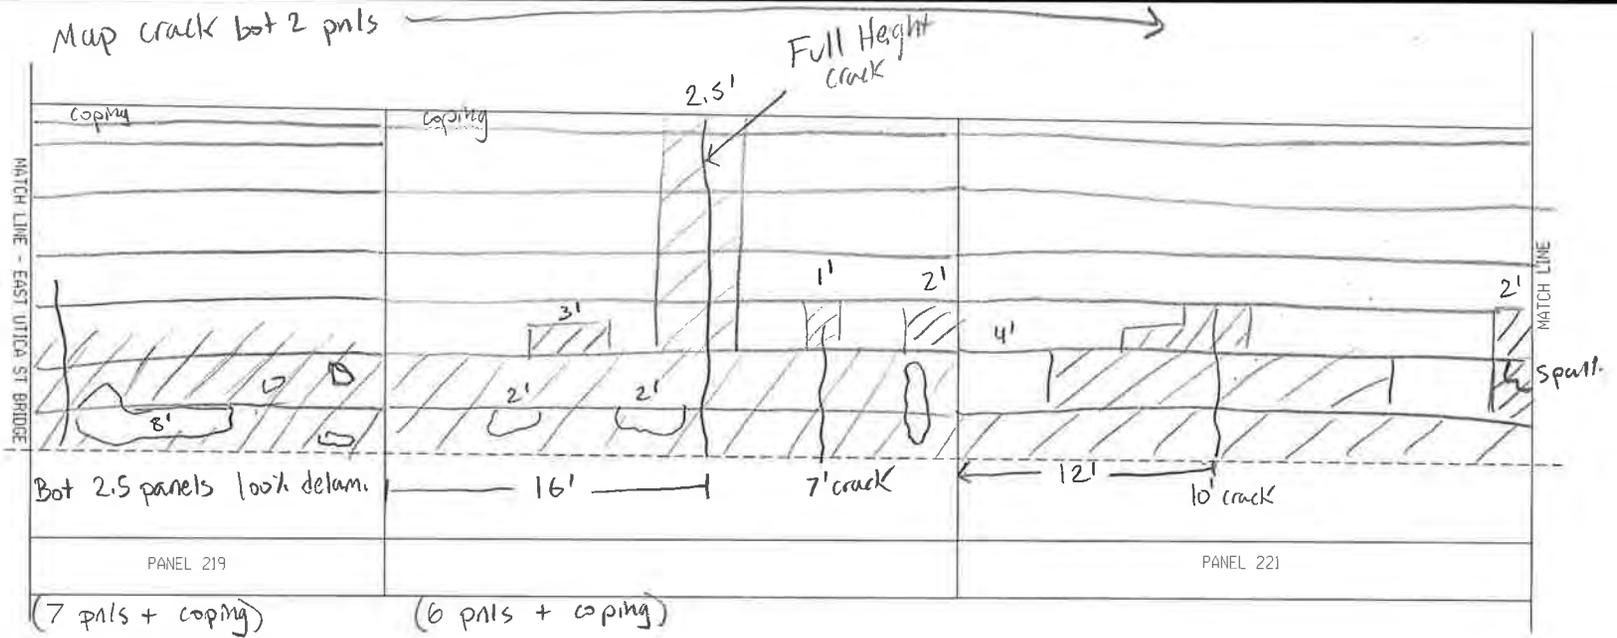


Map cracking bot 2 pnls

Map cracking bot 3 pnls + coping

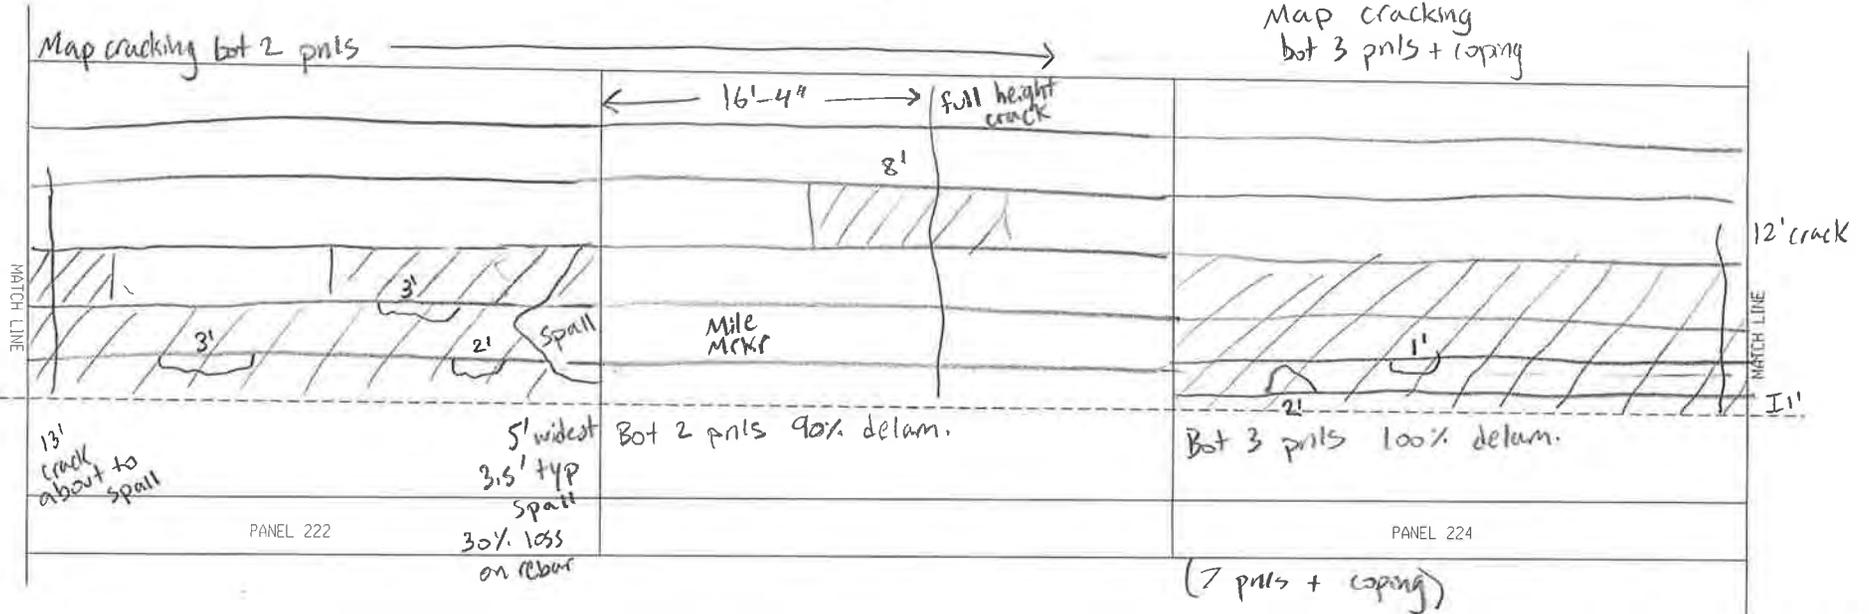


RW 2 PANELS 219-224


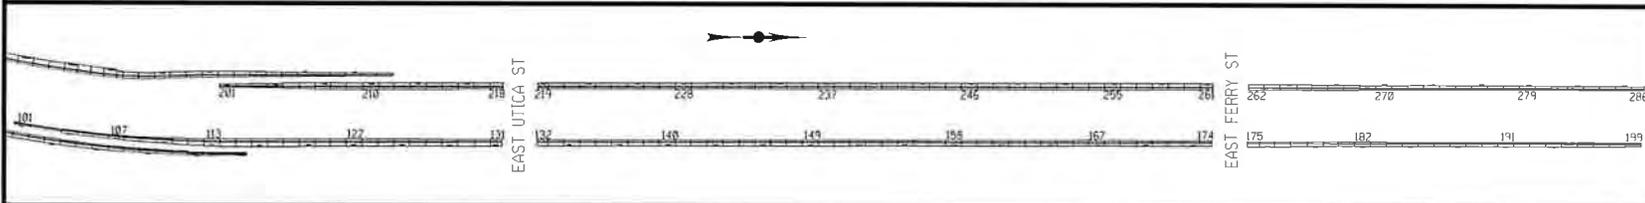


BY: RIM  
 DATE: 5/8/23  
 SCALE: 1" = 10'



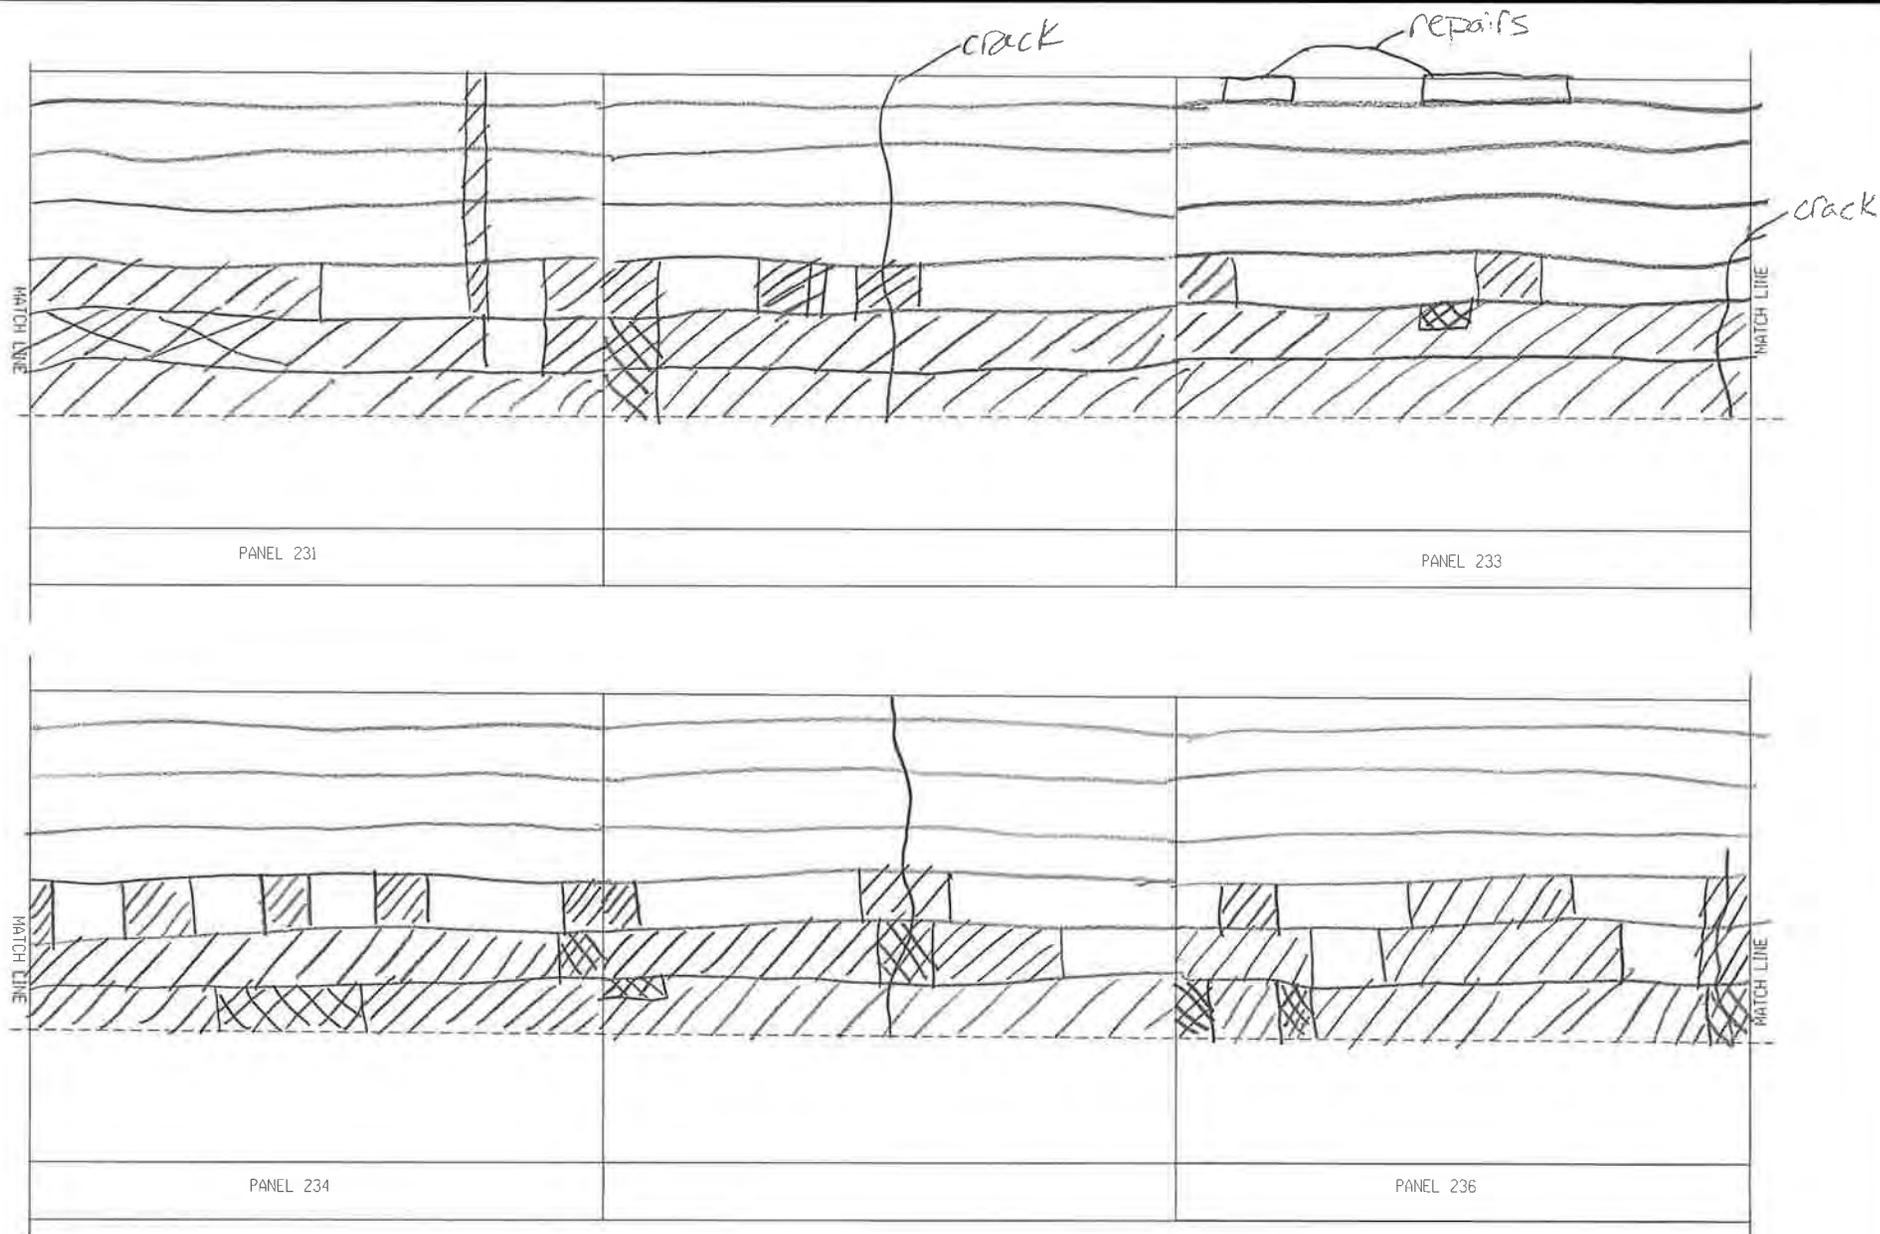


RW 2 PANELS 231-236

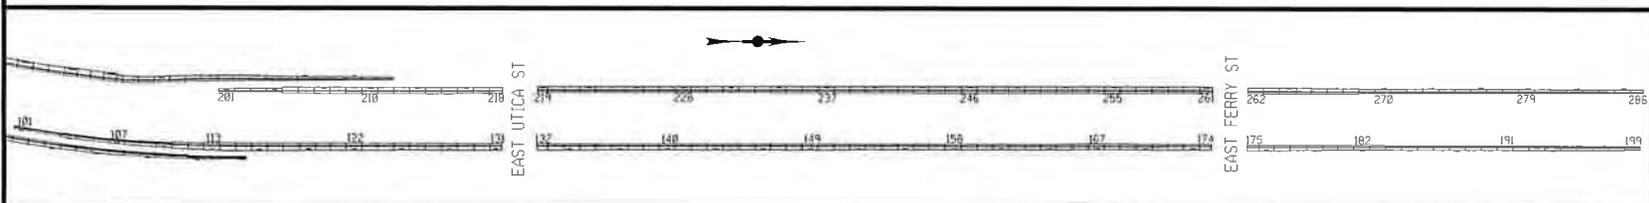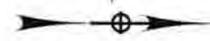

BY: \_\_\_\_\_

DATE: 5/8/23

SCALE: 1" = 10'

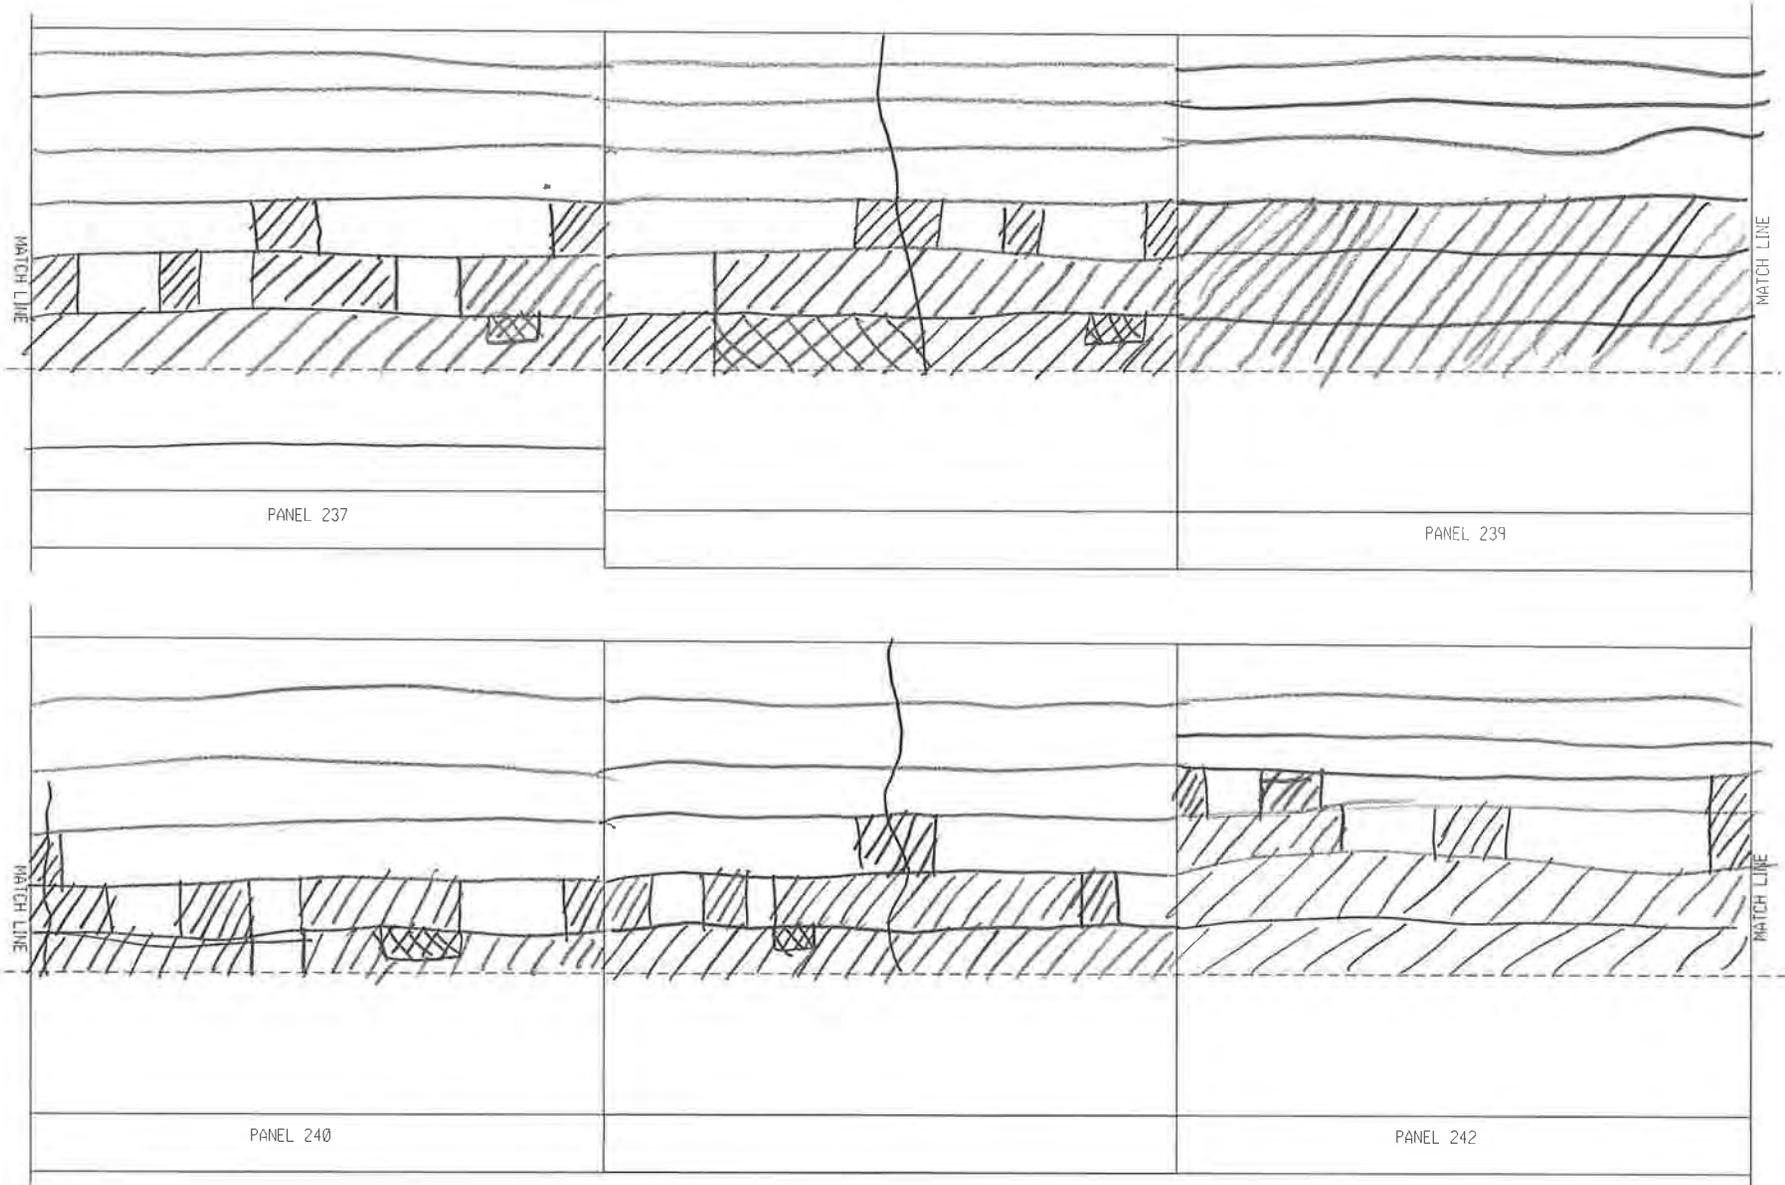


PANEL 237

PANEL 239

PANEL 240

PANEL 242

RW 2 PANELS 237-242

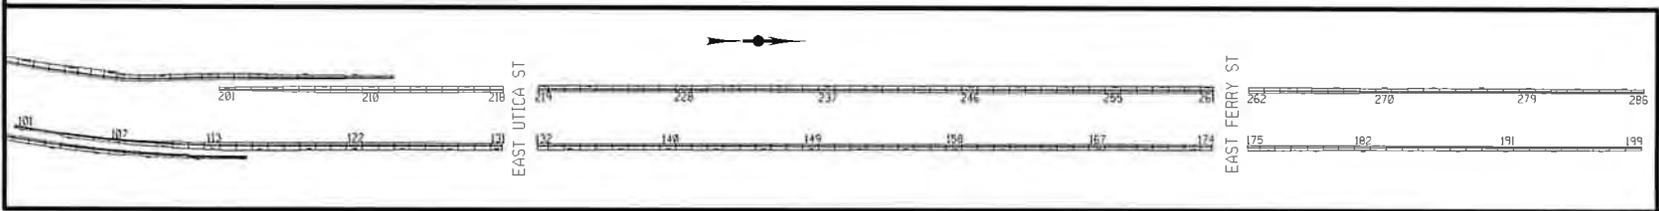



BY: \_\_\_\_\_  
 DATE: 5/8/23  
 SCALE: 1" = 10'







DL - Delam  
 SP - Spall


MC - Map Crack  
 ER - Exposed Rebar

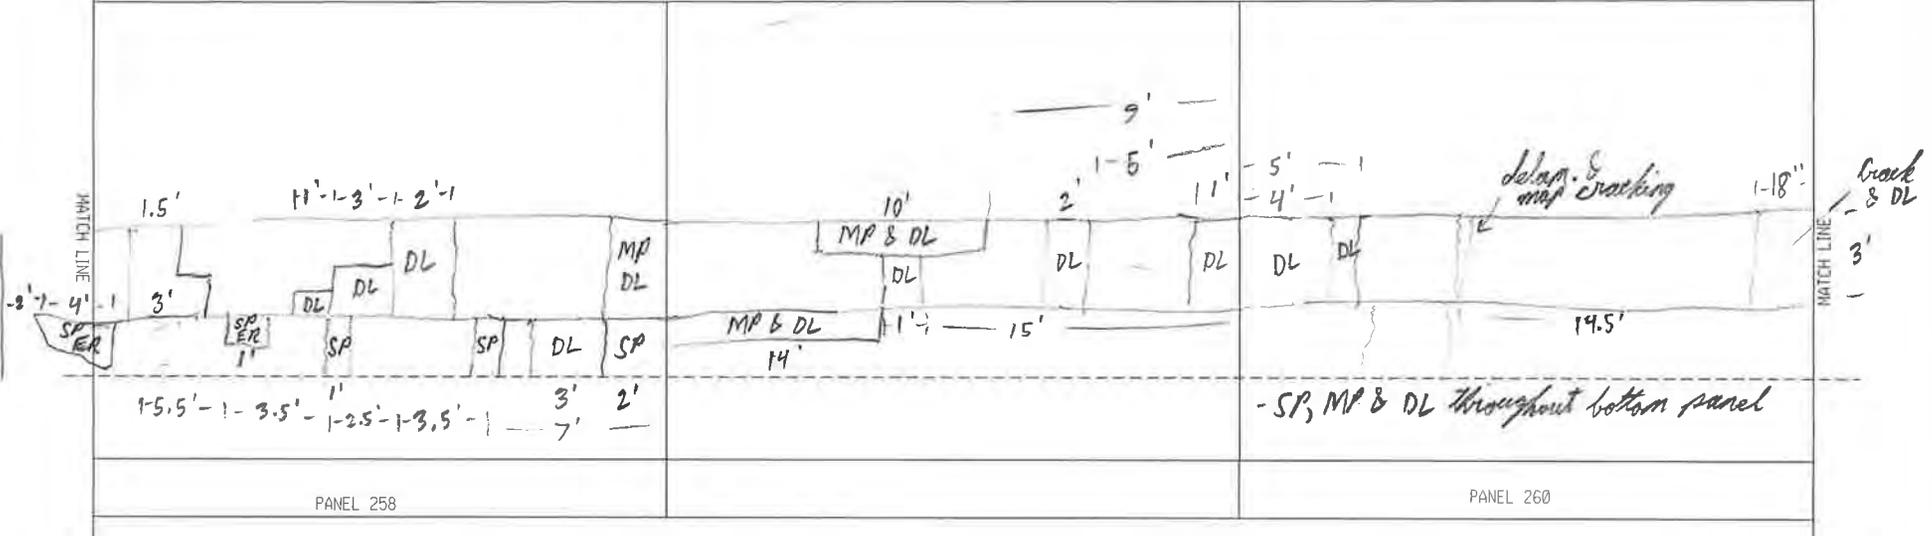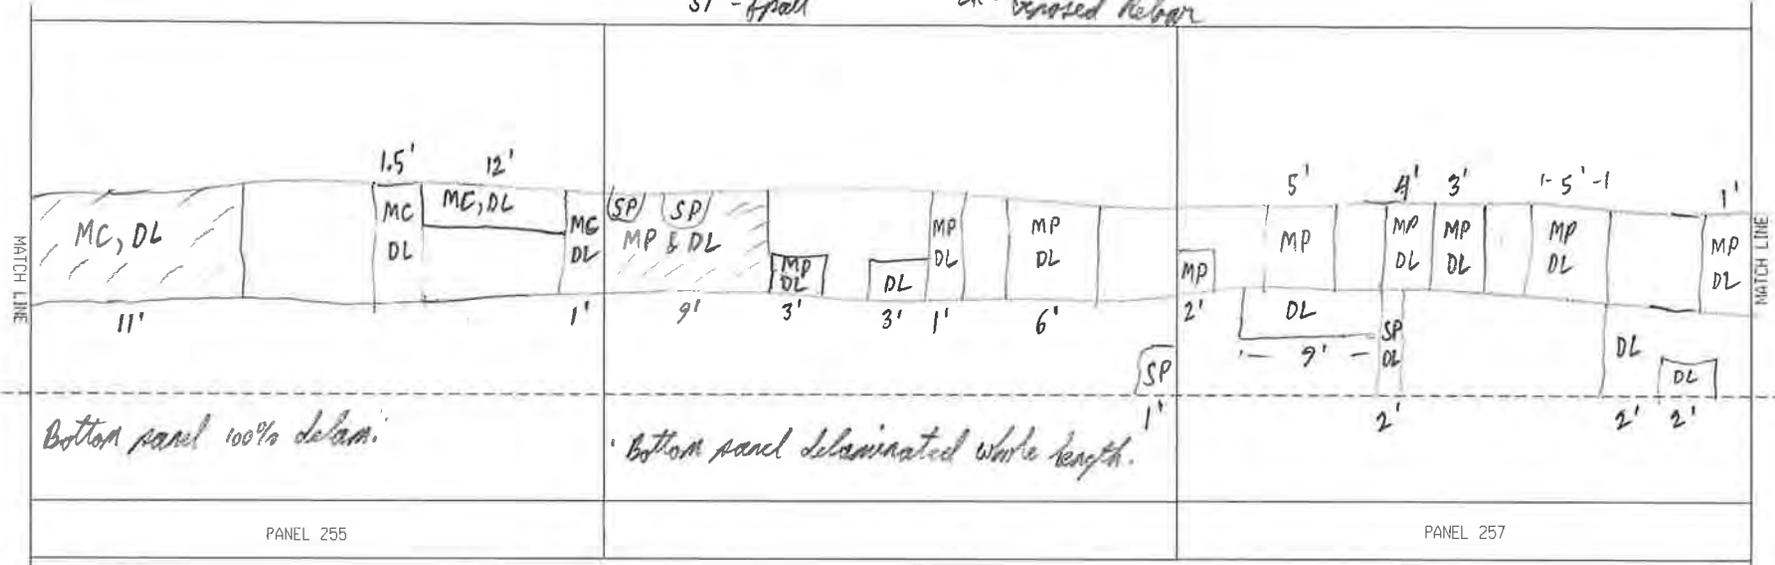


RW 2 PANELS 255-260

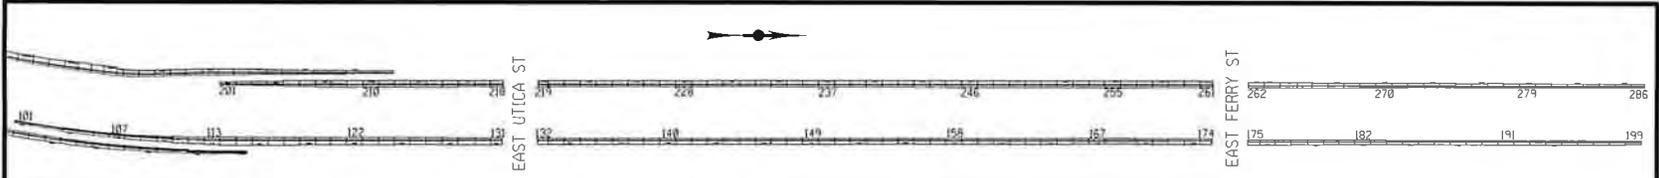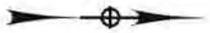

BY: \_\_\_\_\_  
 DATE: 5/8/23  
 SCALE: 1" = 10'

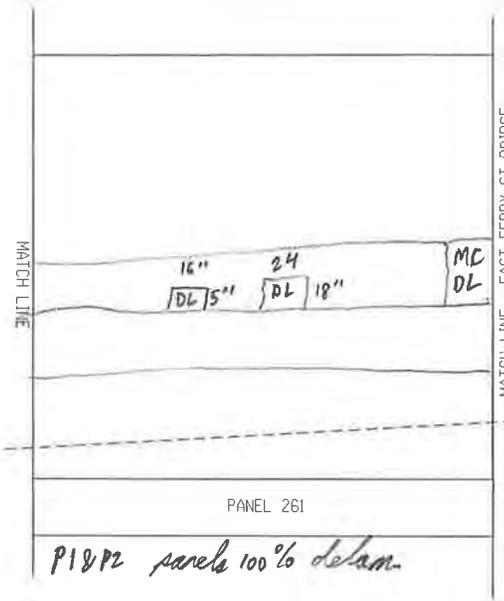


P1 & P2 panels 100% delam.

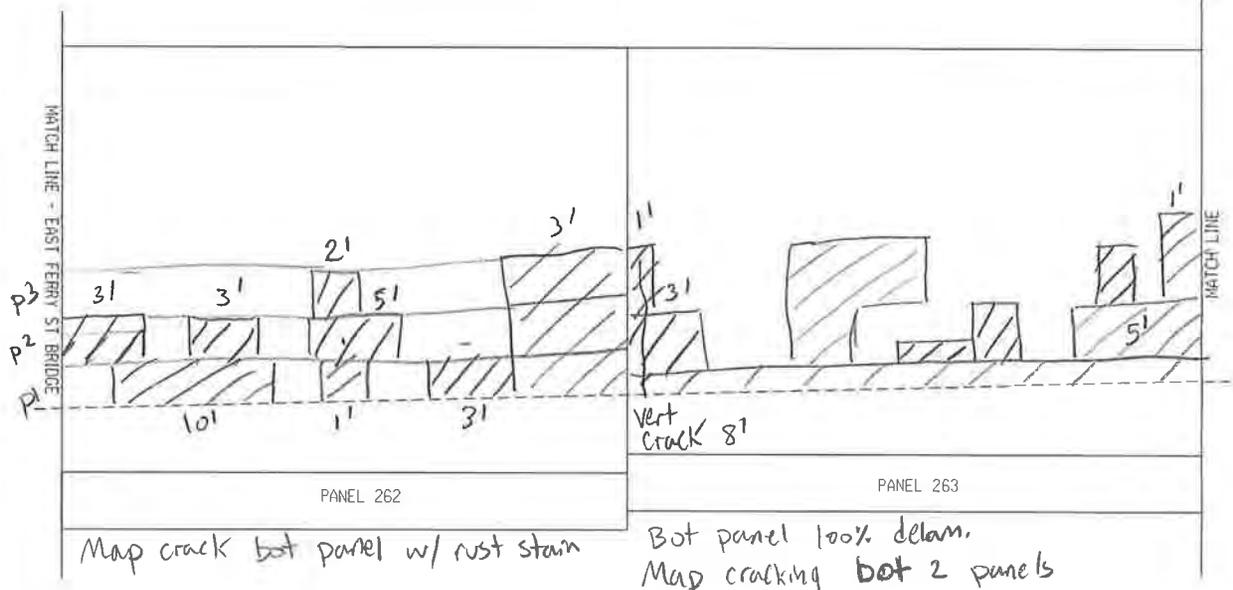


Map crack bot panel w/ rust stain


Bot panel 100% delam. Map cracking bot 2 panels

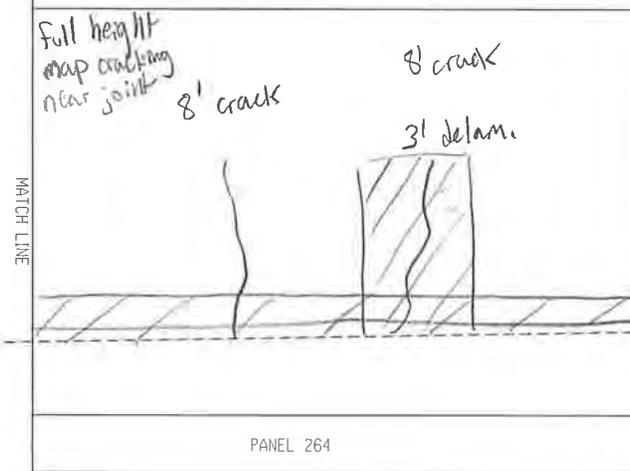

7 panels + coping  
Bot 2 panels 100% delam. + map cracking + rust stain

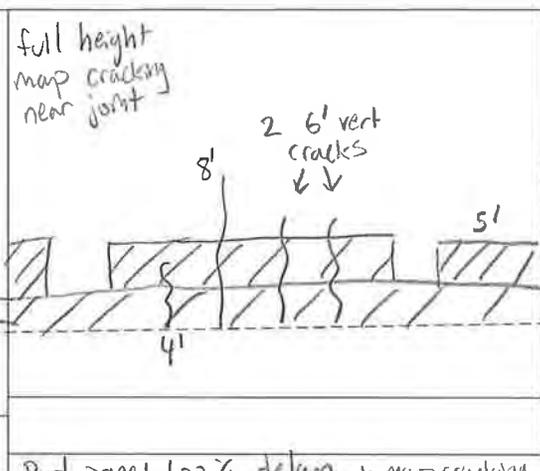


Bot panel 100% delam. + map cracking


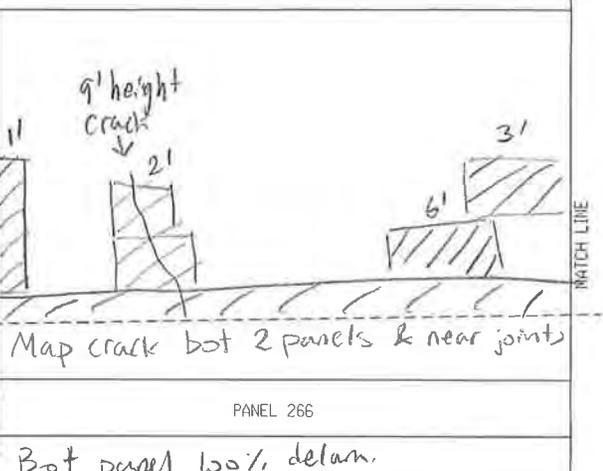


Bot panel 100% delam.



RW 2 PANELS 261-266

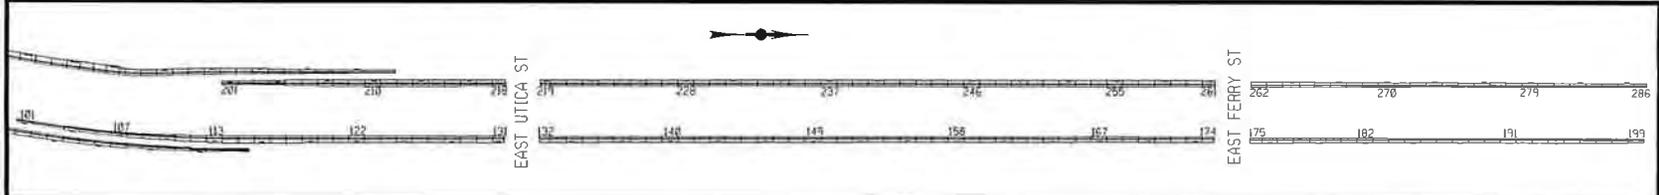

BY: RIM  
DATE: 5/8/23  
SCALE: 1" = 10'

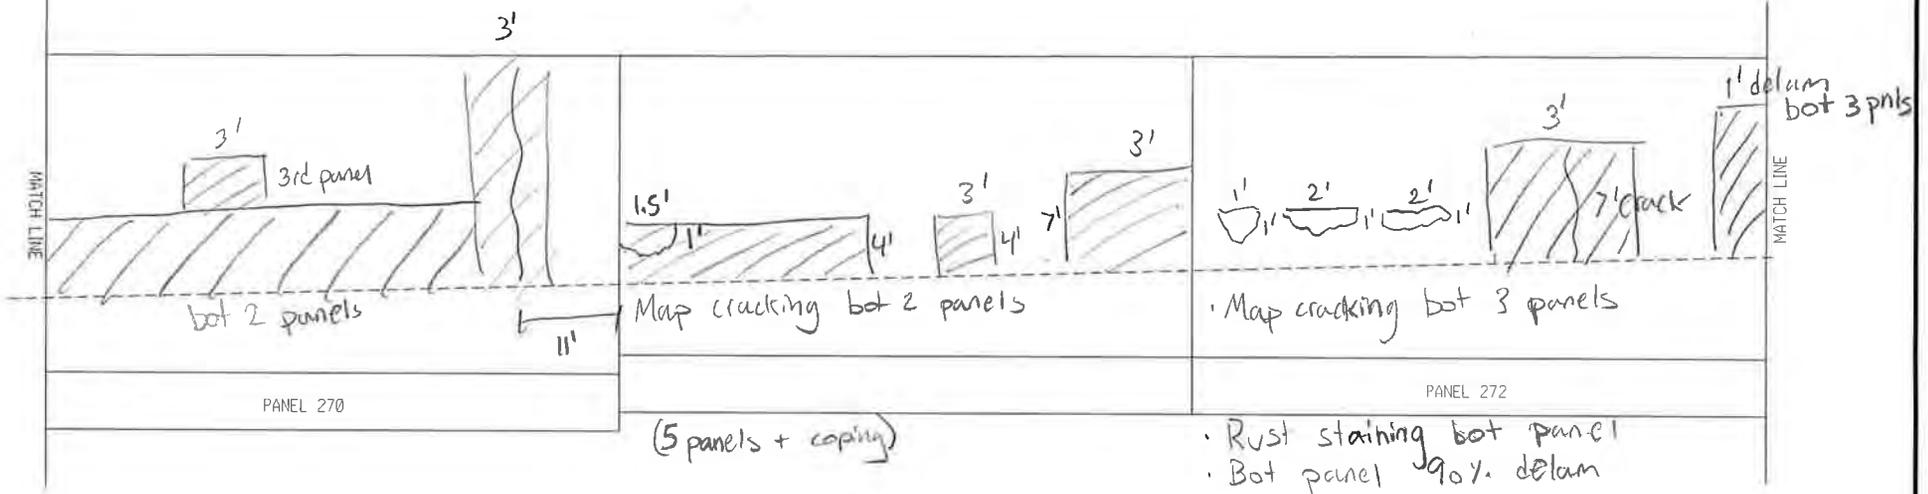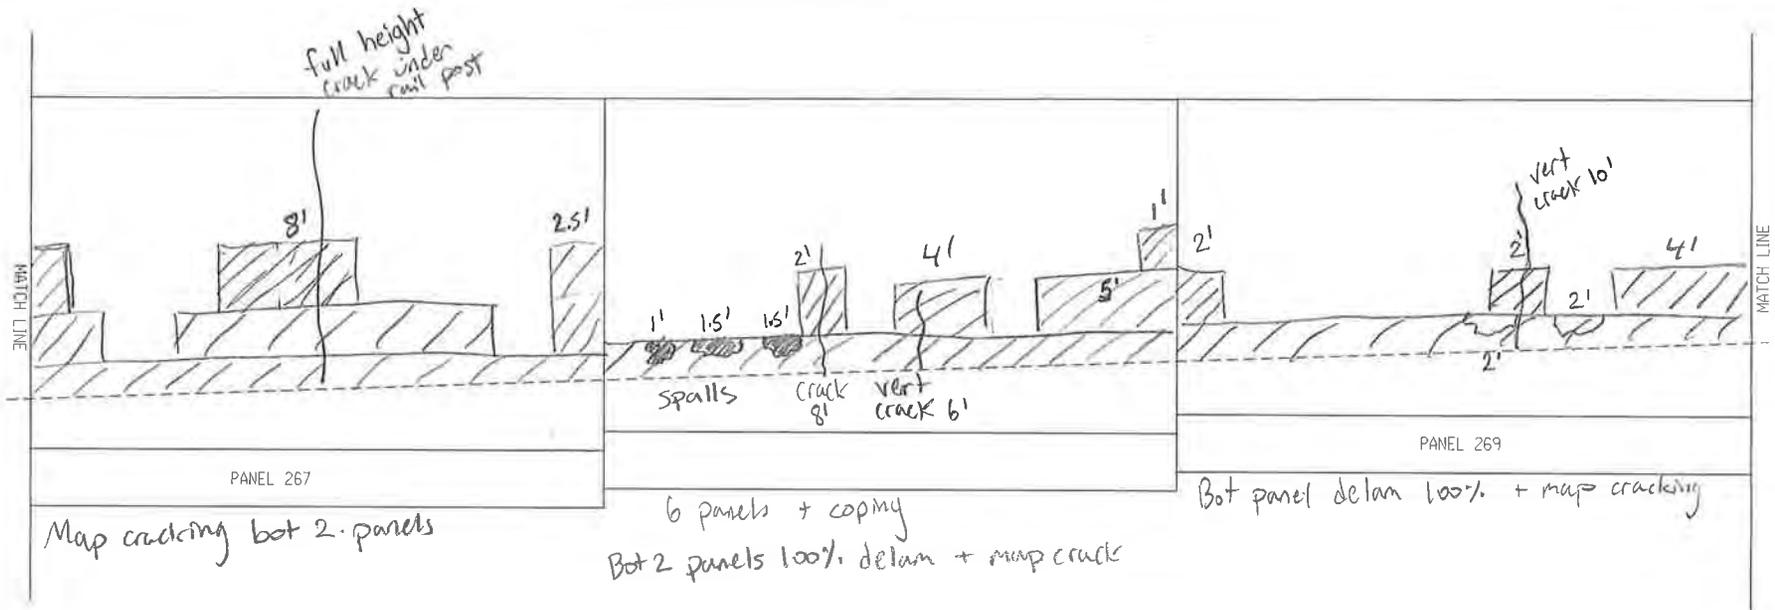


RW 2 PANELS 267-272

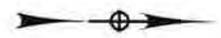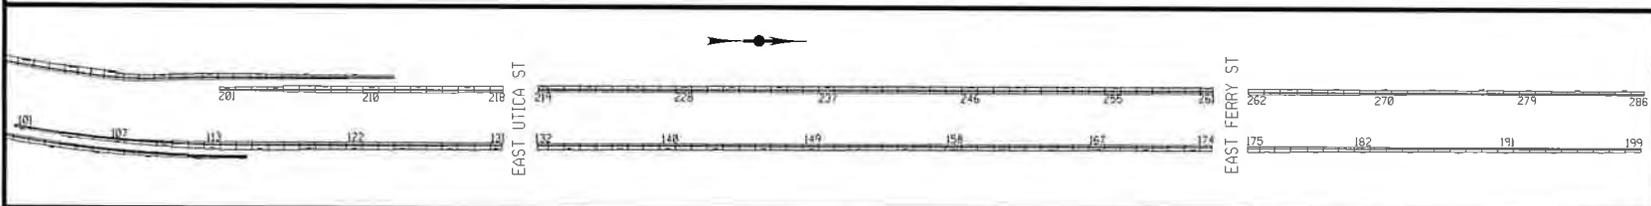

BY: RIM

DATE: 5/8/23

SCALE: 1" = 10'

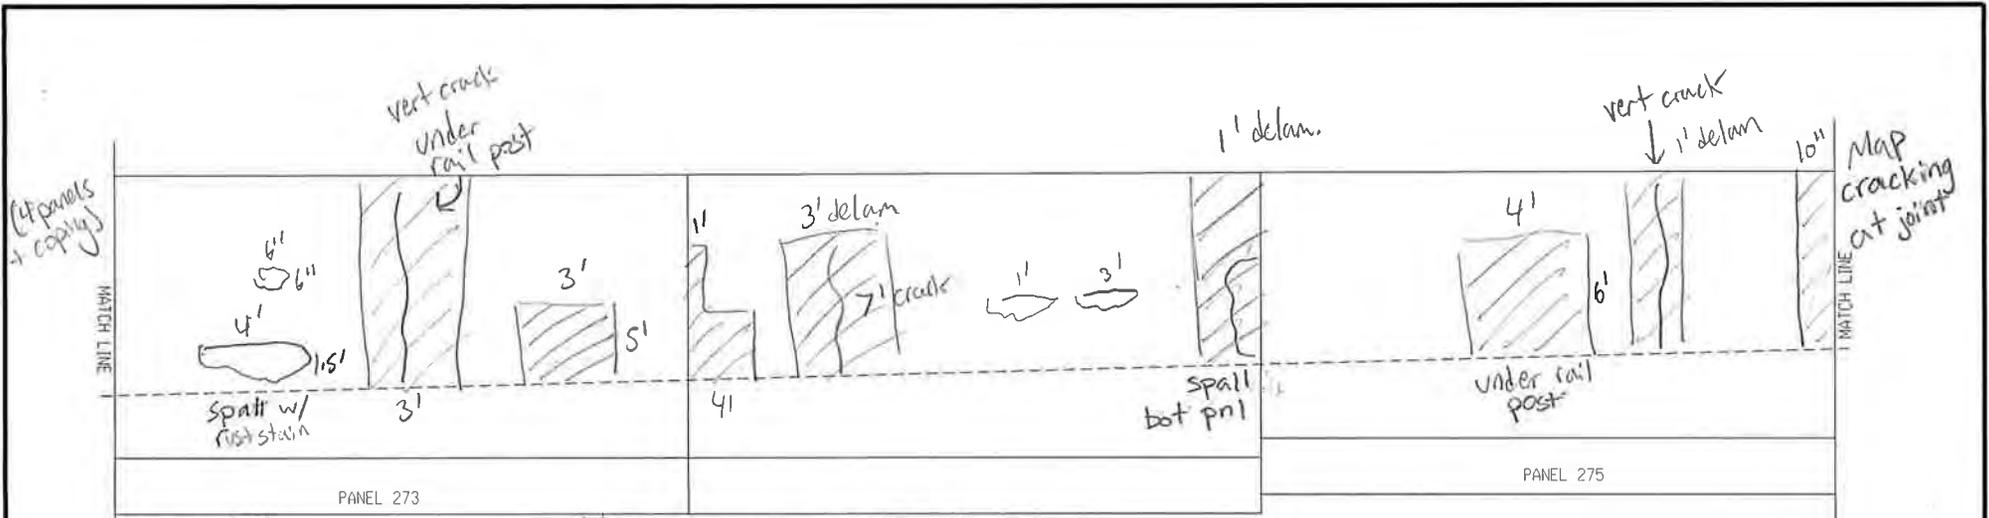


Map cracking at joint


Bot panel 70% delam

• Bot 2 panels 100% delam. w/ Map crack & rust stain

• Map crack on 3rd panel

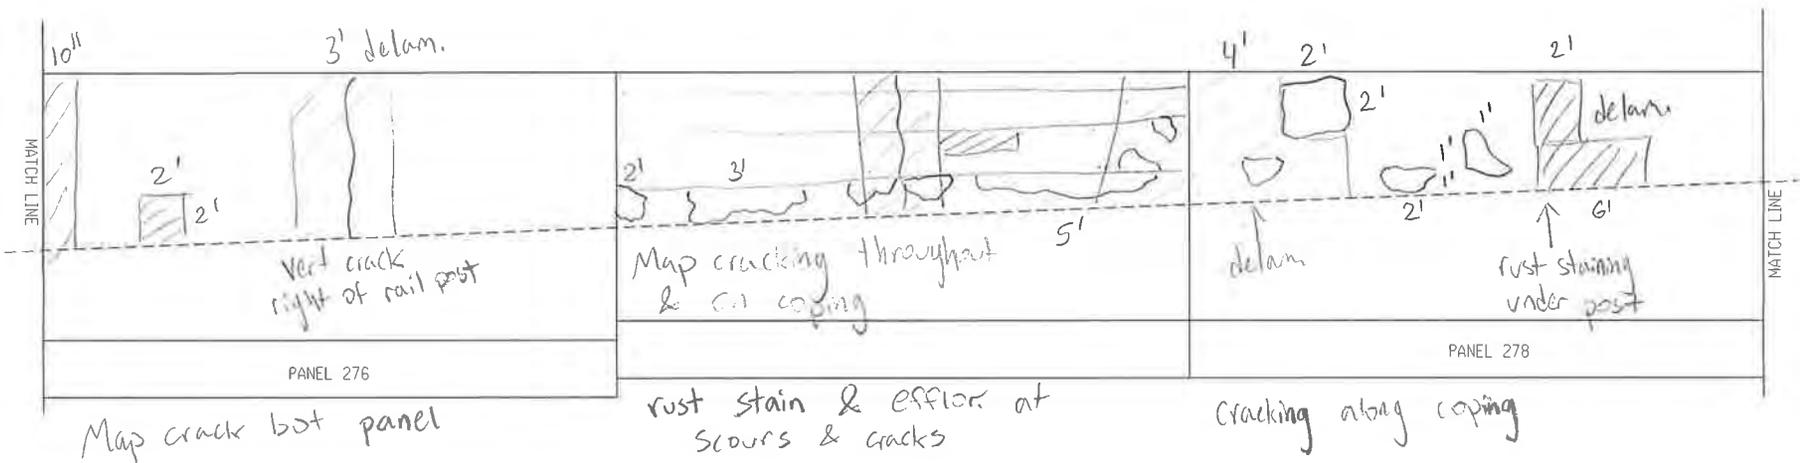





### RW 2 PANELS 273-278

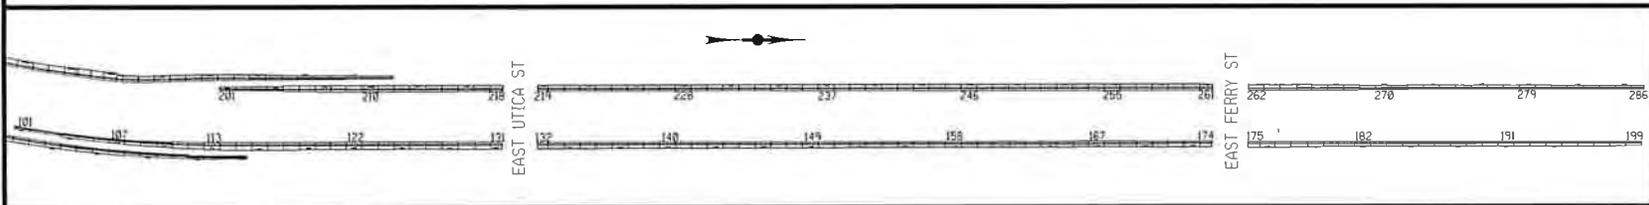


BY: RIM

DATE: 5/8/23

 SCALE: 1" = 10'

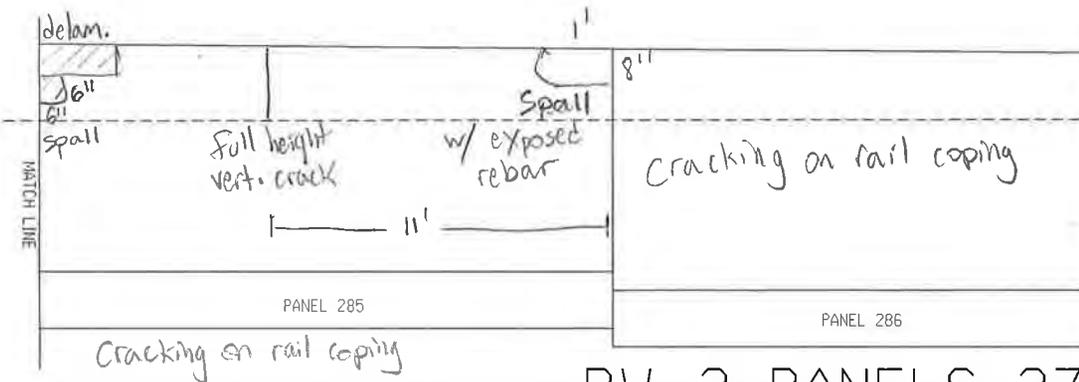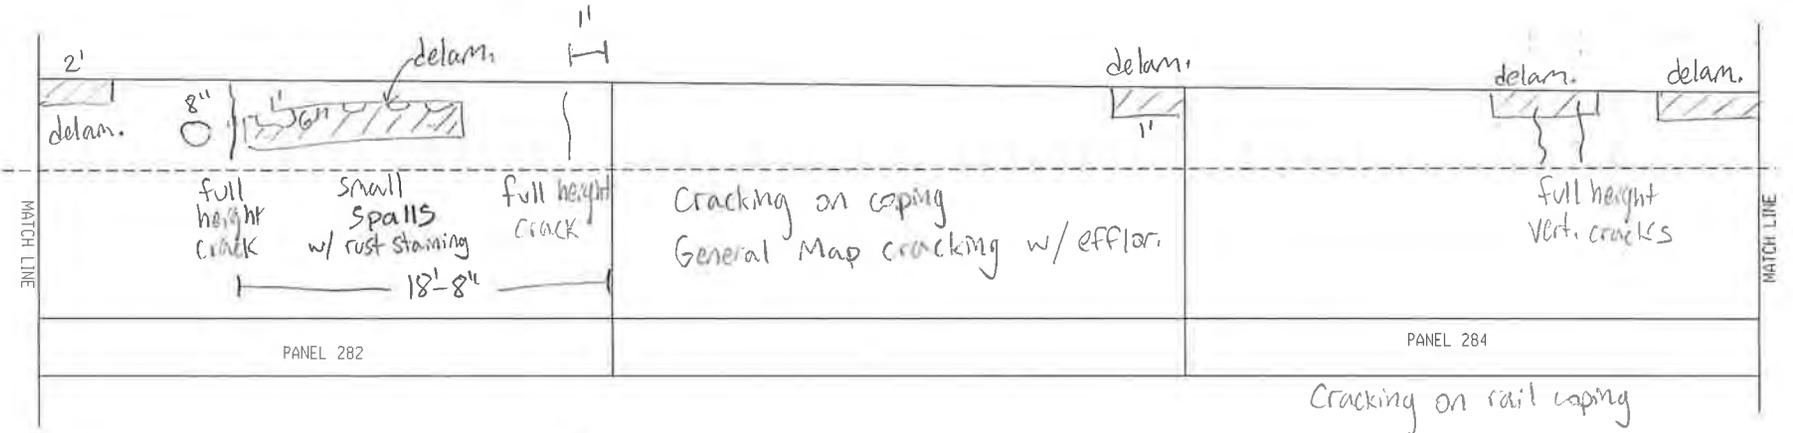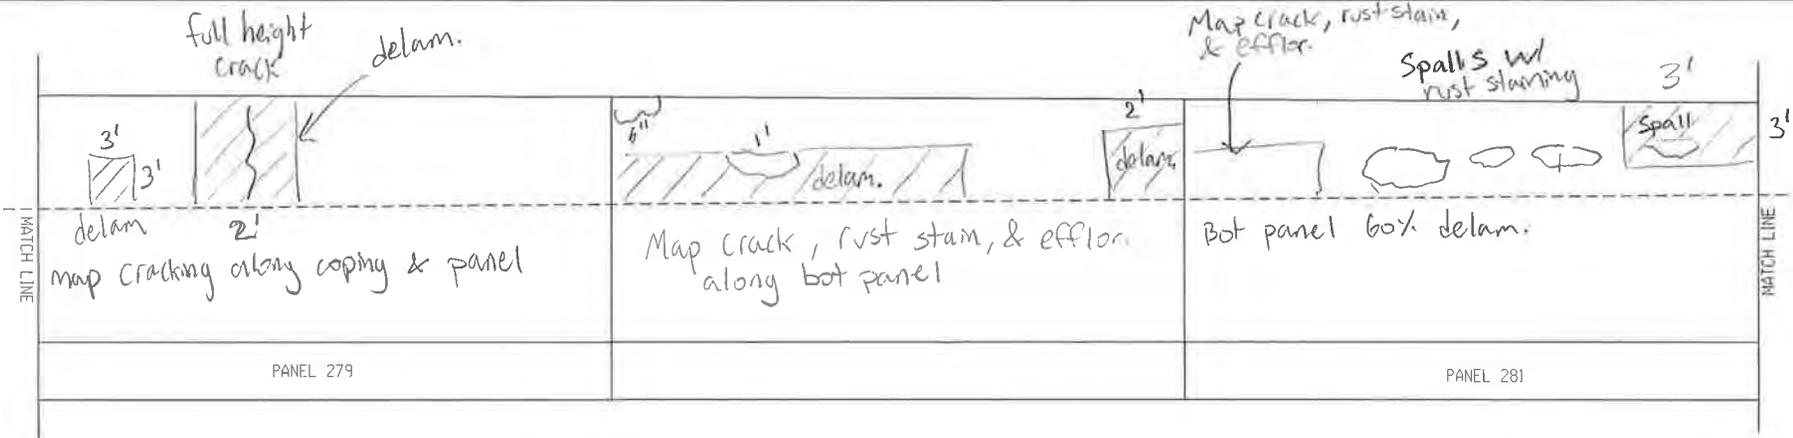

RW 2 PANELS 279-286

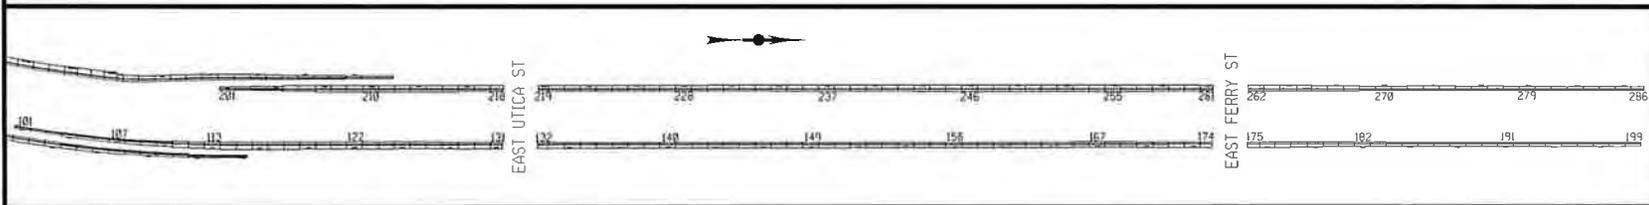

BY: RIM  
 DATE: 5/8/23  
 SCALE: 1' = 10'

## Retaining Wall Coping Inspection 5/30/2023

### Retaining Wall 2

#### End of Wall to East Ferry:

- Rail Coping is cracked at mid-height for entire length
- Bridge Rail is corroded and rusting
- Heavy Spalling from Butler Ave to Goulding
- Coping is delaminated approx. 50%
- 45 ft from E Ferry is tilted at manhole
- Safety walk at intersection (E Ferry) is broken and heaved
- Stress cracking of safety walk at curb joints

#### East Ferry to E Utica:

- At E Ferry, DI, curb, and safety walk are sunken
- 60 ft from E Ferry, manhole adjacent to wall lighting is heaved causing tenting of safety walk.
- 30 ft before Winslow Ave, concrete at wall coping is cracked and delaminated

#### Winslow to E Utica:

- Cracking at top of rail coping becomes intermittent

#### End to Ramp from Humboldt to Rte33

- Majority 75% mid-height crack
- 40% spalled and delam. with rust and rebar exposure

#### General WB:

- Granite curb joints are gapped and curb misaligned

PIN 5512.52 Kensington Expressway  
Retaining Wall #2 (LT) along 33WB between On Ramp from SB Humboldt Parkway and Pedestrian Bridge

# Calculations



300 State Street, Suite 201 • Rochester, NY 14614  
 Phone 585.454.6110 • Fax 585.454.3066  
 www.labellapc.com

PROJECT  
 PIN

|                        |              |
|------------------------|--------------|
| Kensington Inspections |              |
| 5512.52                | CALC. BY RIM |
| DATE                   | 5/26/2023    |

Condition Estimates

- Retaining Wall 2
  - Condition 2 - map cracks, stains, isolated delam, minor cracks
  - Condition 3 - spalls, widespread delam, major cracks
  - Areas with multiple forms of deterioration were measured under only one category. Condition 3 categories were prioritized over condition 2.

| Panel | Minor/Map Crack (sf) | Major Cracks (ft) | Spalls (sf) | Widespread Delam (sf) | Isolated Delam (sf) | Other (staining, efflor., etc.) |
|-------|----------------------|-------------------|-------------|-----------------------|---------------------|---------------------------------|
| 201   | 60                   |                   |             |                       |                     |                                 |
| 202   | 42.75                |                   | 2.25        | 45                    |                     |                                 |
| 203   | 59.5                 |                   | 0.5         | 60                    |                     |                                 |
| 204   | 18.75                |                   |             | 75                    |                     | 4.5                             |
| 205   | 45                   | 8                 |             | 120                   |                     |                                 |
| 206   | 36                   |                   | 1           | 323                   |                     |                                 |
| 207   | 34.5                 |                   |             | 168                   |                     | 30                              |
| 208   | 159.64               | 15                |             | 171                   |                     |                                 |
| 209   | 40                   |                   | 0.5         | 222                   |                     |                                 |
| 210   | 14.25                |                   | 0.5         | 189                   |                     |                                 |
| 211   | 52.5                 | 4                 | 0.25        | 189                   |                     |                                 |
| 212   | 69.75                |                   |             | 235.5                 |                     |                                 |
| 213   | 67.5                 | 6                 |             | 270                   |                     |                                 |
| 214   | 23.25                | 8                 |             | 144                   |                     |                                 |
| 215   | 11.25                |                   |             | 159                   |                     |                                 |
| 216   | 27                   |                   |             | 249                   |                     |                                 |
| 217   | 36                   | 1                 |             | 174                   |                     |                                 |
| 218   | 4.69                 |                   |             | 217.5                 |                     |                                 |
| 219   | 4.69                 | 2.5               |             | 150                   |                     |                                 |
| 220   |                      |                   |             | 230.5                 |                     |                                 |
| 221   |                      |                   |             | 174                   |                     |                                 |
| 222   | 22.5                 | 4                 |             | 240                   |                     |                                 |
| 223   |                      | 9                 |             | 105                   |                     |                                 |
| 224   | 52.5                 | 3                 |             | 210                   |                     |                                 |
| 225   |                      |                   |             | 192                   |                     |                                 |
| 226   | 182                  | 6                 |             | 210                   |                     |                                 |
| 227   | 16.13                |                   |             | 163.5                 |                     |                                 |
| 228   | 107                  |                   |             | 177                   |                     |                                 |
| 229   |                      | 10                |             | 174                   |                     |                                 |
| 230   | 89.25                | 3                 |             | 180                   |                     |                                 |
| 231   |                      |                   |             | 208                   |                     |                                 |
| 232   |                      | 10                |             | 207                   |                     |                                 |
| 233   | 25.65                | 4.5               |             | 198                   |                     |                                 |
| 234   |                      |                   |             | 225                   |                     |                                 |
| 235   | 7.5                  | 10                |             | 180                   |                     |                                 |
| 236   | 12                   |                   |             | 201                   |                     |                                 |
| 237   | 20                   |                   |             | 168                   |                     |                                 |
| 238   | 6                    | 10                |             | 198                   |                     |                                 |
| 239   | 7.5                  |                   |             | 270                   |                     |                                 |
| 240   | 54.75                | 3                 |             | 147                   |                     |                                 |
| 241   | 7.5                  | 9                 |             | 177                   |                     |                                 |
| 242   |                      |                   |             | 183                   |                     |                                 |
| 243   | 15                   |                   |             | 174                   |                     |                                 |
| 244   | 43.5                 | 12                |             | 141                   |                     |                                 |
| 245   | 9                    |                   | 12          | 135                   |                     |                                 |



300 State Street, Suite 201 • Rochester, NY 14614  
 Phone 585.454.6110 • Fax 585.454.3066  
 www.labellapc.com

PROJECT  
 PIN

|                        |          |     |           |
|------------------------|----------|-----|-----------|
| Kensington Inspections |          |     |           |
| 5512.52                | CALC. BY | RIM | DATE      |
|                        |          |     | 5/26/2023 |


Condition Estimates

- Retaining Wall 2

| Panel              | Minor/Map Crack (sf) | Major Cracks (ft) | Spalls (sf)   | Widespread Delam (sf) | Isolated Delam (sf) | Other (staining, efflor., etc.) |               |               |
|--------------------|----------------------|-------------------|---------------|-----------------------|---------------------|---------------------------------|---------------|---------------|
| 246                | 115                  |                   |               | 72                    |                     |                                 |               |               |
| 247                | 86                   | 14                |               | 104                   |                     |                                 |               |               |
| 248                | 143.5                |                   |               | 159                   |                     |                                 |               |               |
| 249                | 83                   |                   |               | 159                   |                     |                                 |               |               |
| 250                | 98                   | 13                |               | 100.5                 |                     |                                 |               |               |
| 251                | 75                   |                   |               | 150                   |                     |                                 |               |               |
| 252                | 89.33                | 13                |               |                       | 55                  |                                 |               |               |
| 253                | 142                  | 13                | 36            | 57                    |                     |                                 |               |               |
| 254                | 28.00                |                   | 6             | 124                   |                     |                                 |               |               |
| 255                | 9                    |                   |               | 166.5                 |                     |                                 |               |               |
| 256                | 34.5                 | 13                |               | 156                   |                     |                                 |               |               |
| 257                | 101.25               |                   | 6             |                       | 81                  |                                 |               |               |
| 258                | 120                  |                   | 27            |                       | 33                  |                                 |               |               |
| 259                | 142.00               | 13                |               | 11                    | 39                  |                                 |               |               |
| 260                | 39                   |                   |               | 153                   |                     |                                 |               |               |
| 261                | 8                    |                   |               | 159                   |                     |                                 |               |               |
| 262                | 39                   |                   |               | 108                   |                     |                                 |               |               |
| 263                | 42                   |                   |               | 135                   |                     |                                 |               |               |
| 264                | 66                   | 4                 |               | 132                   |                     |                                 |               |               |
| 265                | 37                   |                   |               | 168                   |                     |                                 |               |               |
| 266                | 30                   |                   |               | 138                   |                     |                                 |               |               |
| 267                | 6                    | 7                 |               | 205.5                 |                     |                                 |               |               |
| 268                | 21                   |                   |               | 156                   |                     |                                 |               |               |
| 269                |                      | 4                 |               | 114                   |                     |                                 |               |               |
| 270                | 23.75                |                   |               | 159                   |                     |                                 |               |               |
| 271                | 129.5                |                   |               | 85                    |                     |                                 |               |               |
| 272                | 205.5                |                   | 5             | 94                    |                     |                                 |               |               |
| 273                | 66                   |                   | 0.25          | 96                    |                     |                                 |               |               |
| 274                | 53                   |                   |               | 153                   |                     |                                 |               |               |
| 275                |                      |                   |               |                       | 40.5                |                                 |               |               |
| 276                | 42                   |                   |               |                       | 38.5                |                                 |               |               |
| 277                | 132                  |                   | 45            | 93                    |                     |                                 |               |               |
| 278                | 103.00               |                   | 7             | 72                    |                     |                                 |               |               |
| 279                | 124.67               |                   |               |                       | 23                  |                                 |               |               |
| 280                | 22.5                 |                   | 0.5           | 112.5                 |                     |                                 |               |               |
| 281                | 39                   |                   |               | 81                    |                     |                                 |               |               |
| 282                | 52.28                | 8                 | 0.44          |                       | 30                  |                                 |               |               |
| 283                | 67.5                 |                   |               |                       | 1                   |                                 |               |               |
| 284                | 25.5                 |                   |               |                       |                     |                                 |               |               |
| 285                | 23.5                 |                   | 0.92          |                       |                     |                                 |               |               |
| 286                | 19.5                 |                   |               |                       |                     |                                 |               |               |
| <b>Total (sf):</b> | <b>4168.57</b>       | <b>120.00</b>     | <b>151.11</b> | <b>11702.00</b>       | <b>341.00</b>       | <b>34.50</b>                    | <b>COND 2</b> | <b>COND 3</b> |
|                    |                      | (sf)              |               |                       |                     |                                 | 4545          | 11974         |

PIN 5512.52 Kensington Expressway  
Retaining Wall #2 (LT) along 33WB between On Ramp from SB Humboldt Parkway and Pedestrian Bridge
 
# Wall Inventory Sheet



## INVENTORY, INSPECTION, AND DATA COLLECTION

| PRIMARY OWNER   |   | WALL INSPECTION LOCATION<br>INFORMATION & NOTES |
|---|---|---|
| NYS DOT - New York State Department of Transportation |   |   |
| REGION  | 05-Region 05 - Buffalo  |   |
| COUNTY  | 3-County 3 - Erie   |   |
| RESIDENCY   | 534 - Erie North Residency  |   |
| NYS ROUTE   | Rte. 33   |   |
| REFERENCE MARKER                                      | 3350311032  |   |
| LONGITUDE   | 78.84363  |   |
| LATITUDE  | 42.91378  |   |
| ADDITIONAL<br>LOCATION<br>DESCRIPTION                 | Located along the right shoulder of W.B. Kensington from the off-ramp to N.B. Humboldt Parkway and extending beyond Sidney Street supporting S.B. Humboldt Parkway (approximately 2,552 ft. long, 20 ft. maximum exposed height). The west abutments for the E. Utica and E. Ferry Street Overpass Bridges are not considered as part of RW #2. |   |
| TYPE OF SERVICE<br>PROVIDED                           | Support/Protect a Roadway   |   |
| WALL TYPE   | Cantilever - Concrete   |   |
| LEGACY RETAINING<br>WALL TYPE                         |   |   |
| WALL FACING TYPE                                      | Cast - in -Place Concrete   |   |
| WALL BACKFILL<br>REINFORCEMENT TYPE                   | N/A   |   |
| ADDITIONAL WALL<br>DESCRIPTION                        |   |   |
| WALL LENGTH   | 2,552 ft  |   |
| WALL MAXIMUM<br>HEIGHT                                | 20 Ft   |   |
| WALL AREA   | 61070 SF  |   |
| YEAR BUILT  | 1970  |   |
| CONTRACT NUMBER                                       | C 68-2  |   |
| AADT  | 76,347  |   |
| QC REVIEWER   |   |   |
| QC APPROVED DATE                                      |   |   |
| SITE ACCESS NOTES                                     | With WZTC in place to close the adjacent shoulder and travel lane, access was performed by walking and extension ladder.  |   |
| INSPECTION<br>FREQUENCY                               |   |   |
| LAST INSPECTION<br>STATUS                             |   |   |
| INSTRUMENTED  | N/A   |   |
| MONITORED BY  | ----  |   |
| INSTRUMENTATION<br>COMMENT                            | ----  |   |
| CONSEQUENCE OF<br>FAILURE                             | 3-Major   |   |
| WALL POSITION   | Between Roads   |   |
| GENERAL NOTES   |   |   |
| RETAINING WALL<br>DATABASE ID                         |   |   |
| NUMBER OF ERRORS<br>AND WARNINGS                      |   |   |
| USER UPDATE   |   |   |
| SUBMISSION DATE                                       |   |   |
| DATE UPDATE   |   |   |



**NY33 RETAINING WALL CONDITION EVALUATION 2023**  
**KENSINGTON EXPRESSWAY PROJECT**  
**PIN 5512.52**  
**CITY OF BUFFALO, ERIE COUNTY**  
**RETAINING WALL 3**



Prepared By:

Merton J. Edwards, PE (NYSPE 064981)  
Inspection Team Leader | Sr. Structural Engineer  
Date: 5/30/2023

Reviewed By:

Stephen L. Gauthier, PE (NYSPE 0075775)  
Quality Control Engineer | Sr. Structural Engineer  
Date: 6/16/2023

 **LaBella**  
Powered by partnership.  
300 State Street  
Rochester, New York 14614  
ph: 585-454-6110  
[www.labellapc.com](http://www.labellapc.com)

# PIN 5512.52 – NY33 RETAINING WALL CONDITION EVALUATION 2023 FIELD INSPECTION SUMMARY

STRUCTURE: Retaining Wall #3 (RT) along 33EB. Located along the right side of the off-ramp to N.B. Humboldt Parkway and extending past Riley Street

STRUCTURE TYPE: Reinforced Concrete Cantilever Wall on Piles (Panels 301-315)  
Reinforced Concrete Cantilever Wall on Spread Footings (Panels 316-319)  
Year Built: 1970

CURRENT INSPECTION: 05/01/23 – 5/09/23 (LaBella Inspections)

LAST KNOWN INSPECTION: Unknown

CONDITION STATE: FAIR

## RETAINING WALL INSPECTION & DOCUMENTATION:

Inspection of the retaining walls will be in conformance with the NYSDOT Retaining Wall Inventory and Inspection Program Manual, October 2018. Inspection of the following elements will be inspected and documented as appropriate:

### - Inspection:

The following procedure will be followed for the inspection of retaining walls:

- Walls were checked for signs of settlement, rotation, or bulging. Walls faces were checked for vertical alignment using a smart level. The walls being evaluated are vertical with no batter.
- Construction joints between sections of the wall were examined for misalignment, and near the ground line for fill material washing out from between panels or joint.
- Walls were inspected for erosion material in front of the wall, for heaving of material in front of the wall, and for settlement of fill behind the wall.
- Examined the wall for deterioration of the material, such as cracking, spalling, and/or corrosion, noting the width, length, depth, and/or orientation of the deterioration. Photographs are provided, documenting defects found.
- Wall façades were reviewed for evidence of water seepage, efflorescence, or rust staining.
- Examined the base of walls for evidence of water flow where the water table may be within the retained earth.
- Examined and probed drains for signs of clogging. Examined drainage around ends of wall and note if embankments have been experiencing erosion.
- Examined site grading for any locations that may prohibit proper drainage from behind the wall looking for evidence of ponding above the wall, such as debris accumulation in the lower spots.
- Ascertain why water is not draining properly and note in the inspection.
- Inspected roadway components above wall for signs or joint separation, potholes, and areas of settlement.
- Examined vegetation growth along and above the wall for root infiltration creating undesirable stresses on the wall. Documented any induce cracking, bulging or failure.
- Examined the wall system for vehicular damage and document the location and degree of damage.

PIN 5512.52 Kensington Expressway  
 Retaining Wall #3 (RT) along 33EB  
 Located along the right side of the off-ramp to N.B. Humboldt Parkway and extending past Riley Street

**GENERAL OBSERVATIONS:**

1. Retaining Wall Panels are generally 30 ft in length with horizontal chamfered panels spaced 3'-0" vertically, from the top of the wall. There is some variation in panel length due to the location of bridges within the corridor. For specific panel lengths see the DOCUMENTION Section of this report.
2. The lower 5 ft of the subject retaining wall was found to be in FAIR-POOR condition with extensive map cracking, dampness, isolated rust staining, spalls, and widespread delaminations. For specific conditions found and photographs of the wall panels, see the DOCUMENTION Section of this report.
3. The upper portions of theses wall panels were generally found to be in GOOD condition with the exception of a few locations. Localized map cracking was found under several rail post locations. For specific conditions found and photographs of the wall panels, see the DOCUMENTION Section of this report.
4. The rail coping was found to be in FAIR-POOR condition with 50% map cracking and minimal areas of delamination. For specific conditions found, photographs of the of wall panels, and condition calculations see the attached sections of this report.

| General:                    |  |
|-----------------------------|--|
| DEFECT                      | DESCRIPTION  |
| Misalignment                | None noted.  |
| Settlement                  | The concrete safety walk behind the full-height section of the retaining wall slopes toward the back of the retaining wall. The curb and safety walk are misaligned. |
| Sinkhole (cavity) Formation | None noted.  |

| Concrete Cracks:                                     |  |
|--|--|
| DEFECT   | DESCRIPTION  |
| Insignificant Cracks<br>(cracks < 0.012 inches wide) | Vertical cracks are present on some of the panels in the bottom 3'-5' of the wall. The placement mirrors that of the underlying rebar.   |
| Map cracks   | The wall railing system coping is map cracked over 50% of its surface.<br><br>A few of the panels have localized map cracking under rail posts, near joints, near vertical cracks, and in the lower half of the panel. |
| Moderate Cracks<br>(0.012 - 0.05 inches wide)        | A few of the panels have full height cracks near midspan of the panel (314, 311, 308, and 302).<br><br>There is a longitudinal crack at mid-height of the coping.  |
| Wide Cracks<br>(cracks > 0.05 inches wide)           | None noted.  |

PIN 5512.52 Kensington Expressway  
 Retaining Wall #3 (RT) along 33EB  
 Located along the right side of the off-ramp to N.B. Humboldt Parkway and extending past Riley Street

| Additional Concrete Distress: |  |
|-------------------------------|--|
| DEFECT                        | DESCRIPTION  |
| Spalling / Delamination       | Spalls and delamination (5%-50%) are common in the bottom 4' of the wall.<br><br>Around 10% of the backside of the coping is spalled and 15% is delaminated. |
| Staining                      | Isolated areas of minor rust staining are present, typically near the bottom of the panel. Staining is present under most rail posts.                        |
| Exposed Rebar                 | 5 spalls have exposed rebar with 15%-20% loss. See panels 302, 308, 307, 306, 318.   |

| Notes:   |
|--|
| RW 3 consists of 19 panels numbered from 301 (South) to 319 (North). The retaining wall supports the N.B. Humboldt Parkway above State Route 33 (Kensington Expressway).<br><br>Located along the right side of the off-ramp to N.B. Humboldt Parkway and extending past Riley Street (Approximately 567 ft. long, 14 ft. maximum exposed height). |

**INVENTORY, INSPECTION, AND DATA COLLECTION**

| Element                       | Total Qty | Units | Condition State |             |             |               |
|-------------------------------|-----------|-------|-----------------|-------------|-------------|---------------|
|                               |           |       | 1               | 2           | 3           | 4             |
|                               |           |       | <i>GOOD</i>     | <i>FAIR</i> | <i>POOR</i> | <i>SEVERE</i> |
| RW.01 - Entire Wall           | 1         | Each  | 0.77            | 0.16        | 0.07        |               |
| RW.02 - Wall Facing           | 5084      | SF    | 3657            | 990         | 437         |               |
| RW.03 - Ground Surface, Front | 567       | FT    | 567             |             |             |               |
| RW.04 - Ground Surface, Back  | 567       | FT    | 542             |             | 25          |               |
| RW.05 - Weep Holes            | N/A       | Each  | ---             | ---         | ---         | ---           |
| 800 - Scour                   | N/A       | FT    | ---             | ---         | ---         | ---           |

PIN 5512.52 Kensington Expressway

Retaining Wall #3 (RT) along 33EB

Located along the right side of the off-ramp to N.B. Humboldt Parkway and extending past Riley Street

#### INSPECTION RESULTS/ RECOMMENDATIONS

- **Overall Condition State Recommendation: 2 - FAIR**
- PROJECT DOCUMENTATION CAN BE FOUND IN THE ATTACHED SECTIONS

PIN 5512.52 Kensington Expressway

Retaining Wall #3 (RT) along 33EB

Located along the right side of the off-ramp to N.B. Humboldt Parkway and extending past Riley Street

## Inspection Photos

# PIN 5512.52 – NY33 RETAINING WALL CONDITION EVALUATION 2023 FIELD INSPECTION SUMMARY

Retaining Wall #3 (RT) along 33EB. Located along the right side of the off-ramp to N.B. Humboldt Parkway and extending past Riley Street.



PHOTO 1  
PANEL 302  
Description:  
Full-height crack to right of rail post. Rust staining and map cracking under rail post typical throughout the wall. Map cracking and rust staining on bottom 2 panels.



PHOTO 2  
PANEL 304  
Description:  
Vertical cracking at many vertical rebar locations in bottom panel, typical throughout the wall. Minor map cracking is present as well. Bottom 1' of the wall is delaminated.

# PIN 5512.52 – NY33 RETAINING WALL CONDITION EVALUATION 2023 FIELD INSPECTION SUMMARY

Retaining Wall #3 (RT) along 33EB. Located along the right side of the off-ramp to N.B. Humboldt Parkway and extending past Riley Street.



PHOTO 3

PANEL 305

**Description:**

Bottom panel of wall is 50% delaminated. Map cracking is present on the bottom 4' of the wall and is most concentrated near rebar locations. Rust staining at some rebar locations is typical for most of the wall.

Spalls with exposed rebar similar to spalls on panels 308 and 307.



PHOTO 4

PANEL 306

**Description:**

Bottom 4' of wall is 50% delaminated and map cracked. Vertical cracks are present at rebar locations.

Panel has the largest spall on RW3, with exposed rebar with 20% loss.

# PIN 5512.52 – NY33 RETAINING WALL CONDITION EVALUATION 2023 FIELD INSPECTION SUMMARY

Retaining Wall #3 (RT) along 33EB. Located along the right side of the off-ramp to N.B. Humboldt Parkway and extending past Riley Street.



PHOTO 5

PANEL 308

**Description:**

Full-height vertical crack with efflorescence and map cracking on either side.

Bottom 2.5' is 30% to 40% delaminated. The bottom 2 panels have significant map cracking and rust staining. Panel 307 is similar without the rust staining.



PHOTO 6

PANEL 309

**Description:**

Map cracking and rust staining underneath rail post and near top of joints. Material loss from joint.

Rail coping is map cracked 50% with minimal delamination for most of RW3.

# PIN 5512.52 – NY33 RETAINING WALL CONDITION EVALUATION 2023 FIELD INSPECTION SUMMARY

Retaining Wall #3 (RT) along 33EB. Located along the right side of the off-ramp to N.B. Humboldt Parkway and extending past Riley Street.



PHOTO 7

PANEL 311

**Description:**

Full height crack with rust staining and efflorescence.

Localized map cracking and staining under rail posts for full-height, same for panel 312.

Scattered map cracking throughout.



PHOTO 8

PANEL 312

**Description:**

Heavier map cracking throughout especially under rail posts. No measurable delamination.

Scattered areas of rust staining.

# PIN 5512.52 – NY33 RETAINING WALL CONDITION EVALUATION 2023 FIELD INSPECTION SUMMARY

Retaining Wall #3 (RT) along 33EB. Located along the right side of the off-ramp to N.B. Humboldt Parkway and extending past Riley Street.



PHOTO 9

PANEL 314

**Description:**

Two full-height cracks and map cracking on bottom panel. Minor map cracking and staining under rail posts.

Minor spalling in the chamfer between panels.

Conditions similar for panels 313 to 317.



PHOTO 10

PANEL 318

**Description:**

Longitudinal crack on rail coping extends full length of panels 318 and 319. Coping is 40% delaminated.

Panel is heavily spalled for 4' from the left joint with exposed rebar with 20% loss.

# PIN 5512.52 – NY33 RETAINING WALL CONDITION EVALUATION 2023 FIELD INSPECTION SUMMARY

Retaining Wall #3 (RT) along 33EB. Located along the right side of the off-ramp to N.B. Humboldt Parkway and extending past Riley Street.



**PHOTO 11**  
Safety walk behind wall

**Description:**  
The safety walk and curb are misaligned. The safety walk has settled at the retaining wall back face, rotating the safety walk to be higher than the curb.


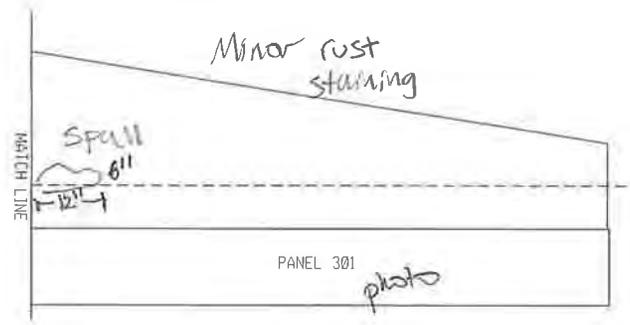


**PHOTO 12**  
Safety walk behind wall


**Description:**  
The safety walk, across from Gerard Place, is sloped toward the back of the retaining wall for approximately 25 ft.  
The curb and safety walk are misaligned with the curb being below the edge of sidewalk.  
The coping has a mid-height longitudinal crack.

PIN 5512.52 Kensington Expressway  
Retaining Wall #3 (RT) along 33EB  
Located along the right side of the off-ramp to N.B. Humboldt Parkway and extending past Riley Street

## Field Sheets

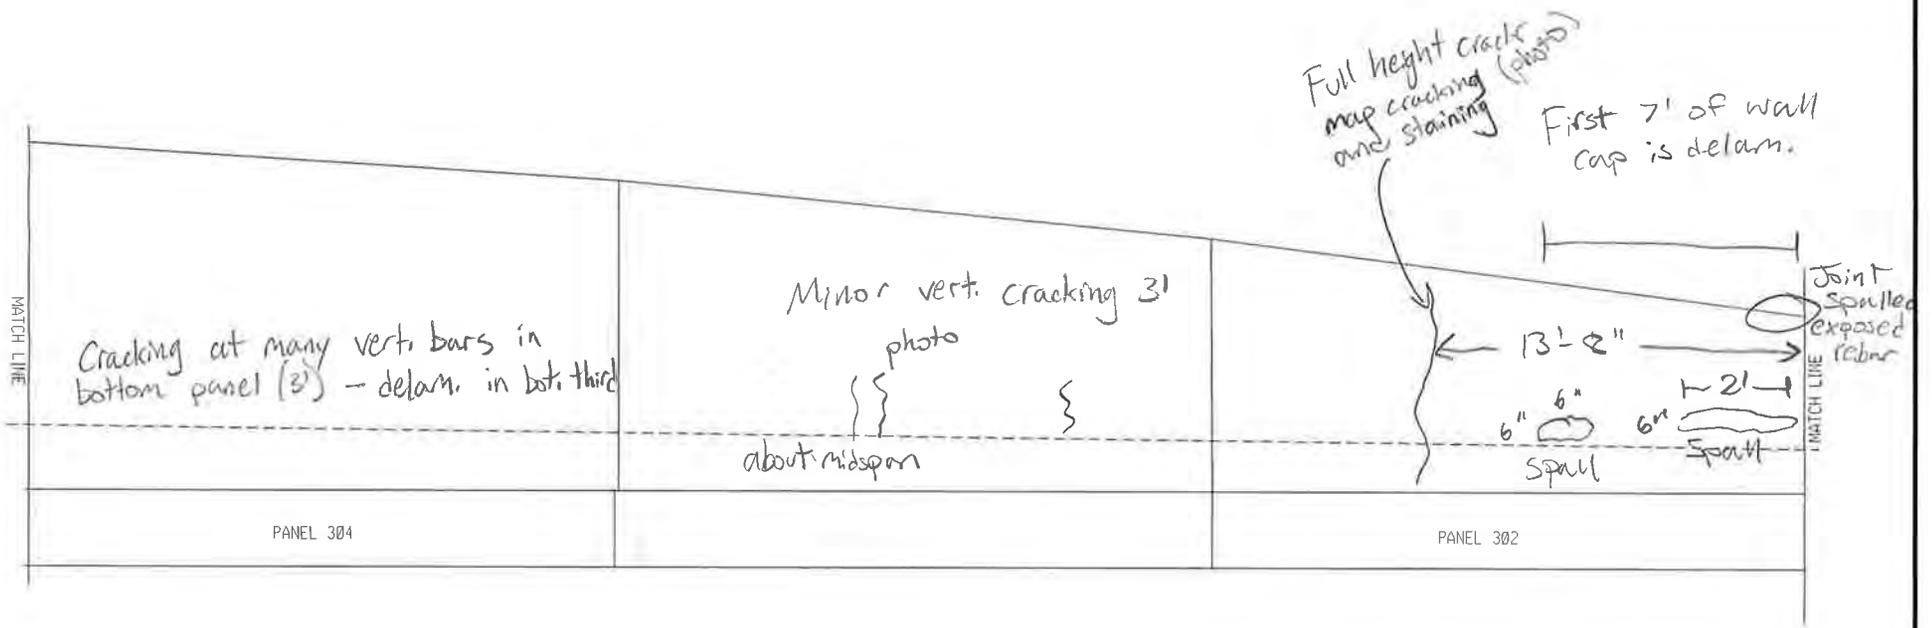

RW 3 PANELS 304-301


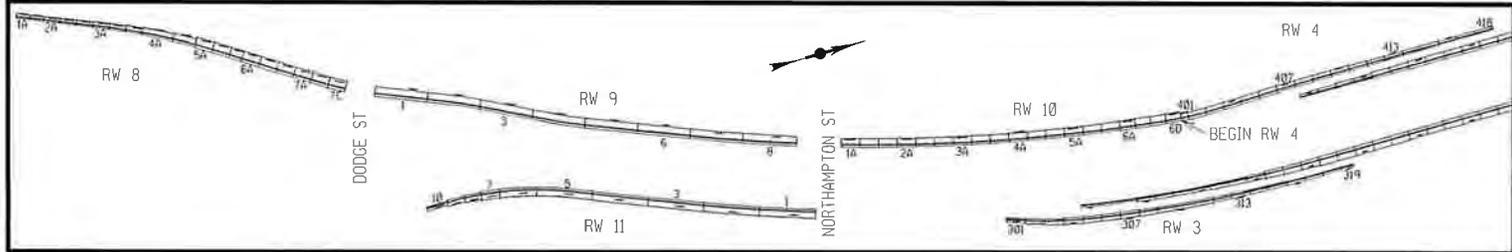


BY: RIM  
 DATE: 5/1/23  
 SCALE: 1" = 10'


Bot 30" 10% delam. & map cracking

Map cracking 5' x 5' photo

Bot 2.5' 30% to 40% delam.

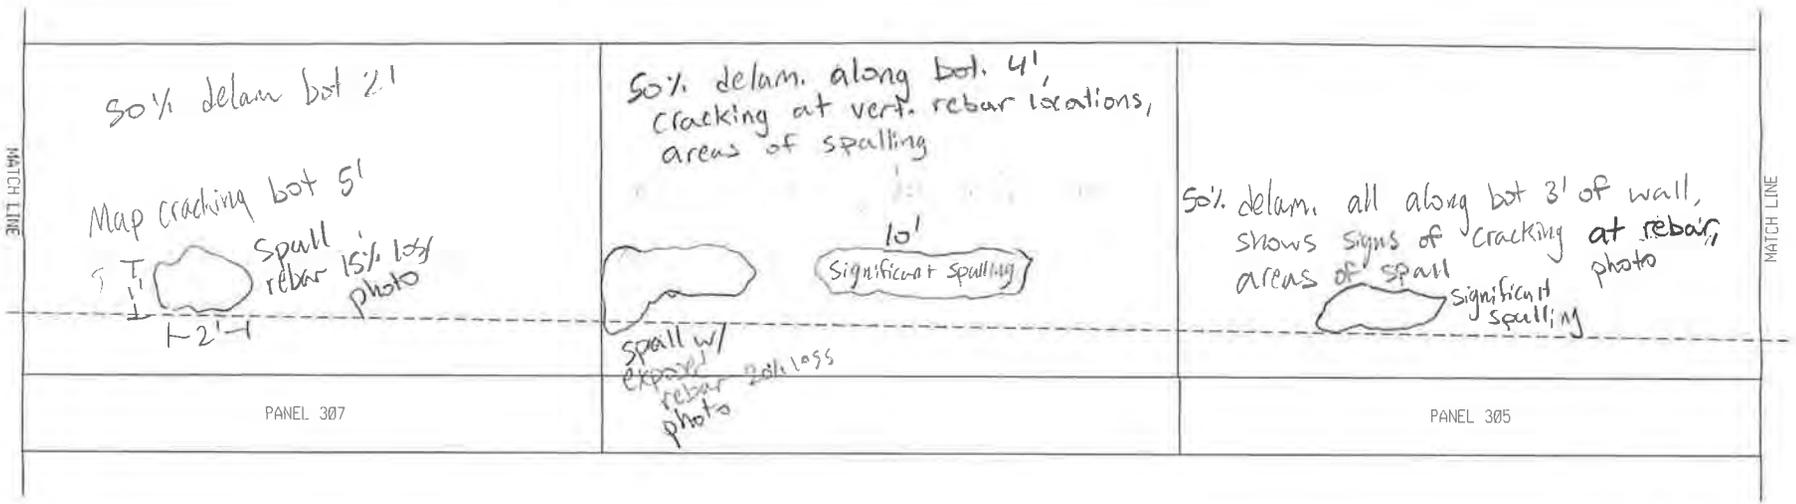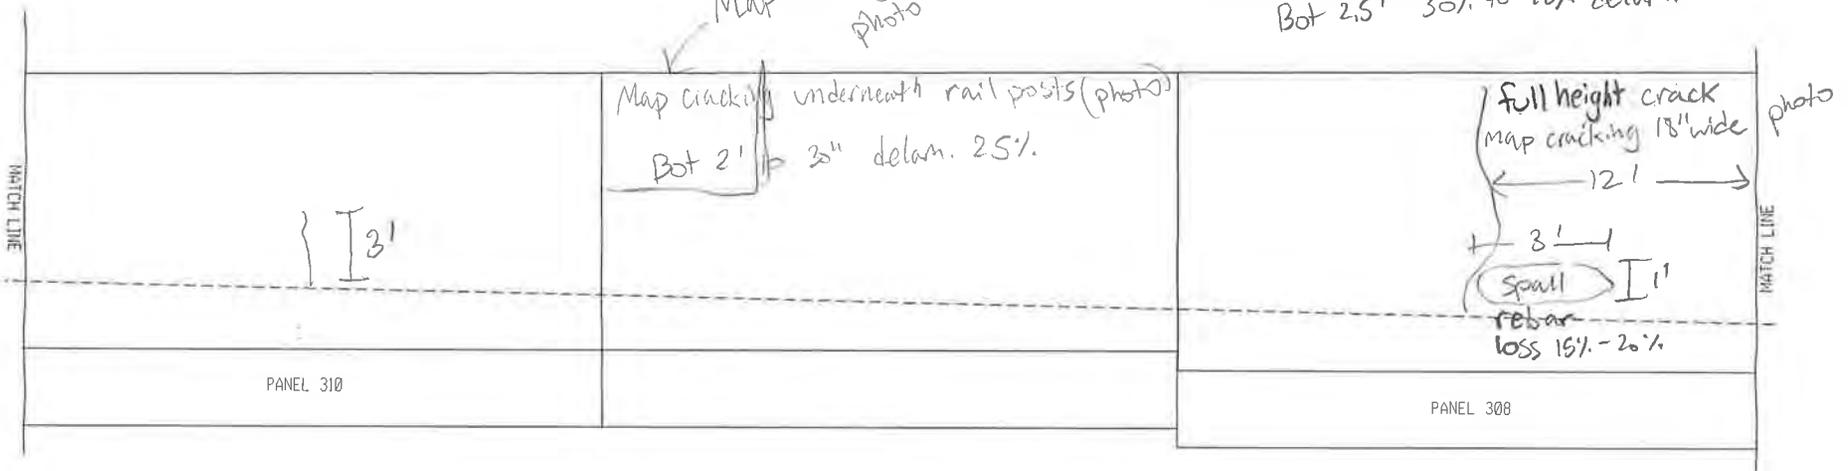

RW 3 PANELS 310-305

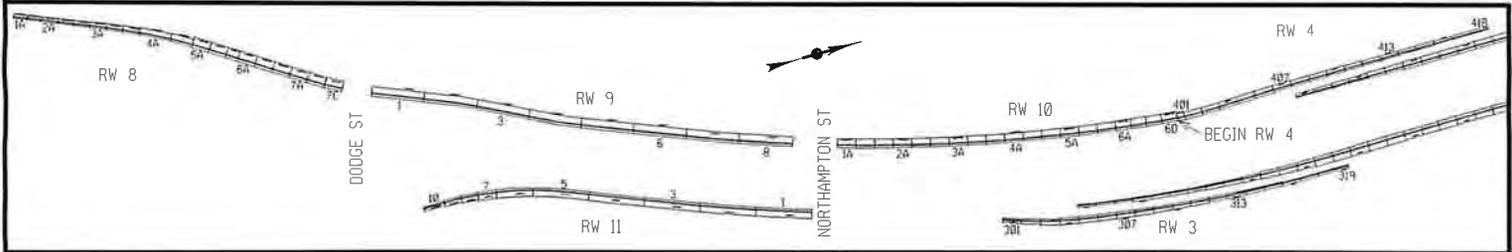




BY: RIM  
 DATE: 5/1/23  
 SCALE: 1" = 10'

General: Cap is map cracked 50% w/ minimal delam.


Longit crack continues

Longit. crack on rail coping full length 40% delam,

2' spall/delam. @ joint

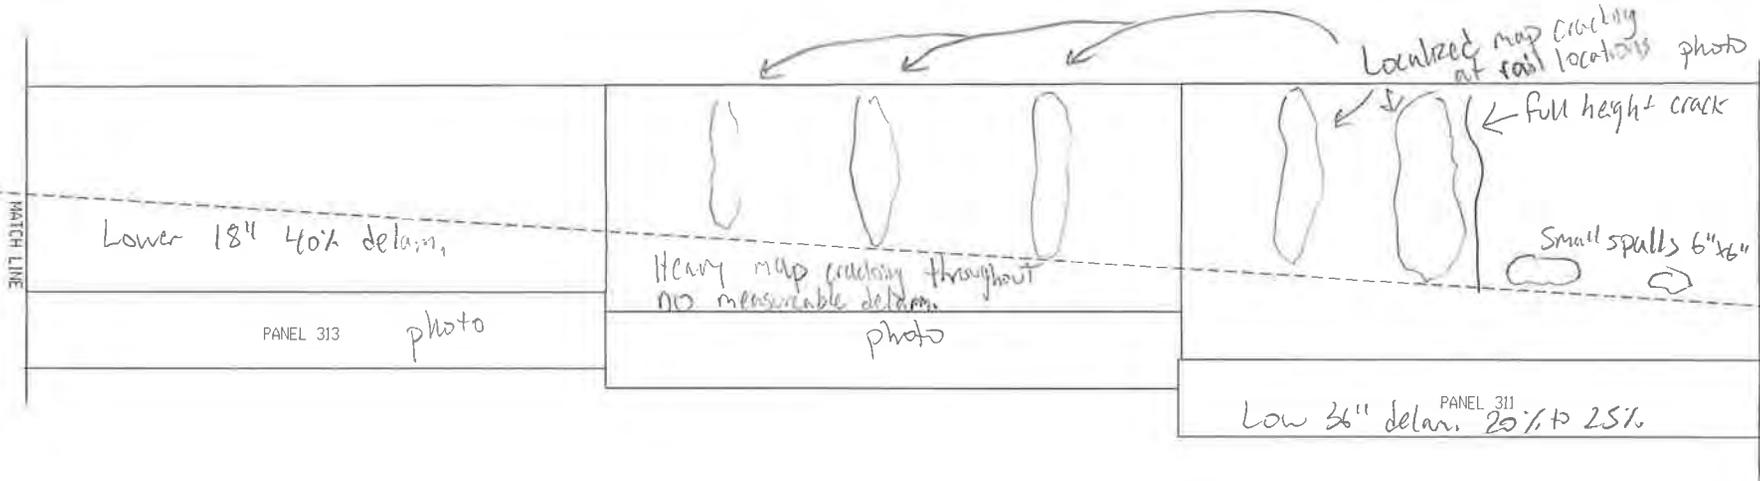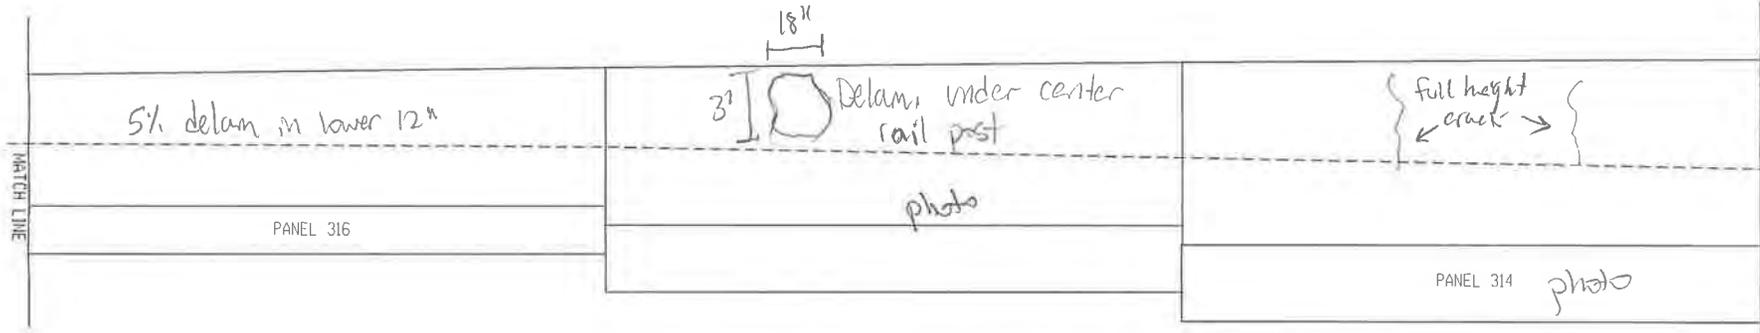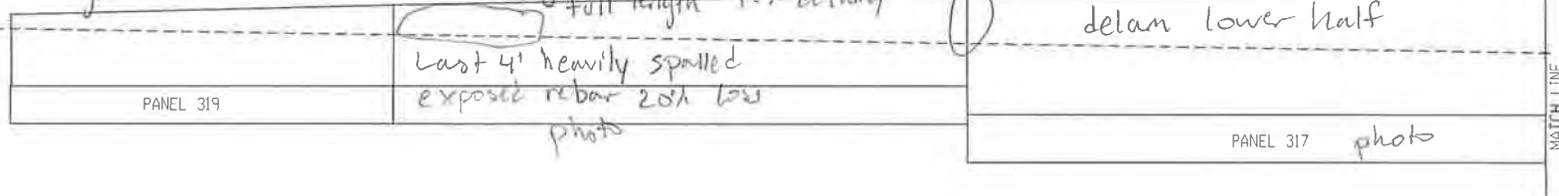

### RW 3 PANELS 319-311

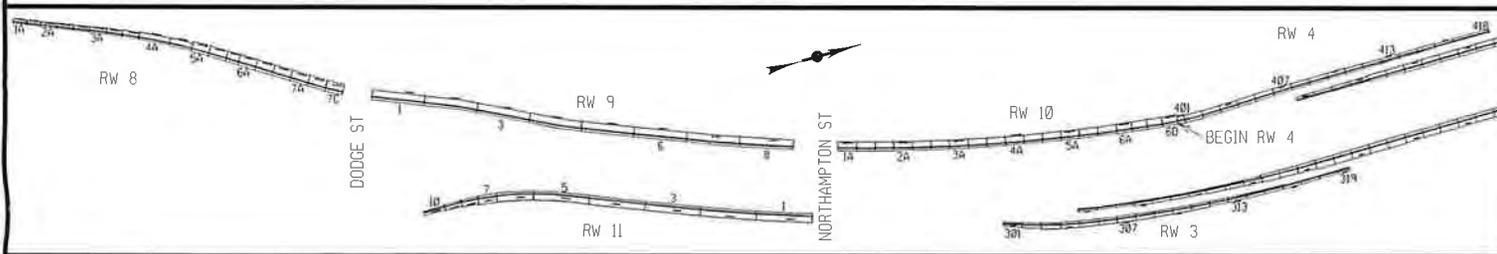

BY: RIM  
 DATE: 5/1/23  
 SCALE: 1" = 10'

## Retaining Wall Coping Inspection 5/30/2023

### Retaining Wall 3

- Concrete safety walk behind full-height wall slopes drastically toward back of wall. 3" in 3.5'
- Curb and safety walk are misaligned with curb below safety walk edge.
- Longitudinal crack at mid-height of coping for full length
- Some areas are spalled 10%, delam 15%

PIN 5512.52 Kensington Expressway  
Retaining Wall #3 (RT) along 33EB  
Located along the right side of the off-ramp to N.B. Humboldt Parkway and extending past Riley Street

## Calculations



300 State Street, Suite 201 • Rochester, NY 14614  
 Phone 585.454.6110 • Fax 585.454.3066  
 www.labellapc.com

PROJECT  
 PIN

Kensington Inspections

---

|         |          |     |           |
|---------|----------|-----|-----------|
| 5512.52 | CALC. BY | RIM | DATE      |
|         |          |     | 5/26/2023 |

Condition Estimates

- Retaining Wall 3
  - Condition 2 - map cracks, stains, isolated delam, minor cracks
  - Condition 3 - spalls, widespread delam, major cracks
  - Areas with multiple forms of deterioration were measured under only one category. Condition 3 categories were prioritized over condition 2.

| Panel       | Minor/Map<br>Crack (sf) | Major Cracks<br>(ft) | Spalls (sf) | Widespread<br>Delam (sf) | Other<br>(staining,<br>efflor., etc.) |               |               |
|-------------|-------------------------|----------------------|-------------|--------------------------|---------------------------------------|---------------|---------------|
| 301         |                         |                      | 0.5         |                          | 1                                     |               |               |
| 302         | 90                      | 7                    | 1.75        | 3.5                      |                                       |               |               |
| 303         |                         | 9                    |             |                          |                                       |               |               |
| 304         |                         |                      |             | 90                       |                                       |               |               |
| 305         | 45                      |                      | 4           | 45                       |                                       |               |               |
| 306         | 60                      |                      | 20          | 60                       |                                       |               |               |
| 307         | 120                     |                      | 2           | 30                       |                                       |               |               |
| 308         | 55.5                    | 13                   | 3           | 30                       |                                       |               |               |
| 309         | 34                      |                      |             | 18.75                    |                                       |               |               |
| 310         | 75                      |                      | 3.00        | 0.25                     |                                       |               |               |
| 311         | 36                      | 9                    | 0.5         | 22.5                     |                                       |               |               |
| 312         | 210                     |                      |             |                          |                                       |               |               |
| 313         | 20                      |                      |             | 18                       |                                       |               |               |
| 314         | 30                      | 10                   |             |                          |                                       |               |               |
| 315         |                         |                      | 4.5         | 4                        |                                       |               |               |
| 316         |                         |                      |             | 1.5                      |                                       |               |               |
| 317         |                         |                      | 2           | 30                       |                                       |               |               |
| 318         |                         |                      | 12          | 6                        |                                       |               |               |
| 319         |                         |                      |             |                          |                                       |               |               |
| Coping      | 212.63                  |                      |             |                          |                                       | <b>COND 2</b> | <b>COND 3</b> |
| Total (sf): | 988.13                  | 24.00                | 53.25       | 359.50                   | 1.00                                  | 990           | 437           |

(sf)

PIN 5512.52 Kensington Expressway  
Retaining Wall #3 (RT) along 33EB  
Located along the right side of the off-ramp to N.B. Humboldt Parkway and extending past Riley Street

## Wall Inventory Sheet



## INVENTORY, INSPECTION, AND DATA COLLECTION

|                                  |  | WALL INSPECTION LOCATION INFORMATION & NOTES |
|----------------------------------|--|--|
| PRIMARY OWNER                    | NYSDOT - New York State Department of Transportation   |  |
| REGION                           | 05-Region 05 - Buffalo   |  |
| COUNTY                           | 3-County 3 - Erie  |  |
| RESIDENCY                        | 534 - Erie North Residency   |  |
| NYS ROUTE                        | Rte. 33  |  |
| REFERENCE MARKER                 | 3353011030   |  |
| LONGITUDE                        | 78.84339   |  |
| LATITUDE                         | 42.90806   |  |
| ADDITIONAL LOCATION DESCRIPTION  | Located along the right shoulder of E.B. mainline and off-ramp for northbound Humboldt Parkway and supports N.B. Humboldt Parkway (approximately 567 ft. long, 14 ft. maximum exposed height). |  |
| TYPE OF SERVICE PROVIDED         | Support/Protect a Roadway  |  |
| WALL TYPE                        | Cantilever - Concrete  |  |
| LEGACY RETAINING WALL TYPE       |  |  |
| WALL FACING TYPE                 | Cast - in -Place Concrete  |  |
| WALL BACKFILL REINFORCEMENT TYPE | N/A  |  |
| ADDITIONAL WALL DESCRIPTION      |  |  |
| WALL LENGTH                      | 567 Ft   |  |
| WALL MAXIMUM HEIGHT              | 14 ft  |  |
| WALL AREA                        | 8840 SF  |  |
| YEAR BUILT                       | 1970   |  |
| CONTRACT NUMBER                  | C 68-2   |  |
| AADT                             | 76,347   |  |
| QC REVIEWER                      |  |  |
| QC APPROVED DATE                 |  |  |
| SITE ACCESS NOTES                | With WZTC in place to close the adjacent shoulder and travel lane, access was performed by walking and extension ladder.   |  |
| INSPECTION FREQUENCY             |  |  |
| LAST INSPECTION STATUS           |  |  |
| INSTRUMENTED                     | N/A  |  |
| MONITORED BY                     | ----   |  |
| INSTRUMENTATION COMMENT          | ----   |  |
| CONSEQUENCE OF FAILURE           | 3-Major  |  |
| WALL POSITION                    | Between Roads  |  |
| GENERAL NOTES                    |  |  |
| RETAINING WALL DATABASE ID       |  |  |
| NUMBER OF ERRORS AND WARNINGS    |  |  |
| USER UPDATE                      |  |  |
| SUBMISSION DATE                  |  |  |
| DATE UPDATE                      |  |  |

**NY33 RETAINING WALL CONDITION EVALUATION 2023**  
**KENSINGTON EXPRESSWAY PROJECT**  
**PIN 5512.52**  
**CITY OF BUFFALO, ERIE COUNTY**  
**RETAINING WALL 4**



Prepared By:



Merton J. Edwards, PE (NYSPE 064981)  
Inspection Team Leader | Sr. Structural Engineer  
Date: 5/30/2023

Reviewed By:



Stephen L. Gauthier, PE (NYSPE 0075775)  
Quality Control Engineer | Sr. Structural Engineer  
Date: 6/16/2023

 **LaBella**  
Powered by partnership.  
300 State Street  
Rochester, New York 14614  
ph: 585-454-6110  
[www.labellapc.com](http://www.labellapc.com)

# PIN 5512.52 – NY33 RETAINING WALL CONDITION EVALUATION 2023 FIELD INSPECTION SUMMARY

STRUCTURE: Retaining Wall #4 (RT) along 33WB between Northampton St and Utica St

STRUCTURE TYPE: Reinforced Concrete Cantilever Wall on Piles (Panels 401-415)  
Reinforced Concrete Cantilever Wall on Spread Footings (Panels 416-418)  
Year Built: 1970

CURRENT INSPECTION: 05/01/23 – 5/09/23 (LaBella Inspections)

LAST KNOWN INSPECTION: Unknown

CONDITION STATE: FAIR

## RETAINING WALL INSPECTION & DOCUMENTATION:

Inspection of the retaining walls will be in conformance with the NYSDOT Retaining Wall Inventory and Inspection Program Manual, October 2018. Inspection of the following elements will be inspected and documented as appropriate:

### - Inspection:

The following procedure will be followed for the inspection of retaining walls:

- Walls were checked for signs of settlement, rotation, or bulging. Walls faces were checked for vertical alignment using a smart level. The walls being evaluated are vertical with no batter.
- Construction joints between sections of the wall were examined for misalignment, and near the ground line for fill material washing out from between panels or joint.
- Walls were inspected for erosion material in front of the wall, for heaving of material in front of the wall, and for settlement of fill behind the wall.
- Examined the wall for deterioration of the material, such as cracking, spalling, and/or corrosion, noting the width, length, depth, and/or orientation of the deterioration. Photographs are provided, documenting defects found.
- Wall façades were reviewed for evidence of water seepage, efflorescence, or rust staining.
- Examined the base of walls for evidence of water flow where the water table may be within the retained earth.
- Examined and probed drains for signs of clogging. Examined drainage around ends of wall and note if embankments have been experiencing erosion.
- Examined site grading for any locations that may prohibit proper drainage from behind the wall looking for evidence of ponding above the wall, such as debris accumulation in the lower spots.
- Ascertain why water is not draining properly and note in the inspection.
- Inspected roadway components above wall for signs of joint separation, potholes, and areas of settlement.
- Examined vegetation growth along and above the wall for root infiltration creating undesirable stresses on the wall. Documented any induce cracking, bulging or failure.
- Examined the wall system for vehicular damage and document the location and degree of damage.

GENERAL OBSERVATIONS:

1. Retaining Wall Panels are generally 30 ft in length with horizontal chamfered panels spaced 3'-0" vertically, from the top of the wall. There is some variation in panel length due to the location of bridges within the corridor. For specific panel lengths see the DOCUMENTION Section of this report.
2. The lower 3-6 ft of the subject retaining wall was found to be in FAIR-POOR condition with extensive map cracking, dampness, isolated rust staining, spalls and widespread delamination. For specific conditions found and photographs of the wall panels, see the DOCUMENTION Section of this report.
3. The upper portions of theses wall panels were generally found to be in GOOD condition with the exception of a very few locations. For specific conditions found and photographs of the wall panels, see the DOCUMENTION Section of this report.
4. Most panels were found to have mid-height to full-height vertical cracks near the midspan of the panel. For specific conditions found, photographs of the of wall panels, and condition calculations see the attached sections of this report.

| General:                    |             |
|-----------------------------|-------------|
| DEFECT                      | DESCRIPTION |
| Misalignment                | None noted. |
| Settlement                  | None noted. |
| Sinkhole (cavity) Formation | None noted. |

| Concrete Cracks:                                     |   |
|--|---|
| DEFECT   | DESCRIPTION   |
| Insignificant Cracks<br>(cracks < 0.012 inches wide) | None noted.   |
| Map cracks   | The bottom 1 to 2 panels (3'-6') are map cracked on all panels. On some panels the map cracking extends higher near the joints and vertical cracks.<br><br>Half of the panels have map cracking on the rail system coping.    |
| Moderate Cracks<br>(0.012 - 0.05 inches wide)        | Most of the panels have mid- to full-span vertical cracks on the wall face from the roadway upwards. The cracks are approximately at midspan of the panels.<br><br>There is a longitudinal crack at mid-height of the coping. |
| Wide Cracks<br>(cracks > 0.05 inches wide)           | None noted.   |

PIN 5512.52 Kensington Expressway  
 Retaining Wall #4 (RT) along 33WB between Northampton St and Utica St

| Additional Concrete Distress: |  |
|-------------------------------|--|
| DEFECT                        | DESCRIPTION  |
| Spalling / Delamination       | <p>There is one small spall on panel 409.</p> <p>The bottom wall panel is delaminated over 70%-100% of the area. The second panel is delaminated over 10%-50%.</p> <p>The concrete is delaminated approximately 1 ft wide on either side of each vertical crack over 50%-100% of its length.</p> <p>Around 20% of the backside of the coping is spalled and delaminated.</p> |
| Staining                      | There are isolated areas of rust staining on the bottom panel, in the chamfer between the two bottom panels, and on the rail coping.   |
| Exposed Rebar                 | The backside of the coping has spalls with exposed rebar.  |

**Notes:**

RW 4 consists of 18 panels numbered from 401 (South) to 418 (North). The retaining wall supports the S.B. Humboldt Parkway above State Route 33 (Kensington Expressway).

Located along the right side of the on-ramp from S.B. Humboldt Parkway and extending to retaining wall 10 (Approximately 521 ft. long, 17.5 ft. maximum exposed height).

**INVENTORY, INSPECTION, AND DATA COLLECTION**

| Element                       | Total Qty | Units | Condition State |      |      |        |
|-------------------------------|-----------|-------|-----------------|------|------|--------|
|                               |           |       | 1               | 2    | 3    | 4      |
|                               |           |       | GOOD            | FAIR | POOR | SEVERE |
| RW.01 - Entire Wall           | 1         | Each  | 0.80            | 0.04 | 0.16 |        |
| RW.02 - Wall Facing           | 5661      | SF    | 4345            | 245  | 1071 |        |
| RW.03 - Ground Surface, Front | 521       | FT    | 521             |      |      |        |
| RW.04 - Ground Surface, Back  | 521       | FT    | 521             |      |      |        |
| RW.05 - Weep Holes            | N/A       | Each  | ---             | ---  | ---  | ---    |
| 800 – Scour                   | N/A       | FT    | ---             | ---  | ---  | ---    |

PIN 5512.52 Kensington Expressway  
Retaining Wall #4 (RT) along 33WB between Northampton St and Utica St

#### INSPECTION RESULTS/ RECOMMENDATIONS

- **Overall Condition State Recommendation: 2 - FAIR**
- PROJECT DOCUMENTATION CAN BE FOUND IN THE ATTACHED SECTIONS

PIN 5512.52 Kensington Expressway  
Retaining Wall #4 (RT) along 33WB between Northampton St and Utica St

## Inspection Photos

# PIN 5512.52 – NY33 RETAINING WALL CONDITION EVALUATION 2023 FIELD INSPECTION SUMMARY

Retaining Wall #4 (RT) along 33WB between Northampton St and Utica St



PHOTO 1  
PANEL 401-402  
Description:  
Start of RW4. Connects to RW10.  
Bottom 2 panels are 80% to 100% delaminated with map cracking and some rust staining. Map cracking extends into bottom 4 panels near joints.



PHOTO 2  
PANEL 404  
Description:  
Bottom panel is delaminated 70% with map cracking and scattered rust stains. Second panel from bottom is 15% delaminated.  
There is a 12' high crack around midspan, with delamination 1.5' wide.  
Conditions are similar for panel 403.

# PIN 5512.52 – NY33 RETAINING WALL CONDITION EVALUATION 2023 FIELD INSPECTION SUMMARY

Retaining Wall #4 (RT) along 33WB between Northampton St and Utica St



PHOTO 3  
PANEL 405  
Description:  
Full-height crack with efflorescence. Map cracking on 1.5' either side for full height. Delaminated on either side for bottom 9'.  
Bottom panel has map cracking and 50% delamination. Delamination extends into second panel near left joint.



PHOTO 4  
PANEL 407  
Description:  
Map cracking and delamination on bottom panel, more concentrated at rebar locations. A few vertical cracks extend into the second and third panels with delamination on either side.  
Map cracking on the rail coping is typical for about half of the panels on RW4.

# PIN 5512.52 – NY33 RETAINING WALL CONDITION EVALUATION 2023 FIELD INSPECTION SUMMARY

Retaining Wall #4 (RT) along 33WB between Northampton St and Utica St



PHOTO 5  
PANEL 409  
Map cracking on bottom panel and coping with scattered rust stains. Map cracking extends full height near the left joint. There is a 4' wide area of map cracking in the second panel from the top.  
To the left of the map cracking, there is a 12' high vertical crack with 1' wide delamination on the bottom 3 panels.  
Bottom panel is 100% delaminated with a small spall.

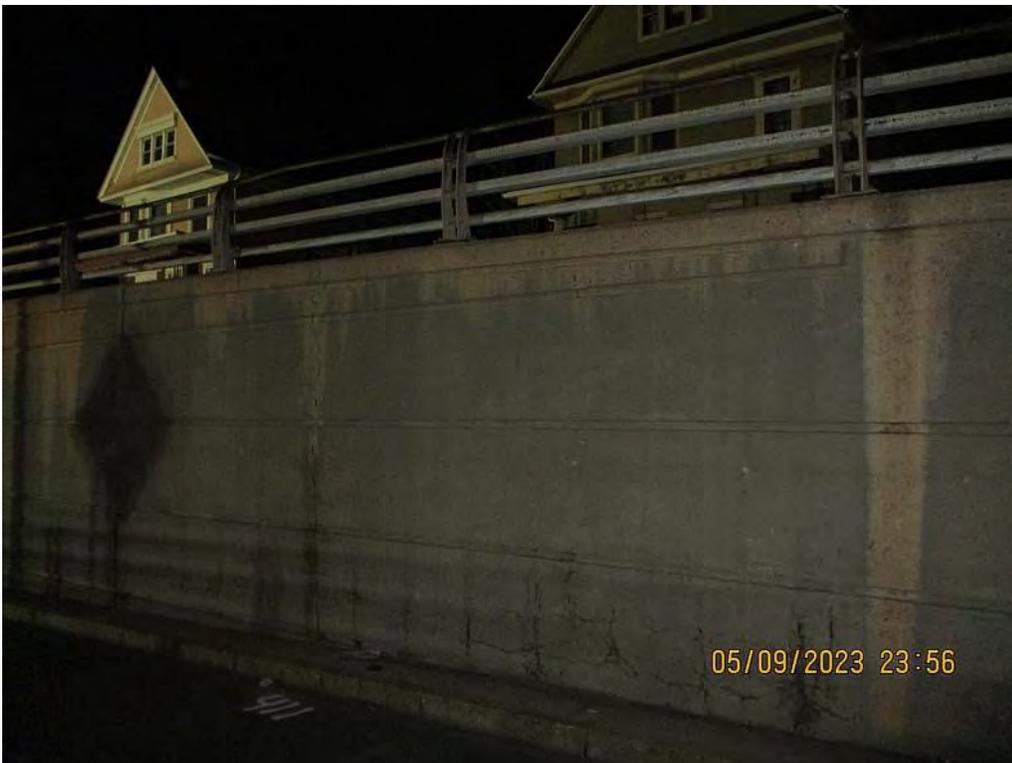


PHOTO 6  
PANEL 411  
Description:  
Map cracking and 75% delamination on bottom panel.  
Full-height crack with 1' wide delamination at 10' from left joint.

# PIN 5512.52 – NY33 RETAINING WALL CONDITION EVALUATION 2023 FIELD INSPECTION SUMMARY

Retaining Wall #4 (RT) along 33WB between Northampton St and Utica St



PHOTO 7  
PANEL 413  
Description:  
Map cracking on bottom 2 panels and coping.  
Rust staining and delamination on bottom panel.  
Panel 412 is similar, without rust stains.



PHOTO 8  
PANEL 415  
Description:  
Scattered map cracking on bottom panel and coping.  
Two full height cracks with 2' wide delamination and minor efflorescence.  
Conditions similar for panel 414.

# PIN 5512.52 – NY33 RETAINING WALL CONDITION EVALUATION 2023 FIELD INSPECTION SUMMARY

Retaining Wall #4 (RT) along 33WB between Northampton St and Utica St



PHOTO 9

PANEL 417

Description:

Map cracking and rust staining throughout, heaviest near rail posts.



PHOTO 10

PANEL 418

Description:

End of RW4.

Heavy map cracking throughout.

# PIN 5512.52 – NY33 RETAINING WALL CONDITION EVALUATION 2023 FIELD INSPECTION SUMMARY

Retaining Wall #4 (RT) along 33WB between Northampton St and Utica St



**PHOTO 11**  
Rail Coping (Backside) along Humbolt Parkway



**Description:**  
There is a longitudinal crack at mid-height of the coping for the entire length of the wall.  
The coping is 20% delaminated.  
Spalls with exposed rebar are present over 20% of the area.

PIN 5512.52 Kensington Expressway  
Retaining Wall #4 (RT) along 33WB between Northampton St and Utica St

# Field Sheets

FILE NAME = \\06cashlab\06\02150716.01 kensington Preliminary Design\Drawings\Highway\Plan\set2\0551252\_cph\_pin\_1ftA.dgn  
 DATE = 2/7/2023  
 TIME = 12:56:26 PM

PROJECT MANAGER  
 CHECK  
 DRAFTING  
 CHECK  
 DESIGN  
 JOB MANAGER  
 DESIGN SUPERVISOR

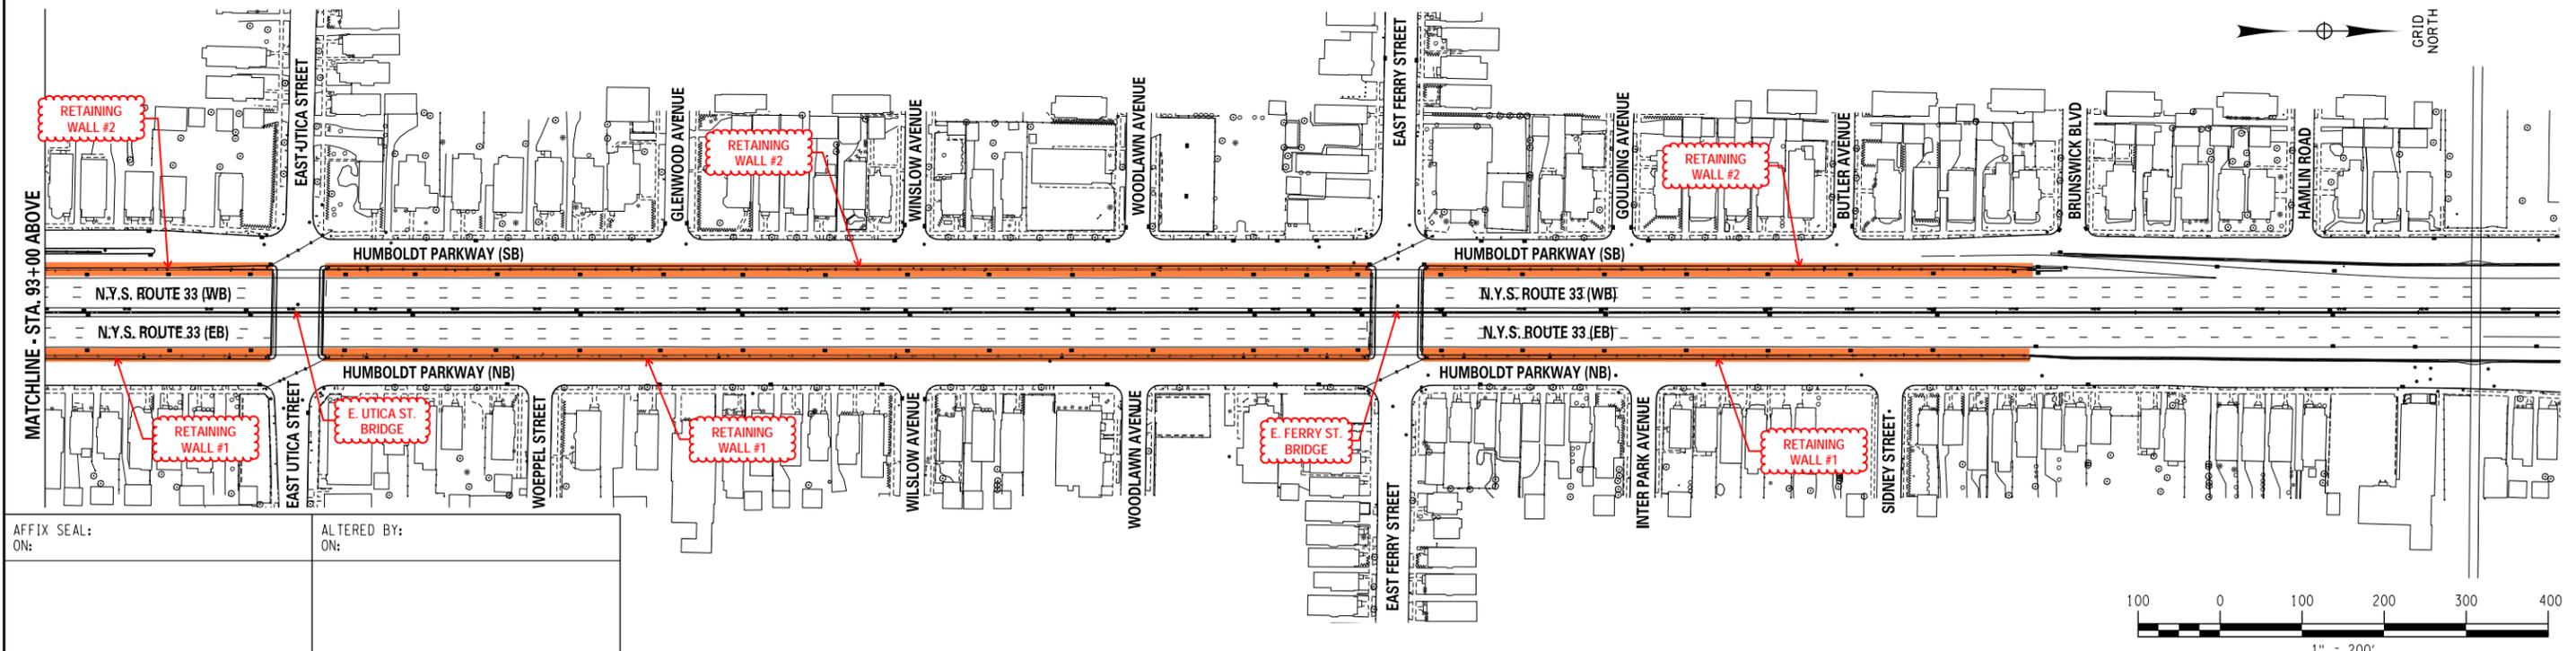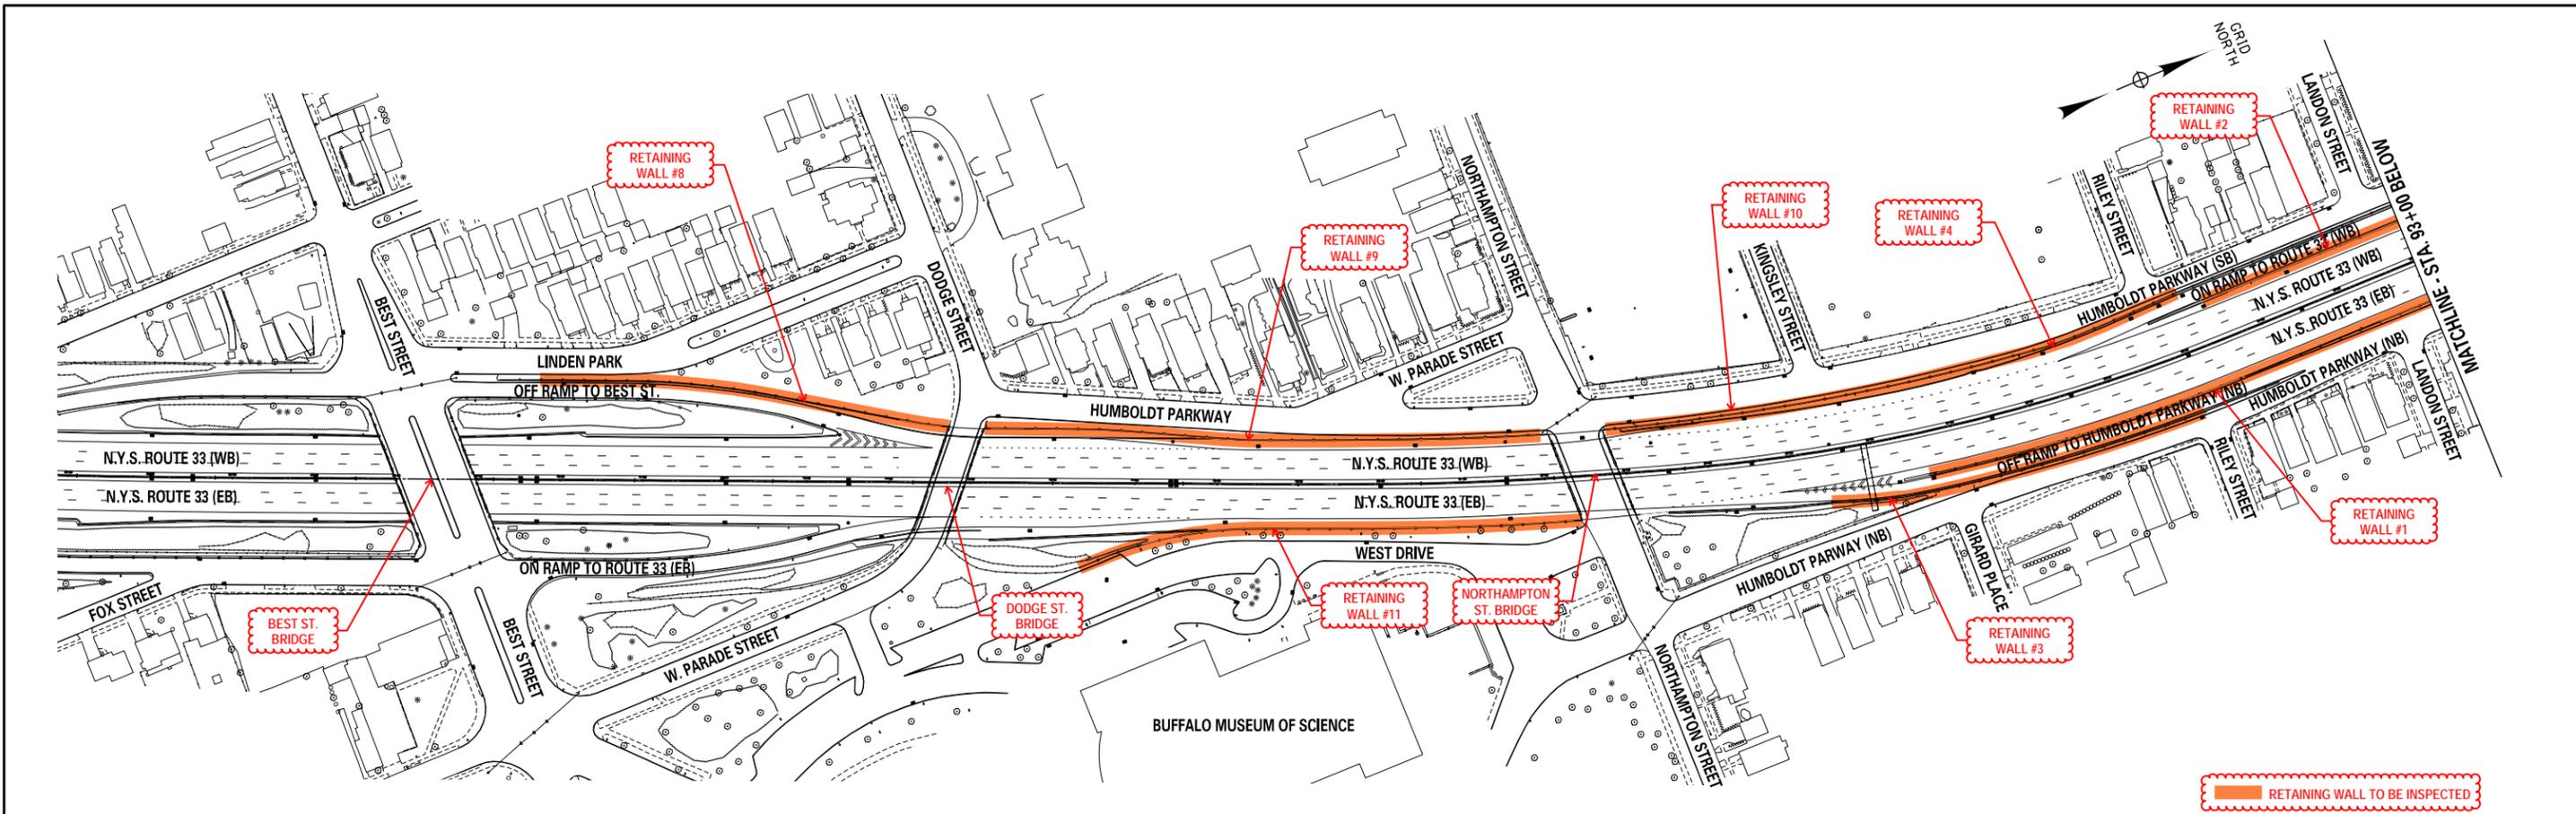

AFFIX SEAL:  
ON:

ALTERED BY:  
ON:


|   |                       |             |         |          |   |                 |
|---|-----------------------|-------------|---------|----------|---|-----------------|
| AS-BUILT REVISIONS<br>DESCRIPTION OF ALTERATIONS: | STATE ROUTE 33        | PIN 5512.52 | BRIDGES | CULVERTS | ALL DIMENSIONS IN FT UNLESS OTHERWISE NOTED                         | CONTRACT NUMBER |
|   | KENSINGTON EXPRESSWAY |             |         |          |   |                 |
|   | CITY OF BUFFALO       |             |         |          | <b>KENSINGTON EXPRESSWAY</b><br><b>RETAINING WALL LOCATION PLAN</b> | DRAWING NO. 1   |
|   | COUNTY: ERIE          | REGION: 5   |         |          |   | SHEET NO.       |

IT IS A VIOLATION OF LAW FOR ANY PERSON, UNLESS THEY ARE ACTING UNDER THE DIRECTION OF A LICENSED PROFESSIONAL ENGINEER, ARCHITECT, LANDSCAPE ARCHITECT, OR LAND SURVEYOR, TO ALTER AN ITEM IN ANY WAY. IF AN ITEM BEARING THE STAMP OF A LICENSED PROFESSIONAL IS ALTERED, THE ALTERING ENGINEER, ARCHITECT, LANDSCAPE ARCHITECT, OR LAND SURVEYOR SHALL STAMP THE DOCUMENT AND INCLUDE THE NOTATION "ALTERED BY" FOLLOWED BY THEIR SIGNATURE, THE DATE OF SUCH ALTERATION, AND A SPECIFIC DESCRIPTION OF THE ALTERATION.

▨ delaminated


- Map crack bot 2 pnls, bot 4 near joints
- Rust staining b/w bot 2 pnls

Scattered map cracking bot pnl

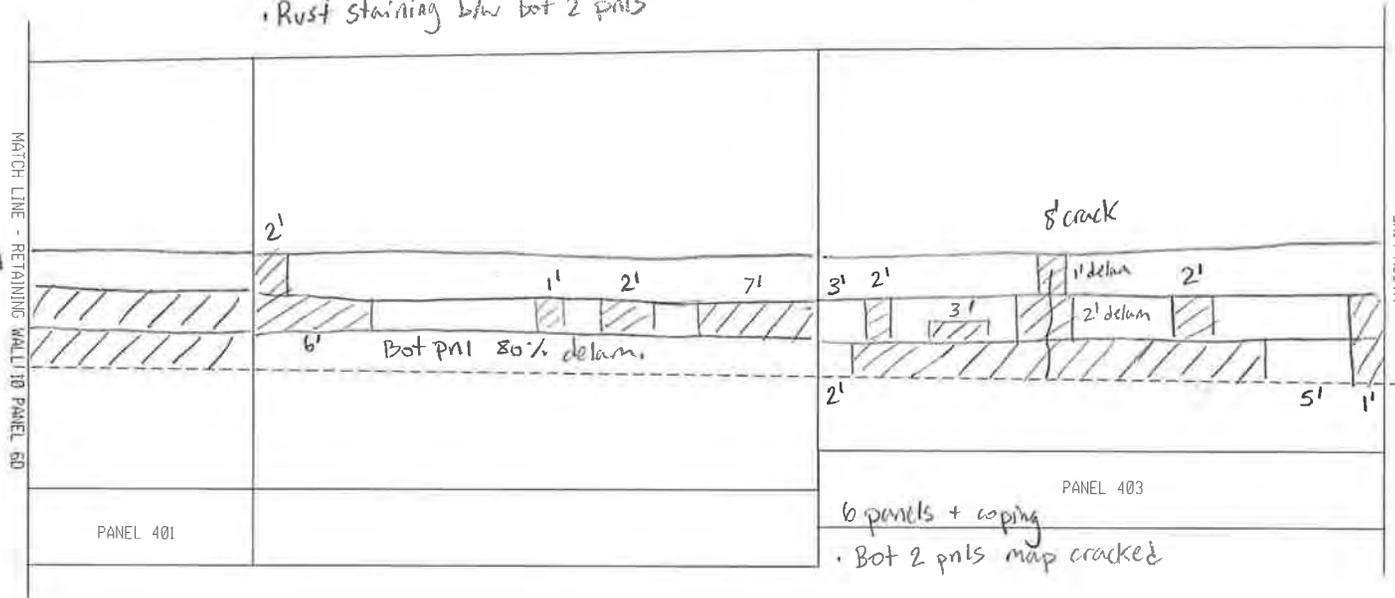

full height crack

Map cracking 1.5' either side of crack


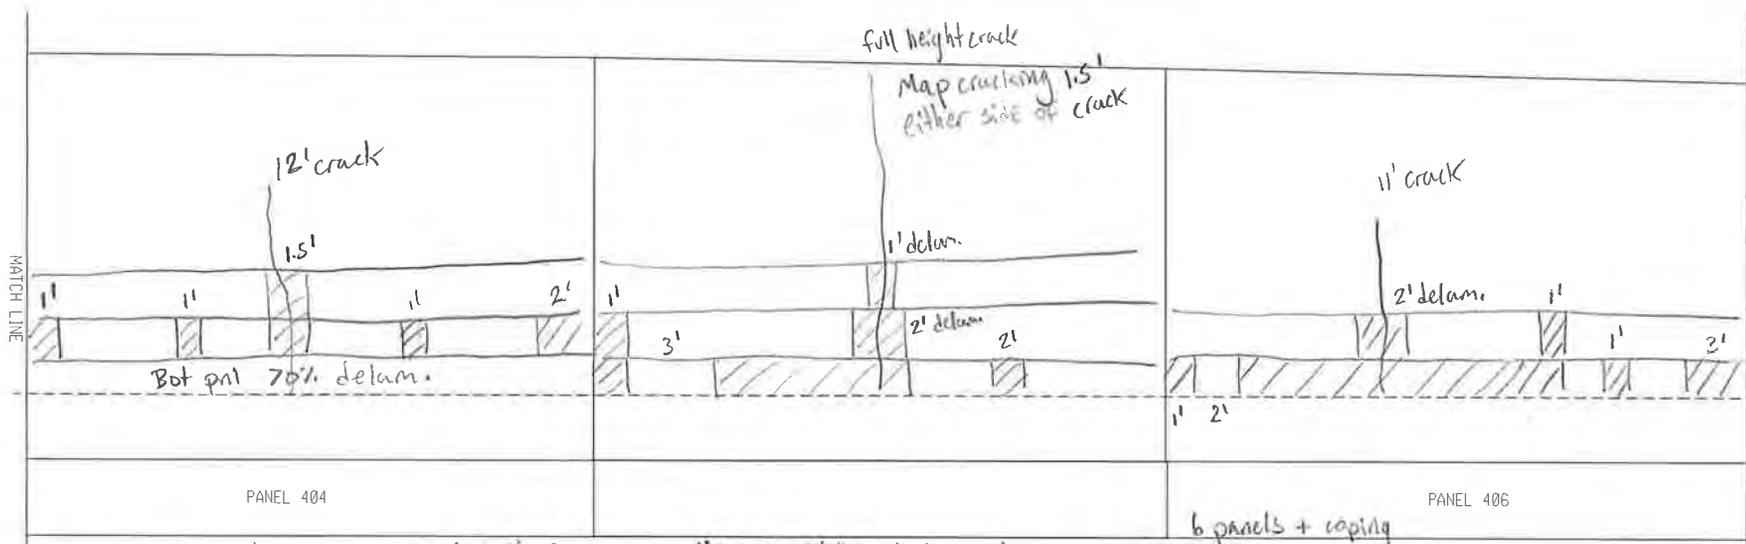


Map cracking bot pnl, scattered rust stain

Map cracking bot pnl

Map cracking bot pnl + coping

 RW 4 PANELS 401-406

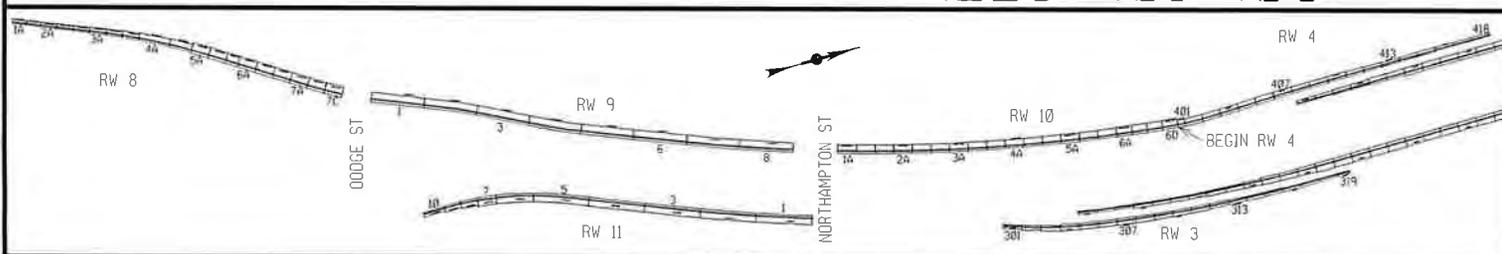


BY: RIM  
 DATE: 5/9/23  
 SCALE: 1" = 10'



- Map cracking bot 2 panels + coping
- Rust staining bot panel
- Bot panel 100% delam.


- Scattered map cracking on bot 2 panels, worst near joints

- Map cracking on coping
- Scattered map cracking on bot panel

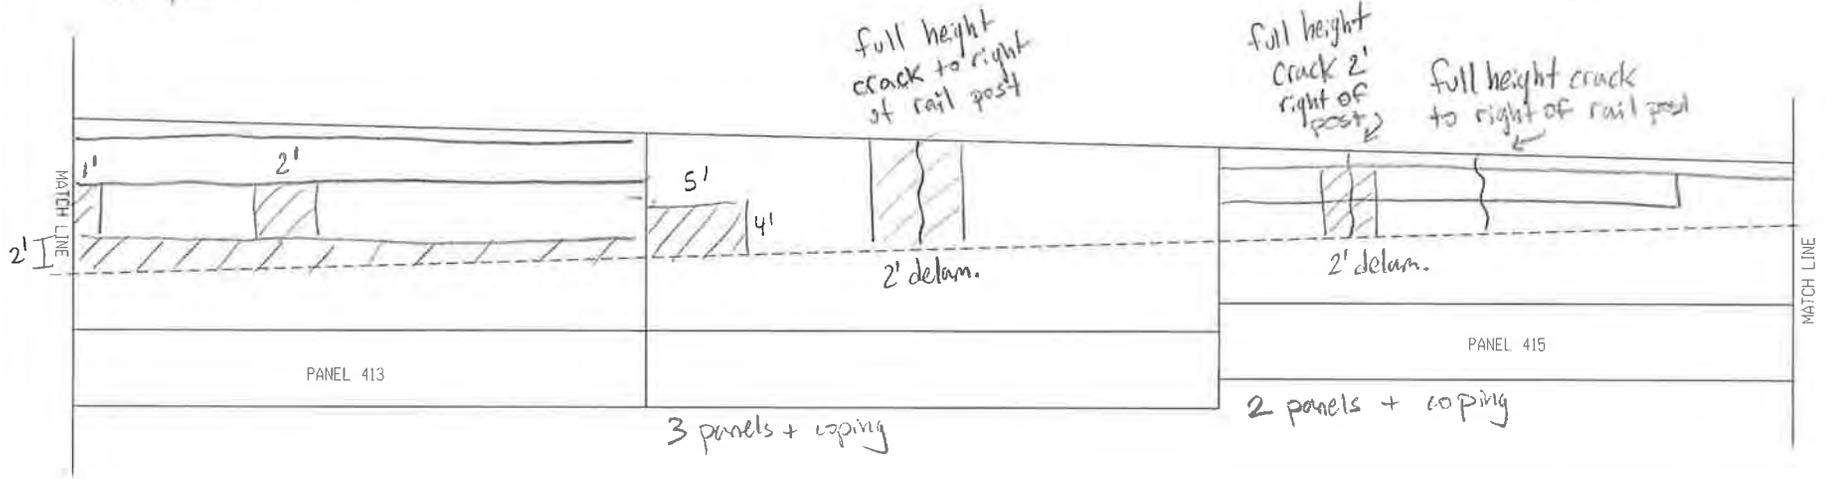

3 panels + coping


2 panels + coping

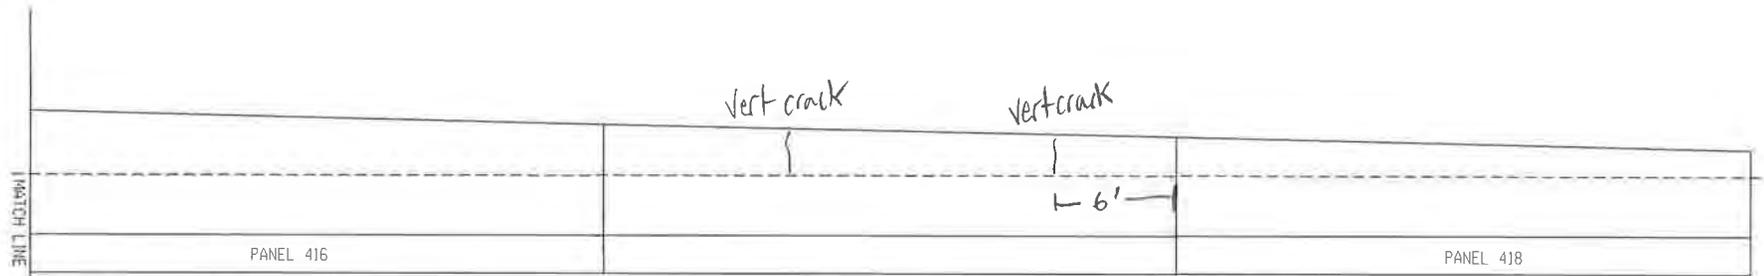


- Longit. crack on coping + map cracking
- Map cracking under rail posts to ground

Map cracking

Map cracking

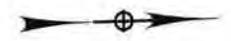

### RW 4 PANELS 413-418

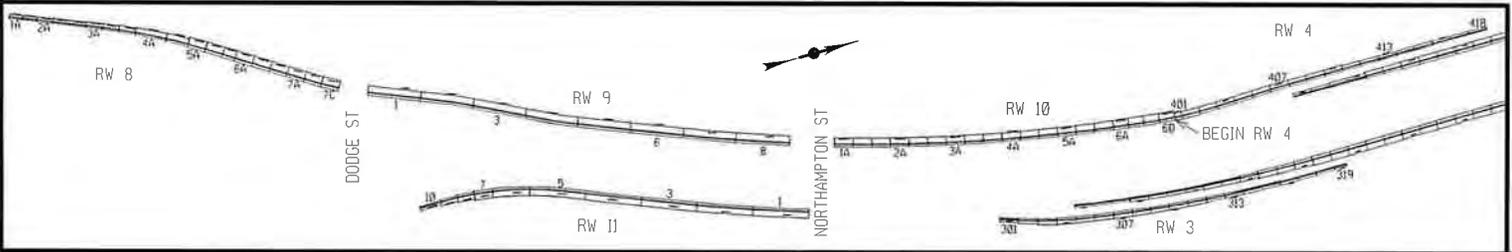

BY: RIM  
 DATE: 5/9/23  
 SCALE: 1" = 10'

## Retaining Wall Coping Inspection 5/30/2023

### Retaining Wall 4

- Mid-height coping crack for entire length
- Spalling 20% with rebar exposure, Delam 20%
- Map cracking at rail posts with staining and efflorescence.

### General WB:

- Granite curb joints are gapped and curb misaligned

PIN 5512.52 Kensington Expressway  
Retaining Wall #4 (RT) along 33WB between Northampton St and Utica St

## Calculations



300 State Street, Suite 201 • Rochester, NY 14614  
 Phone 585.454.6110 • Fax 585.454.3066  
 www.labellapc.com

PROJECT  
 PIN

|                        |          |     |           |
|------------------------|----------|-----|-----------|
| Kensington Inspections |          |     |           |
| 5512.52                | CALC. BY | RIM | DATE      |
|                        |          |     | 5/26/2023 |

Condition Estimates

- Retaining Wall 4
  - Condition 2 - map cracks, stains, isolated delam, minor cracks
  - Condition 3 - spalls, widespread delam, major cracks
  - Areas with multiple forms of deterioration were measured under only one category. Condition 3 categories were prioritized over condition 2.

| Panel              | Minor/Map Crack (sf) | Major Cracks (ft) | Spalls (sf) | Widespread Delam (sf) | Isolated Delam | Other (staining, efflor., etc.) |               |               |
|--------------------|----------------------|-------------------|-------------|-----------------------|----------------|---------------------------------|---------------|---------------|
| 401                |                      |                   |             | 72                    |                |                                 |               |               |
| 402                |                      |                   |             | 126                   |                |                                 |               |               |
| 403                |                      |                   |             | 102                   |                |                                 |               |               |
| 404                |                      | 3                 |             | 84                    |                |                                 |               |               |
| 405                |                      | 9                 |             | 57                    |                |                                 |               |               |
| 406                |                      | 5                 |             | 81                    |                |                                 |               |               |
| 407                |                      |                   |             | 112.5                 |                |                                 |               |               |
| 408                | 21                   | 9                 |             | 75                    |                |                                 |               |               |
| 409                | 40                   | 5                 | 1           | 114                   |                |                                 |               |               |
| 410                | 18                   |                   |             | 36                    |                |                                 |               |               |
| 411                |                      |                   |             | 78                    |                |                                 |               |               |
| 412                | 21.5                 |                   |             | 42                    |                |                                 |               |               |
| 413                | 30                   |                   |             | 69                    |                |                                 |               |               |
| 414                | 18.4                 |                   |             |                       | 30             |                                 |               |               |
| 415                | 12                   | 6                 |             |                       | 12             |                                 |               |               |
| 416                | 18                   |                   |             |                       |                |                                 |               |               |
| 417                | 12                   | 5                 |             |                       |                |                                 |               |               |
| 418                | 12                   |                   |             |                       |                |                                 |               |               |
| <b>Total (sf):</b> | 202.90               | 21.00             | 1.00        | 1048.50               | 42.00          | 0.00                            | <b>COND 2</b> | <b>COND 3</b> |
|                    |                      | (sf)              |             |                       |                |                                 | 245           | 1071          |

PIN 5512.52 Kensington Expressway  
Retaining Wall #4 (RT) along 33WB between Northampton St and Utica St

# Wall Inventory Sheet

## INVENTORY, INSPECTION, AND DATA COLLECTION

|                                  |  | WALL INSPECTION LOCATION INFORMATION & NOTES |
|----------------------------------|--|--|
| PRIMARY OWNER                    | NYS DOT - New York State Department of Transportation  |  |
| REGION                           | 05-Region 05 - Buffalo   |  |
| COUNTY                           | 3-County 3 - Erie  |  |
| RESIDENCY                        | 534 - Erie North Residency   |  |
| NYS ROUTE                        | Rte. 33  |  |
| REFERENCE MARKER                 | 3353011031   |  |
| LONGITUDE                        | 78.84369   |  |
| LATITUDE                         | 42.91034   |  |
| ADDITIONAL LOCATION DESCRIPTION  | Located along the on-ramp right shoulder from S.B. Humboldt Parkway to W.B. Kensington Expressway (approximately 521 ft. long, 17.5 ft. maximum exposed height). The west abutment of the Northampton Street Overpass is not considered as part of RW #10. |  |
| TYPE OF SERVICE PROVIDED         | Support/Protect a Roadway  |  |
| WALL TYPE                        | Cantilever - Concrete  |  |
| LEGACY RETAINING WALL TYPE       |  |  |
| WALL FACING TYPE                 | Cast - in -Place Concrete  |  |
| WALL BACKFILL REINFORCEMENT TYPE | N/A  |  |
| ADDITIONAL WALL DESCRIPTION      |  |  |
| WALL LENGTH                      | 521 Ft   |  |
| WALL MAXIMUM HEIGHT              | 17.5 Ft  |  |
| WALL AREA                        | 9650 SF  |  |
| YEAR BUILT                       | 1970   |  |
| CONTRACT NUMBER                  | C 68-2   |  |
| AADT                             | 76,347   |  |
| QC REVIEWER                      |  |  |
| QC APPROVED DATE                 |  |  |
| SITE ACCESS NOTES                | With WZTC in place to close the adjacent shoulder and travel lane, access was performed by walking and extension ladder.   |  |
| INSPECTION FREQUENCY             |  |  |
| LAST INSPECTION STATUS           |  |  |
| INSTRUMENTED                     | N/A  |  |
| MONITORED BY                     | ----   |  |
| INSTRUMENTATION COMMENT          | ----   |  |
| CONSEQUENCE OF FAILURE           | 3-Major  |  |
| WALL POSITION                    | Between Roads  |  |
| GENERAL NOTES                    |  |  |
| RETAINING WALL DATABASE ID       |  |  |
| NUMBER OF ERRORS AND WARNINGS    |  |  |
| USER UPDATE                      |  |  |
| SUBMISSION DATE                  |  |  |
| DATE UPDATE                      |  |  |

# PIN 5512.52 – NY33 RETAINING WALL CONDITION EVALUATION 2023 FIELD INSPECTION SUMMARY

STRUCTURE: Retaining Wall #4 (RT) along 33WB between Northampton St and Utica St

STRUCTURE TYPE: Reinforced Concrete Cantilever Wall on Piles (Panels 401-415)  
Reinforced Concrete Cantilever Wall on Spread Footings (Panels 416-418)  
Year Built: 1970

CURRENT INSPECTION: 05/01/23 – 5/09/23 (LaBella Inspections)

LAST KNOWN INSPECTION: Unknown

CONDITION STATE: FAIR

## RETAINING WALL INSPECTION & DOCUMENTATION:

Inspection of the retaining walls will be in conformance with the NYSDOT Retaining Wall Inventory and Inspection Program Manual, October 2018. Inspection of the following elements will be inspected and documented as appropriate:

### - Inspection:

The following procedure will be followed for the inspection of retaining walls:

- Walls were checked for signs of settlement, rotation, or bulging. Walls faces were checked for vertical alignment using a smart level. The walls being evaluated are vertical with no batter.
- Construction joints between sections of the wall were examined for misalignment, and near the ground line for fill material washing out from between panels or joint.
- Walls were inspected for erosion material in front of the wall, for heaving of material in front of the wall, and for settlement of fill behind the wall.
- Examined the wall for deterioration of the material, such as cracking, spalling, and/or corrosion, noting the width, length, depth, and/or orientation of the deterioration. Photographs are provided, documenting defects found.
- Wall façades were reviewed for evidence of water seepage, efflorescence, or rust staining.
- Examined the base of walls for evidence of water flow where the water table may be within the retained earth.
- Examined and probed drains for signs of clogging. Examined drainage around ends of wall and note if embankments have been experiencing erosion.
- Examined site grading for any locations that may prohibit proper drainage from behind the wall looking for evidence of ponding above the wall, such as debris accumulation in the lower spots.
- Ascertain why water is not draining properly and note in the inspection.
- Inspected roadway components above wall for signs of joint separation, potholes, and areas of settlement.
- Examined vegetation growth along and above the wall for root infiltration creating undesirable stresses on the wall. Documented any induce cracking, bulging or failure.
- Examined the wall system for vehicular damage and document the location and degree of damage.

GENERAL OBSERVATIONS:

1. Retaining Wall Panels are generally 30 ft in length with horizontal chamfered panels spaced 3'-0" vertically, from the top of the wall. There is some variation in panel length due to the location of bridges within the corridor. For specific panel lengths see the DOCUMENTION Section of this report.
2. The lower 3-6 ft of the subject retaining wall was found to be in FAIR-POOR condition with extensive map cracking, dampness, isolated rust staining, spalls and widespread delamination. For specific conditions found and photographs of the wall panels, see the DOCUMENTION Section of this report.
3. The upper portions of theses wall panels were generally found to be in GOOD condition with the exception of a very few locations. For specific conditions found and photographs of the wall panels, see the DOCUMENTION Section of this report.
4. Most panels were found to have mid-height to full-height vertical cracks near the midspan of the panel. For specific conditions found, photographs of the of wall panels, and condition calculations see the attached sections of this report.

| General:                    |             |
|-----------------------------|-------------|
| DEFECT                      | DESCRIPTION |
| Misalignment                | None noted. |
| Settlement                  | None noted. |
| Sinkhole (cavity) Formation | None noted. |

| Concrete Cracks:                                     |   |
|--|---|
| DEFECT   | DESCRIPTION   |
| Insignificant Cracks<br>(cracks < 0.012 inches wide) | None noted.   |
| Map cracks   | The bottom 1 to 2 panels (3'-6') are map cracked on all panels. On some panels the map cracking extends higher near the joints and vertical cracks.<br><br>Half of the panels have map cracking on the rail system coping.    |
| Moderate Cracks<br>(0.012 - 0.05 inches wide)        | Most of the panels have mid- to full-span vertical cracks on the wall face from the roadway upwards. The cracks are approximately at midspan of the panels.<br><br>There is a longitudinal crack at mid-height of the coping. |
| Wide Cracks<br>(cracks > 0.05 inches wide)           | None noted.   |

PIN 5512.52 Kensington Expressway  
 Retaining Wall #4 (RT) along 33WB between Northampton St and Utica St

| Additional Concrete Distress: |  |
|-------------------------------|--|
| DEFECT                        | DESCRIPTION  |
| Spalling / Delamination       | <p>There is one small spall on panel 409.</p> <p>The bottom wall panel is delaminated over 70%-100% of the area. The second panel is delaminated over 10%-50%.</p> <p>The concrete is delaminated approximately 1 ft wide on either side of each vertical crack over 50%-100% of its length.</p> <p>Around 20% of the backside of the coping is spalled and delaminated.</p> |
| Staining                      | There are isolated areas of rust staining on the bottom panel, in the chamfer between the two bottom panels, and on the rail coping.   |
| Exposed Rebar                 | The backside of the coping has spalls with exposed rebar.  |

**Notes:**

RW 4 consists of 18 panels numbered from 401 (South) to 418 (North). The retaining wall supports the S.B. Humboldt Parkway above State Route 33 (Kensington Expressway).

Located along the right side of the on-ramp from S.B. Humboldt Parkway and extending to retaining wall 10 (Approximately 521 ft. long, 17.5 ft. maximum exposed height).

**INVENTORY, INSPECTION, AND DATA COLLECTION**

| Element                       | Total Qty | Units | Condition State |      |      |        |
|-------------------------------|-----------|-------|-----------------|------|------|--------|
|                               |           |       | 1               | 2    | 3    | 4      |
|                               |           |       | GOOD            | FAIR | POOR | SEVERE |
| RW.01 - Entire Wall           | 1         | Each  | 0.80            | 0.04 | 0.16 |        |
| RW.02 - Wall Facing           | 5661      | SF    | 4345            | 245  | 1071 |        |
| RW.03 - Ground Surface, Front | 521       | FT    | 521             |      |      |        |
| RW.04 - Ground Surface, Back  | 521       | FT    | 521             |      |      |        |
| RW.05 - Weep Holes            | N/A       | Each  | ---             | ---  | ---  | ---    |
| 800 – Scour                   | N/A       | FT    | ---             | ---  | ---  | ---    |

PIN 5512.52 Kensington Expressway  
Retaining Wall #4 (RT) along 33WB between Northampton St and Utica St

#### INSPECTION RESULTS/ RECOMMENDATIONS

- **Overall Condition State Recommendation: 2 - FAIR**
- PROJECT DOCUMENTATION CAN BE FOUND IN THE ATTACHED SECTIONS

PIN 5512.52 Kensington Expressway  
Retaining Wall #4 (RT) along 33WB between Northampton St and Utica St

## Inspection Photos

# PIN 5512.52 – NY33 RETAINING WALL CONDITION EVALUATION 2023 FIELD INSPECTION SUMMARY

Retaining Wall #4 (RT) along 33WB between Northampton St and Utica St



PHOTO 1  
PANEL 401-402  
Description:  
Start of RW4. Connects to RW10.  
Bottom 2 panels are 80% to 100% delaminated with map cracking and some rust staining. Map cracking extends into bottom 4 panels near joints.



PHOTO 2  
PANEL 404  
Description:  
Bottom panel is delaminated 70% with map cracking and scattered rust stains. Second panel from bottom is 15% delaminated.  
There is a 12' high crack around midspan, with delamination 1.5' wide.  
Conditions are similar for panel 403.

# PIN 5512.52 – NY33 RETAINING WALL CONDITION EVALUATION 2023 FIELD INSPECTION SUMMARY

Retaining Wall #4 (RT) along 33WB between Northampton St and Utica St



PHOTO 3  
PANEL 405  
Description:  
Full-height crack with efflorescence. Map cracking on 1.5' either side for full height. Delaminated on either side for bottom 9'.  
Bottom panel has map cracking and 50% delamination. Delamination extends into second panel near left joint.



PHOTO 4  
PANEL 407  
Description:  
Map cracking and delamination on bottom panel, more concentrated at rebar locations. A few vertical cracks extend into the second and third panels with delamination on either side.  
Map cracking on the rail coping is typical for about half of the panels on RW4.

# PIN 5512.52 – NY33 RETAINING WALL CONDITION EVALUATION 2023 FIELD INSPECTION SUMMARY

Retaining Wall #4 (RT) along 33WB between Northampton St and Utica St



PHOTO 5  
PANEL 409  
Map cracking on bottom panel and coping with scattered rust stains. Map cracking extends full height near the left joint. There is a 4' wide area of map cracking in the second panel from the top.  
To the left of the map cracking, there is a 12' high vertical crack with 1' wide delamination on the bottom 3 panels.  
Bottom panel is 100% delaminated with a small spall.

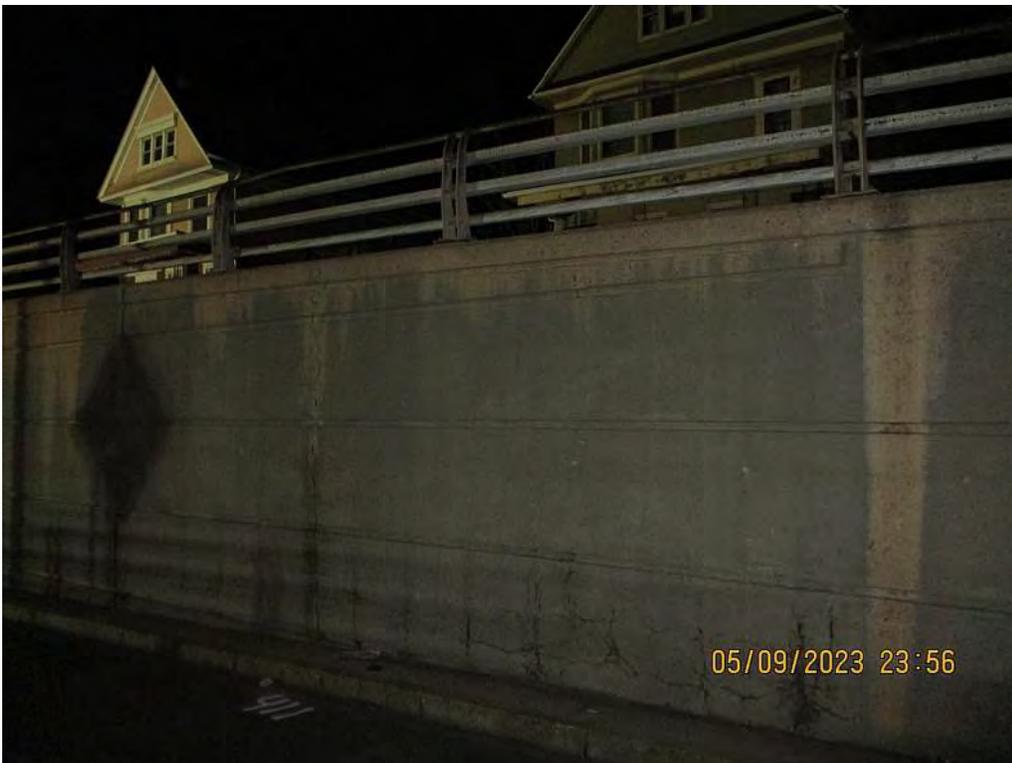


PHOTO 6  
PANEL 411  
Description:  
Map cracking and 75% delamination on bottom panel.  
Full-height crack with 1' wide delamination at 10' from left joint.

# PIN 5512.52 – NY33 RETAINING WALL CONDITION EVALUATION 2023 FIELD INSPECTION SUMMARY

Retaining Wall #4 (RT) along 33WB between Northampton St and Utica St



PHOTO 7  
PANEL 413  
Description:  
Map cracking on bottom 2 panels and coping.  
Rust staining and delamination on bottom panel.  
Panel 412 is similar, without rust stains.



PHOTO 8  
PANEL 415  
Description:  
Scattered map cracking on bottom panel and coping.  
Two full height cracks with 2' wide delamination and minor efflorescence.  
Conditions similar for panel 414.

# PIN 5512.52 – NY33 RETAINING WALL CONDITION EVALUATION 2023 FIELD INSPECTION SUMMARY

Retaining Wall #4 (RT) along 33WB between Northampton St and Utica St



PHOTO 9

PANEL 417

Description:

Map cracking and rust staining throughout, heaviest near rail posts.



PHOTO 10

PANEL 418

Description:

End of RW4.

Heavy map cracking throughout.

# PIN 5512.52 – NY33 RETAINING WALL CONDITION EVALUATION 2023 FIELD INSPECTION SUMMARY

Retaining Wall #4 (RT) along 33WB between Northampton St and Utica St



**PHOTO 11**  
**Rail Coping (Backside) along Humbolt Parkway**



**Description:**  
There is a longitudinal crack at mid-height of the coping for the entire length of the wall.  
The coping is 20% delaminated.  
Spalls with exposed rebar are present over 20% of the area.

PIN 5512.52 Kensington Expressway  
Retaining Wall #4 (RT) along 33WB between Northampton St and Utica St

## Field Sheets

FILE NAME = \\06cashlab\06\02150716.01 kensington Preliminary Design\Drawings\Highway\Plan\set2\0551252\_cph\_pin\_1ftA.dgn  
 DATE = 2/7/2023  
 TIME = 12:56:26 PM

PROJECT MANAGER  
 CHECK  
 DRAFTING  
 CHECK  
 DESIGN  
 JOB MANAGER  
 DESIGN SUPERVISOR

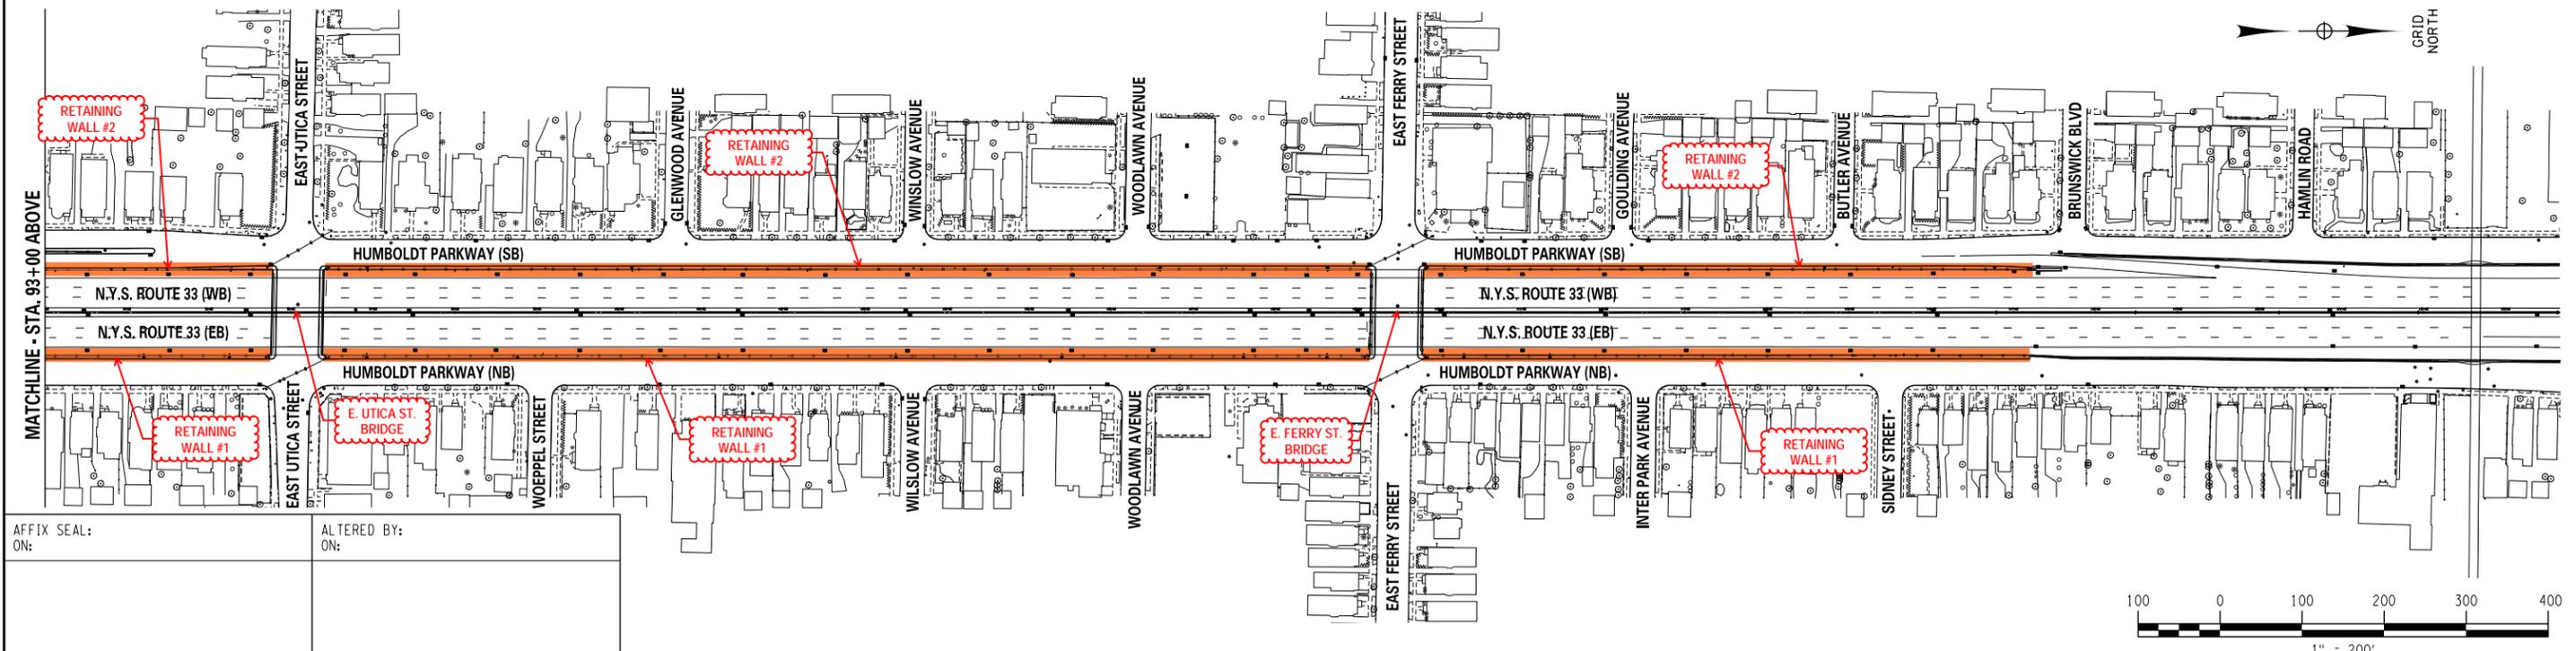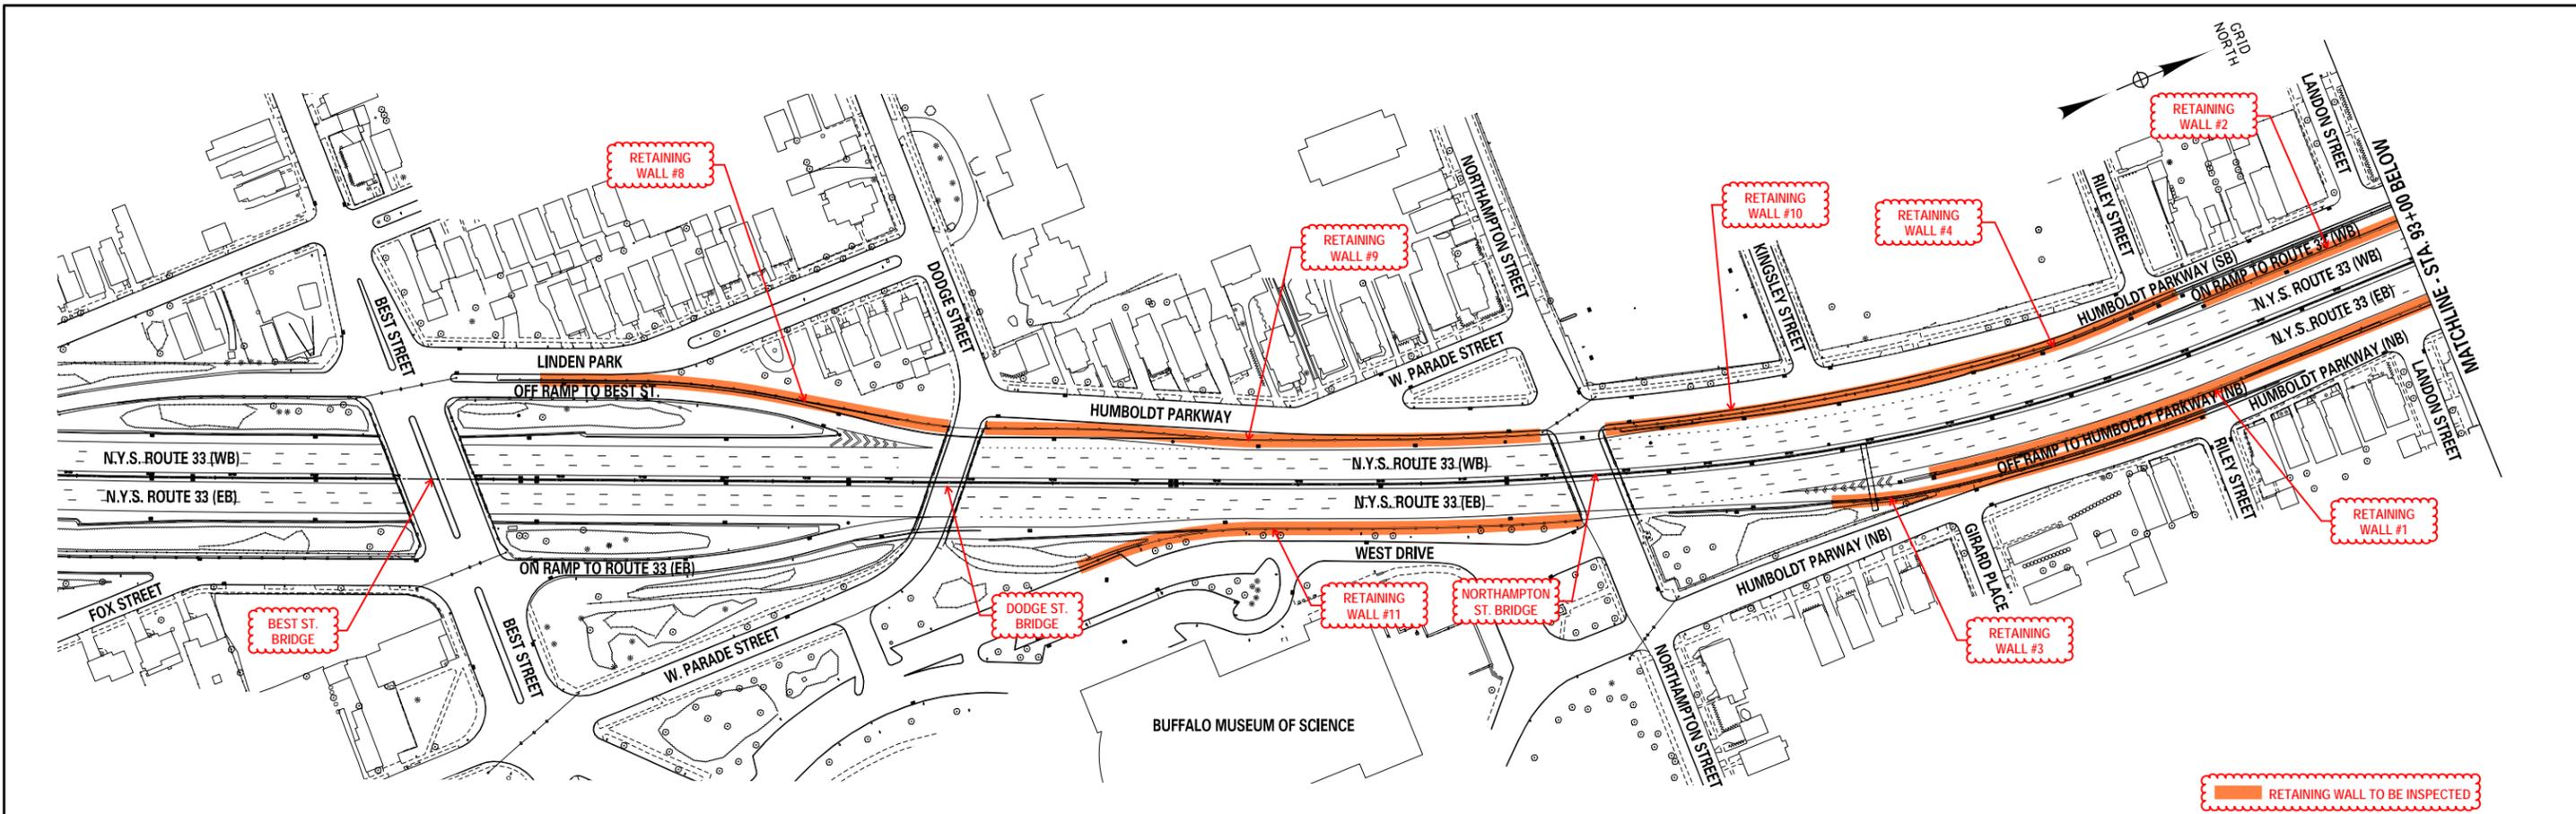


|                    |                    |
|--------------------|--------------------|
| AFFIX SEAL:<br>ON: | ALTERED BY:<br>ON: |
|--------------------|--------------------|

|  |                       |             |         |          |   |                             |                                  |
|--|-----------------------|-------------|---------|----------|---|-----------------------------|----------------------------------|
| AS-BUILT REVISIONS<br>DESCRIPTION OF ALTERATIONS:  | STATE ROUTE 33        | PIN 5512.52 | BRIDGES | CULVERTS | ALL DIMENSIONS IN FT UNLESS OTHERWISE NOTED | CONTRACT NUMBER             |                                  |
|  | KENSINGTON EXPRESSWAY |             |         |          |   |                             |                                  |
|  | CITY OF BUFFALO       |             |         |          |   |                             |                                  |
|  | COUNTY: ERIE          |             |         |          |   |                             | REGION: 5                        |
| <b>KENSINGTON EXPRESSWAY<br/>       RETAINING WALL LOCATION PLAN</b>   |                       |             |         |          |   | DRAWING NO. 1<br>SHEET NO.  |                                  |
| IT IS A VIOLATION OF LAW FOR ANY PERSON, UNLESS THEY ARE ACTING UNDER THE DIRECTION OF A LICENSED PROFESSIONAL ENGINEER, ARCHITECT, LANDSCAPE ARCHITECT, OR LAND SURVEYOR, TO ALTER AN ITEM IN ANY WAY. IF AN ITEM BEARING THE STAMP OF A LICENSED PROFESSIONAL IS ALTERED, THE ALTERING ENGINEER, ARCHITECT, LANDSCAPE ARCHITECT, OR LAND SURVEYOR SHALL STAMP THE DOCUMENT AND INCLUDE THE NOTATION "ALTERED BY" FOLLOWED BY THEIR SIGNATURE, THE DATE OF SUCH ALTERATION, AND A SPECIFIC DESCRIPTION OF THE ALTERATION. |                       |             |         |          |   | <br>Powered by partnership. | <br>Department of Transportation |

▨ delaminated


- Map crack bot 2 pnls, bot 4 near joints
- Rust staining b/w bot 2 pnls

Scattered map cracking bot pnl

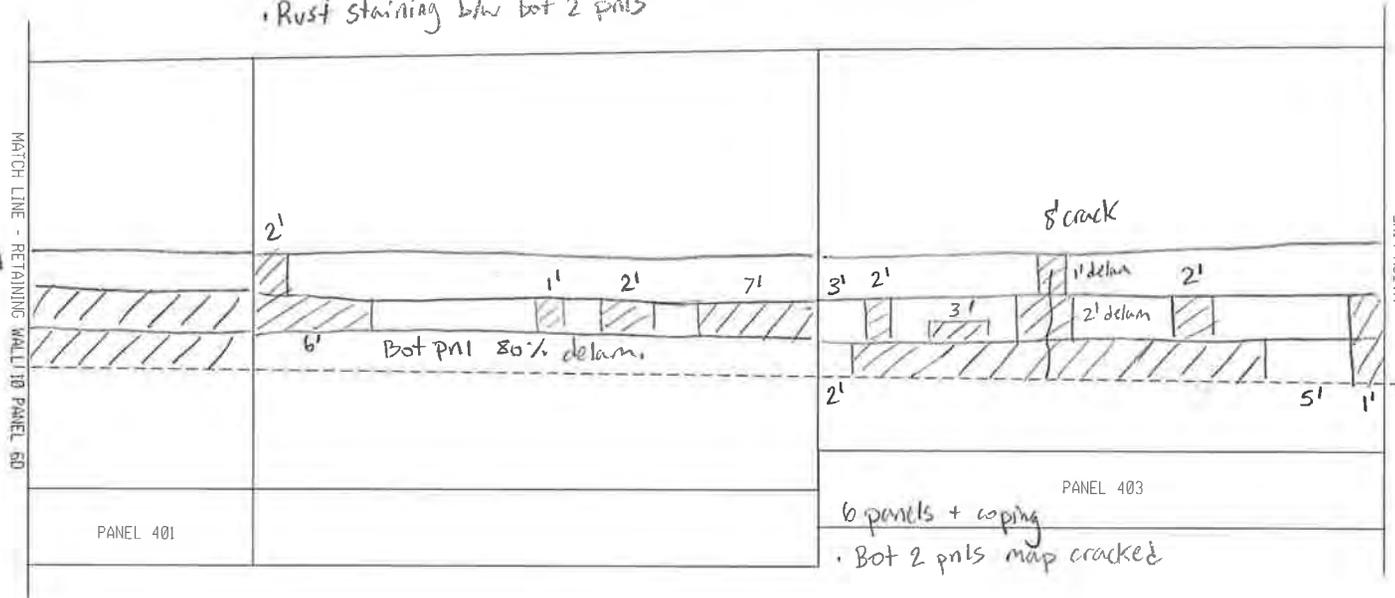

full height crack

Map cracking 1.5' either side of crack

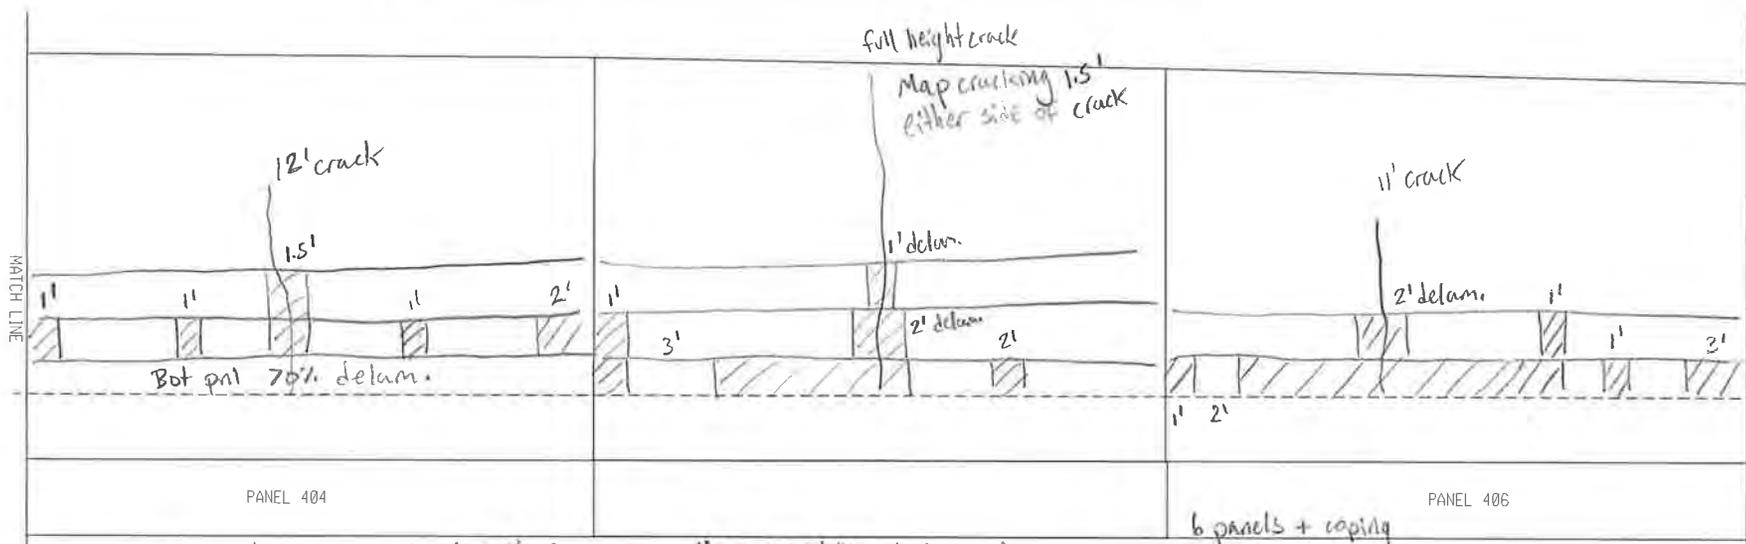


Map cracking bot pnl, scattered rust stain

Map cracking bot pnl

Map cracking bot pnl + coping

RW 4 PANELS 401-406

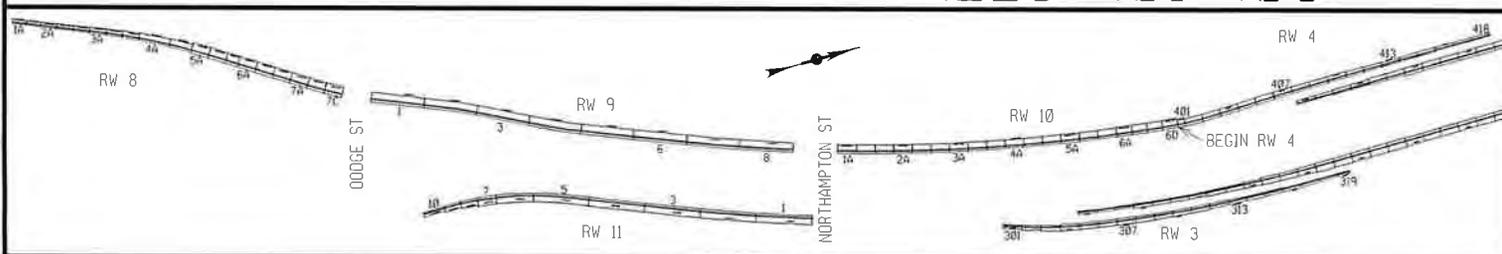


BY: RIM

DATE: 5/9/23


SCALE: 1" = 10'

• Bot pnl 100% delam. scattered rust stains

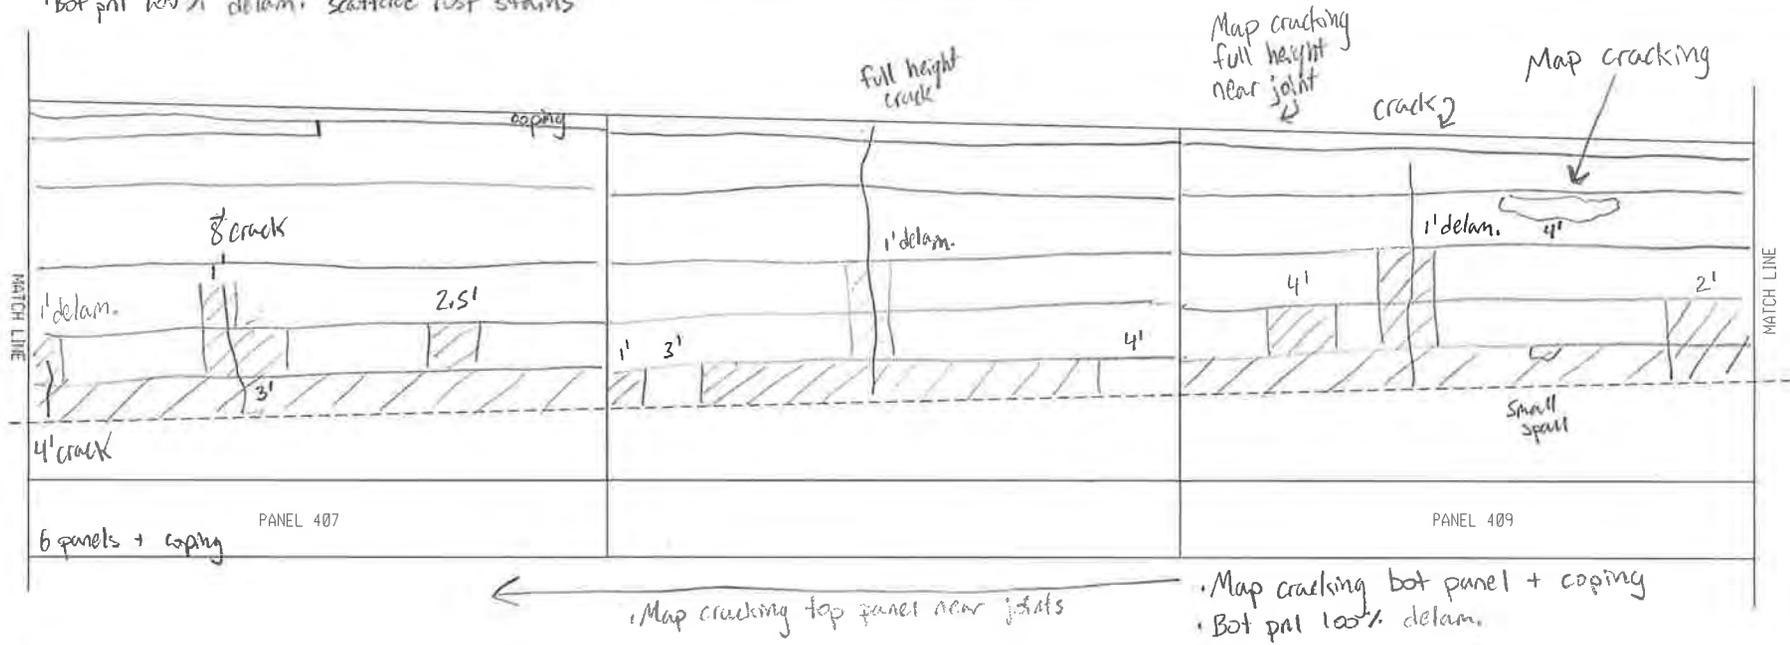

← Map cracking top panel near joints

• Map cracking bot panel + coping  
• Bot pnl 100% delam.


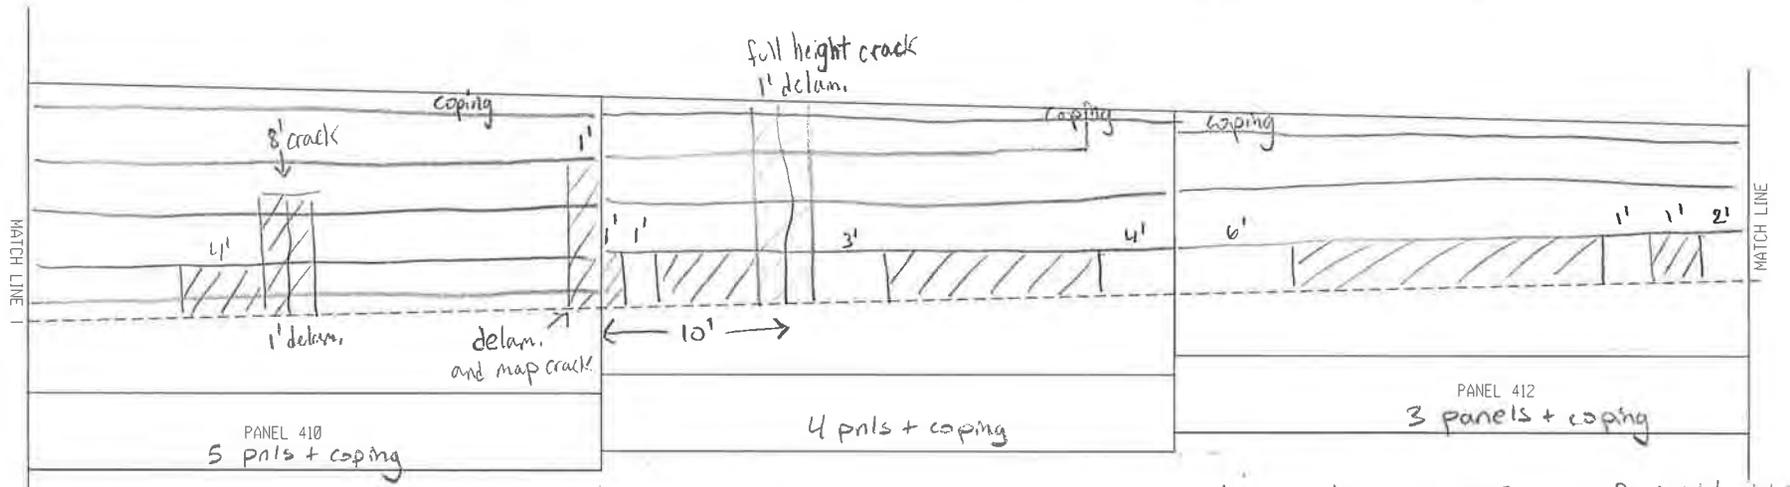


scattered map cracking bot 2 panels + coping

Map cracking bot panel

• Map cracking bot 1.5 pnls, full height at joints

RW 4 PANELS 407-412

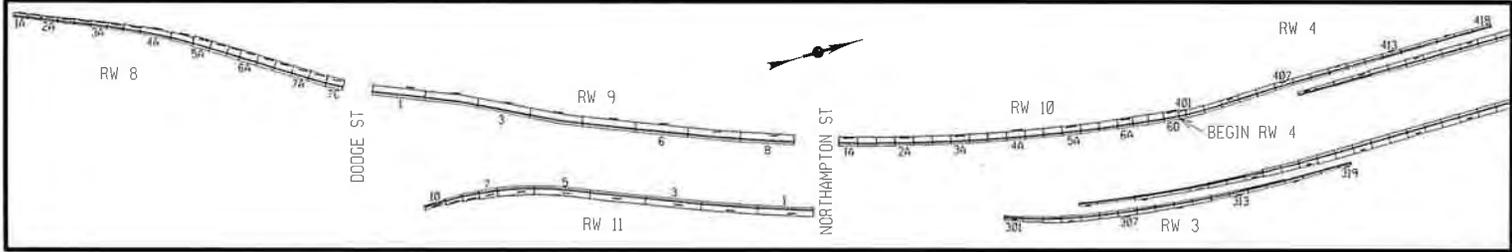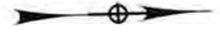

BY: RIM



DATE: 5/9/23

SCALE: 1" = 10'

- Map cracking bot 2 panels + coping
- Rust staining bot panel
- Bot panel 100% delam.

Scattered map cracking on bot 2 panels, worst near joints


- Map cracking on coping
- Scattered map cracking on bot panel

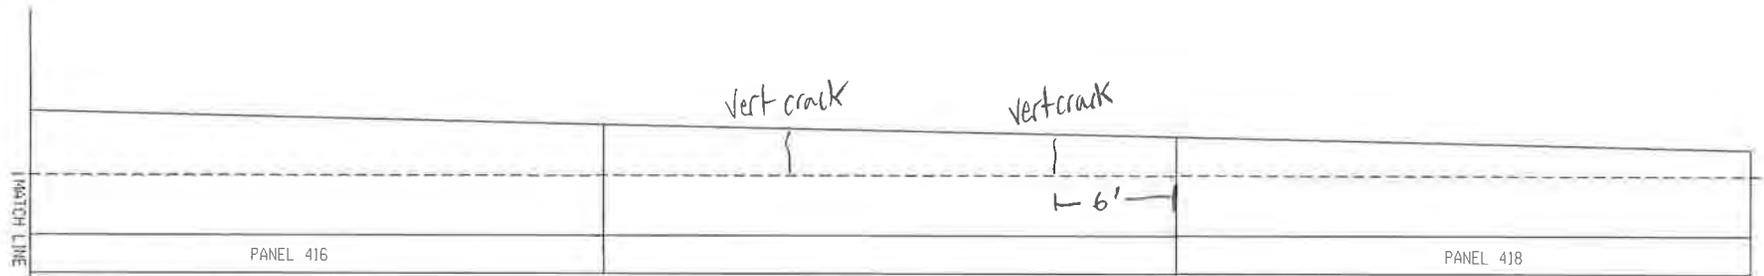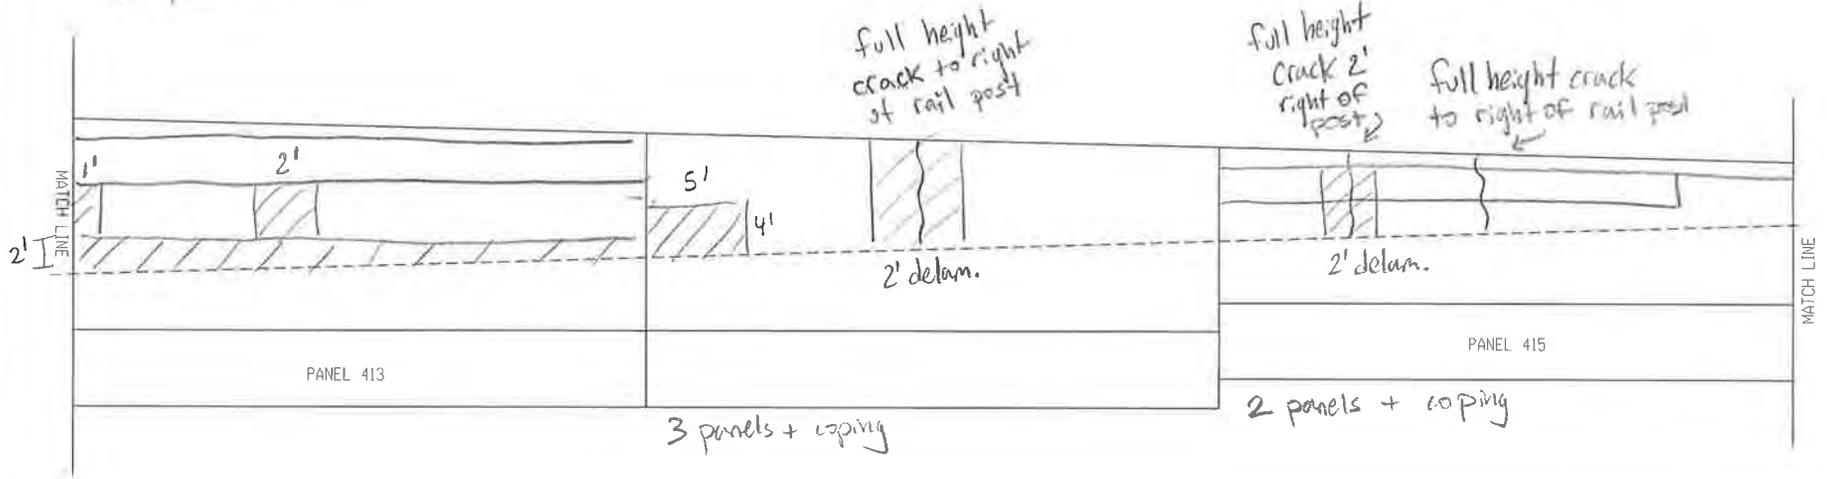


- Longit. crack on coping + map cracking
- Map cracking under rail posts to ground

Map cracking

Map cracking

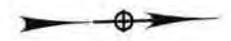

### RW 4 PANELS 413-418

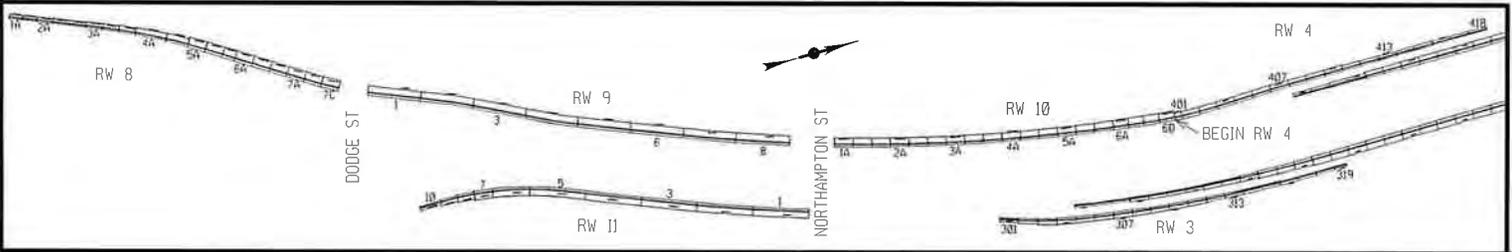

BY: RIM

DATE: 5/9/23

SCALE: 1" = 10'

## Retaining Wall Coping Inspection 5/30/2023

### Retaining Wall 4

- Mid-height coping crack for entire length
- Spalling 20% with rebar exposure, Delam 20%
- Map cracking at rail posts with staining and efflorescence.

### General WB:

- Granite curb joints are gapped and curb misaligned

PIN 5512.52 Kensington Expressway  
Retaining Wall #4 (RT) along 33WB between Northampton St and Utica St

## Calculations



300 State Street, Suite 201 • Rochester, NY 14614  
 Phone 585.454.6110 • Fax 585.454.3066  
 www.labellapc.com

PROJECT  
 PIN

|                        |          |     |           |
|------------------------|----------|-----|-----------|
| Kensington Inspections |          |     |           |
| 5512.52                | CALC. BY | RIM | DATE      |
|                        |          |     | 5/26/2023 |

Condition Estimates

- Retaining Wall 4
  - Condition 2 - map cracks, stains, isolated delam, minor cracks
  - Condition 3 - spalls, widespread delam, major cracks
  - Areas with multiple forms of deterioration were measured under only one category. Condition 3 categories were prioritized over condition 2.

| Panel              | Minor/Map Crack (sf) | Major Cracks (ft) | Spalls (sf) | Widespread Delam (sf) | Isolated Delam | Other (staining, efflor., etc.) |               |               |
|--------------------|----------------------|-------------------|-------------|-----------------------|----------------|---------------------------------|---------------|---------------|
| 401                |                      |                   |             | 72                    |                |                                 |               |               |
| 402                |                      |                   |             | 126                   |                |                                 |               |               |
| 403                |                      |                   |             | 102                   |                |                                 |               |               |
| 404                |                      | 3                 |             | 84                    |                |                                 |               |               |
| 405                |                      | 9                 |             | 57                    |                |                                 |               |               |
| 406                |                      | 5                 |             | 81                    |                |                                 |               |               |
| 407                |                      |                   |             | 112.5                 |                |                                 |               |               |
| 408                | 21                   | 9                 |             | 75                    |                |                                 |               |               |
| 409                | 40                   | 5                 | 1           | 114                   |                |                                 |               |               |
| 410                | 18                   |                   |             | 36                    |                |                                 |               |               |
| 411                |                      |                   |             | 78                    |                |                                 |               |               |
| 412                | 21.5                 |                   |             | 42                    |                |                                 |               |               |
| 413                | 30                   |                   |             | 69                    |                |                                 |               |               |
| 414                | 18.4                 |                   |             |                       | 30             |                                 |               |               |
| 415                | 12                   | 6                 |             |                       | 12             |                                 |               |               |
| 416                | 18                   |                   |             |                       |                |                                 |               |               |
| 417                | 12                   | 5                 |             |                       |                |                                 |               |               |
| 418                | 12                   |                   |             |                       |                |                                 |               |               |
| <b>Total (sf):</b> | 202.90               | 21.00             | 1.00        | 1048.50               | 42.00          | 0.00                            | <b>COND 2</b> | <b>COND 3</b> |
|                    |                      | (sf)              |             |                       |                |                                 | 245           | 1071          |

PIN 5512.52 Kensington Expressway  
Retaining Wall #4 (RT) along 33WB between Northampton St and Utica St

# Wall Inventory Sheet

## INVENTORY, INSPECTION, AND DATA COLLECTION

|                                  |  | WALL INSPECTION LOCATION INFORMATION & NOTES |
|----------------------------------|--|--|
| PRIMARY OWNER                    | NYSDOT - New York State Department of Transportation   |  |
| REGION                           | 05-Region 05 - Buffalo   |  |
| COUNTY                           | 3-County 3 - Erie  |  |
| RESIDENCY                        | 534 - Erie North Residency   |  |
| NYS ROUTE                        | Rte. 33  |  |
| REFERENCE MARKER                 | 3353011031   |  |
| LONGITUDE                        | 78.84369   |  |
| LATITUDE                         | 42.91034   |  |
| ADDITIONAL LOCATION DESCRIPTION  | Located along the on-ramp right shoulder from S.B. Humboldt Parkway to W.B. Kensington Expressway (approximately 521 ft. long, 17.5 ft. maximum exposed height). The west abutment of the Northampton Street Overpass is not considered as part of RW #10. |  |
| TYPE OF SERVICE PROVIDED         | Support/Protect a Roadway  |  |
| WALL TYPE                        | Cantilever - Concrete  |  |
| LEGACY RETAINING WALL TYPE       |  |  |
| WALL FACING TYPE                 | Cast - in -Place Concrete  |  |
| WALL BACKFILL REINFORCEMENT TYPE | N/A  |  |
| ADDITIONAL WALL DESCRIPTION      |  |  |
| WALL LENGTH                      | 521 Ft   |  |
| WALL MAXIMUM HEIGHT              | 17.5 Ft  |  |
| WALL AREA                        | 9650 SF  |  |
| YEAR BUILT                       | 1970   |  |
| CONTRACT NUMBER                  | C 68-2   |  |
| AADT                             | 76,347   |  |
| QC REVIEWER                      |  |  |
| QC APPROVED DATE                 |  |  |
| SITE ACCESS NOTES                | With WZTC in place to close the adjacent shoulder and travel lane, access was performed by walking and extension ladder.   |  |
| INSPECTION FREQUENCY             |  |  |
| LAST INSPECTION STATUS           |  |  |
| INSTRUMENTED                     | N/A  |  |
| MONITORED BY                     | ----   |  |
| INSTRUMENTATION COMMENT          | ----   |  |
| CONSEQUENCE OF FAILURE           | 3-Major  |  |
| WALL POSITION                    | Between Roads  |  |
| GENERAL NOTES                    |  |  |
| RETAINING WALL DATABASE ID       |  |  |
| NUMBER OF ERRORS AND WARNINGS    |  |  |
| USER UPDATE                      |  |  |
| SUBMISSION DATE                  |  |  |
| DATE UPDATE                      |  |  |



**NY33 RETAINING WALL CONDITION EVALUATION 2023**  
**KENSINGTON EXPRESSWAY PROJECT**  
**PIN 5512.52**  
**CITY OF BUFFALO, ERIE COUNTY**  
**RETAINING WALL 8**



Prepared By:



Merton J. Edwards, PE (NYSPE 064981)  
Inspection Team Leader | Sr. Structural Engineer  
Date: 5/30/2023

Reviewed By:



Stephen L. Gauthier, PE (NYSPE 0075775)  
Quality Control Engineer | Sr. Structural Engineer  
Date: 6/16/2023

 **LaBella**  
Powered by partnership.  
300 State Street  
Rochester, New York 14614  
ph: 585-454-6110  
[www.labellapc.com](http://www.labellapc.com)

# PIN 5512.52 – NY33 RETAINING WALL CONDITION EVALUATION 2023 FIELD INSPECTION SUMMARY

STRUCTURE: Retaining Wall #8 (RT) along 33WB between Best St and Dodge St

STRUCTURE TYPE: Reinforced Concrete Cantilever Wall on Piles (Panels 1A-3C)  
Reinforced Concrete Cantilever Buttressed Wall on Spread Footings (Panels 4A-4B)  
Reinforced Concrete Cantilever Wall on Spread Footings (Panels 5A-7C)  
Year Built: 1970

CURRENT INSPECTION: 05/01/23 – 5/09/23 (LaBella Inspections)

LAST KNOWN INSPECTION: Unknown

CONDITION STATE: GOOD

## RETAINING WALL INSPECTION & DOCUMENTATION:

Inspection of the retaining walls will be in conformance with the NYSDOT Retaining Wall Inventory and Inspection Program Manual, October 2018. Inspection of the following elements will be inspected and documented as appropriate:

### - Inspection:

The following procedure will be followed for the inspection of retaining walls:

- Walls were checked for signs of settlement, rotation, or bulging. Walls faces were checked for vertical alignment using a smart level. The walls being evaluated are vertical with no batter.
- Construction joints between sections of the wall were examined for misalignment, and near the ground line for fill material washing out from between panels or joint.
- Walls were inspected for erosion material in front of the wall, for heaving of material in front of the wall, and for settlement of fill behind the wall.
- Examined the wall for deterioration of the material, such as cracking, spalling, and/or corrosion, noting the width, length, depth, and/or orientation of the deterioration. Photographs are provided, documenting defects found.
- Wall façades were reviewed for evidence of water seepage, efflorescence, or rust staining.
- Examined the base of walls for evidence of water flow where the water table may be within the retained earth.
- Examined and probed drains for signs of clogging. Examined drainage around ends of wall and note if embankments have been experiencing erosion.
- Examined site grading for any locations that may prohibit proper drainage from behind the wall looking for evidence of ponding above the wall, such as debris accumulation in the lower spots.
- Ascertain why water is not draining properly and note in the inspection.
- Inspected roadway components above wall for signs or joint separation, potholes, and areas of settlement.
- Examined vegetation growth along and above the wall for root infiltration creating undesirable stresses on the wall. Documented any induce cracking, bulging or failure.
- Examined the wall system for vehicular damage and document the location and degree of damage.

GENERAL OBSERVATIONS:

1. Retaining Wall Panels are generally 30 ft in length with a 9" coping under the barrier and horizontal chamfered panels spaced 3'-0" vertically. There is some variation in panel length due to the location of bridges within the corridor. For specific panel lengths see the DOCUMENTION Section of this report.
2. The subject retaining wall was found to be in GOOD-FAIR condition with some minor cracking, small areas of rust staining, and small isolated spalls. For specific conditions found and photographs of the wall panels, see the DOCUMENTION Section of this report.
3. The rail coping was found to be in FAIR condition with minor map cracking. For specific conditions found, photographs of the of wall panels, and condition calculations see the attached sections of this report.

| General:                    |             |
|-----------------------------|-------------|
| DEFECT                      | DESCRIPTION |
| Misalignment                | None noted. |
| Settlement                  | None noted. |
| Sinkhole (cavity) Formation | None noted. |

| Concrete Cracks:                                     |   |
|--|---|
| DEFECT   | DESCRIPTION   |
| Insignificant Cracks<br>(cracks < 0.012 inches wide) | Most panels have minor cracking on the bottom 2' to 6'.   |
| Map cracks   | A few panels have map cracking on the bottom 3' to 9'.<br>Minor map cracking is present on the coping.  |
| Moderate Cracks<br>(0.012 - 0.05 inches wide)        | Panels 4A.1 and 4A.2 both have a full-height crack near the joint between them.<br>Panel 1A has a full depth longitudinal crack under the coping. |
| Wide Cracks<br>(cracks > 0.05 inches wide)           | None noted.   |

PIN 5512.52 Kensington Expressway  
 Retaining Wall #8 (RT) along 33WB between Best St and Dodge St

| Additional Concrete Distress: |   |
|-------------------------------|---|
| DEFECT                        | DESCRIPTION   |
| Spalling / Delamination       | Some panels have small spalls on the top edge of the top panel. Panel 5B has small spalls between a few of the lower chamfer lines. |
| Staining                      | Some of the panels have rust staining at vertical rebar locations in between some panel chamfers.                                   |
| Exposed Rebar                 | None noted.   |

| Notes:   |
|--|
| <p>RW 8 consists of 20 panels numbered from 1A (South) to 7C (North). Panel 4A is split into two sections (4A.1 and 4A.2). The retaining wall supports Linden Park above State Route 33 (Kensington Expressway).</p> <p>Located along the off-ramp shoulder from W.B. Kensington to Best St (Approximately 544 ft. long, 21.5 ft. maximum exposed height). The west abutment of Dodge St Bridge is not included as part of retaining wall 8.</p> |

**INVENTORY, INSPECTION, AND DATA COLLECTION**

| Element                       | Total Qty | Units | Condition State |             |             |               |
|-------------------------------|-----------|-------|-----------------|-------------|-------------|---------------|
|                               |           |       | 1               | 2           | 3           | 4             |
|                               |           |       | <i>GOOD</i>     | <i>FAIR</i> | <i>POOR</i> | <i>SEVERE</i> |
| RW.01 - Entire Wall           | 1         | Each  | 0.91            | 0.09        |             |               |
| RW.02 - Wall Facing           | 7831      | SF    | 7006            | 805         | 20          |               |
| RW.03 - Ground Surface, Front | 544       | FT    | 544             |             |             |               |
| RW.04 - Ground Surface, Back  | 544       | FT    | 544             |             |             |               |
| RW.05 - Weep Holes            | N/A       | Each  | ---             | ---         | ---         | ---           |
| 800 - Scour                   | N/A       | FT    | ---             | ---         | ---         | ---           |

PIN 5512.52 Kensington Expressway  
Retaining Wall #8 (RT) along 33WB between Best St and Dodge St

#### INSPECTION RESULTS/ RECOMMENDATIONS

- **Overall Condition State Recommendation: 1 – GOOD**
- PROJECT DOCUMENTATION CAN BE FOUND IN THE ATTACHED SECTIONS

PIN 5512.52 Kensington Expressway  
Retaining Wall #8 (RT) along 33WB between Best St and Dodge St

## Inspection Photos

# PIN 5512.52 – NY33 RETAINING WALL CONDITION EVALUATION 2023 FIELD INSPECTION SUMMARY

Retaining Wall #8 (RT) along 33WB between Best St and Dodge St



PHOTO 1  
PANEL 7C

Description:

Left of Dodge St bridge west abutment.

Minor map cracking on bottom two panels and coping. Cracking on coping is similar for most of RW8.

Rust staining present at vertical rebar location in between most panel chamfers.



PHOTO 2  
PANEL 7A

Description:

Rust staining present at vertical rebar locations in between some panel chamfers. Similar for Panel 7B and 6B.

There is a small repaired area 6.5' high with a 6' vertical crack above.

# PIN 5512.52 – NY33 RETAINING WALL CONDITION EVALUATION 2023 FIELD INSPECTION SUMMARY

Retaining Wall #8 (RT) along 33WB between Best St and Dodge St



PHOTO 3  
PANEL 6A

Description:

Minor cracking on bottom two panels and coping. Similar for 6B and 5C.

One of the repaired areas is cracking.



PHOTO 4  
PANEL 5B

Description:

Rust staining present at vertical rebar locations in between most panel chamfers.

There are several small spalls at the chamfers between panels 2 and 3 and 3 and 4 from the bottom.

Minor cracking on bottom two panels and coping, typical.

# PIN 5512.52 – NY33 RETAINING WALL CONDITION EVALUATION 2023 FIELD INSPECTION SUMMARY

Retaining Wall #8 (RT) along 33WB between Best St and Dodge St

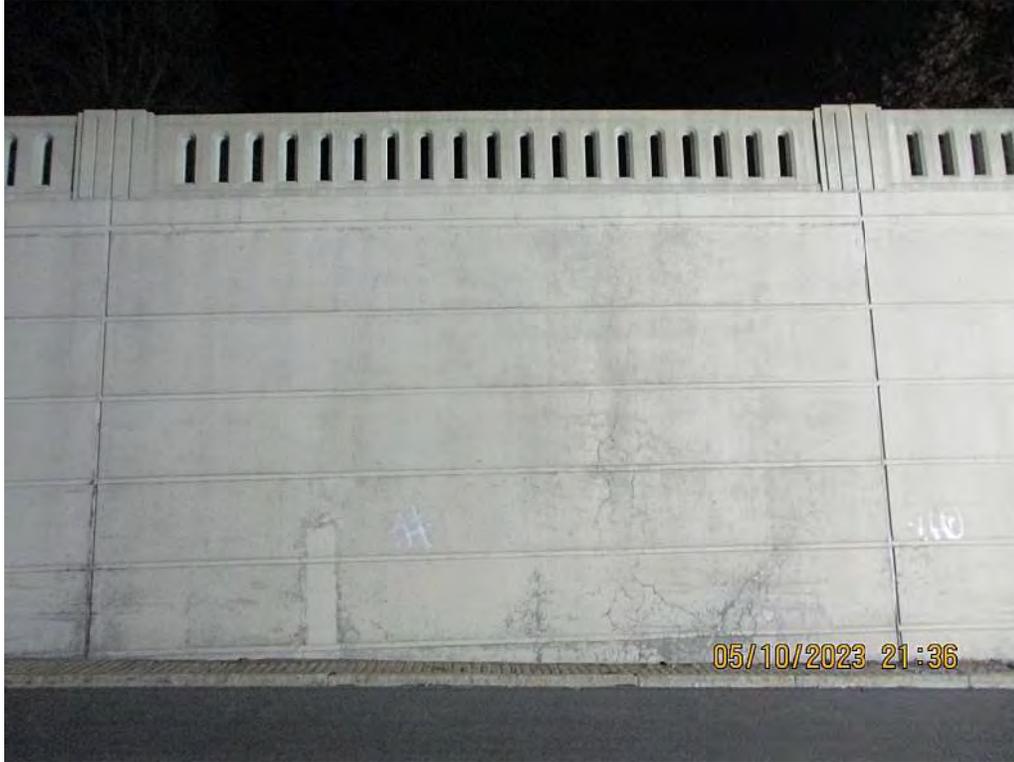


PHOTO 5  
PANEL 4B

Description:

Map cracking for full height on the right half of the panel and 6' high on left half of the panel.

Minor cracking on coping, typical.

The top panel has areas of spalling on the edge below the coping.



PHOTO 6  
PANEL 4A.2

Description:

Map cracking bottom 2 panels.  
Minor cracking on coping, typical.

There is a full-height vertical crack near the left joint of the panel.  
There is a 6' vertical crack above the repaired area near midspan.

The top panel has areas of spalling on the edge below the coping.

# PIN 5512.52 – NY33 RETAINING WALL CONDITION EVALUATION 2023 FIELD INSPECTION SUMMARY

Retaining Wall #8 (RT) along 33WB between Best St and Dodge St



PHOTO 7  
PANEL 4A.1

Description:

Map cracking on bottom panel.  
Minor cracking on coping, typical.

Above the repaired area near the right joint, there is a 9' vertical crack that extends to the coping.

The top panel has areas of spalling on the edge below the coping.



PHOTO 8  
PANEL 3B

Description:

Minor cracking on coping, typical.

The top panel has areas of spalling on the edge below the coping.

There is map cracking on the top 2 panels for 1.5' from each joint.

# PIN 5512.52 – NY33 RETAINING WALL CONDITION EVALUATION 2023 FIELD INSPECTION SUMMARY

Retaining Wall #8 (RT) along 33WB between Best St and Dodge St



PHOTO 9  
PANEL 2C  
Description:  
Minor cracking on coping, typical.  
Isolated map cracking near bottom of left joint. Continues onto Panel 2B.



PHOTO 10  
PANEL 2A  
Description:  
Minor cracking on coping, typical.  
Scattered vertical crack throughout.

# PIN 5512.52 – NY33 RETAINING WALL CONDITION EVALUATION 2023 FIELD INSPECTION SUMMARY

Retaining Wall #8 (RT) along 33WB between Best St and Dodge St



PHOTO 11  
PANEL 1A  
Description:  
End of RW8.  
Minor cracking on coping, typical.  
Rust staining present at vertical rebar locations in lower chamfer.




PHOTO 12  
PANEL 1A (END)  
Description:  
Full depth longitudinal crack right below coping for full length of panel.  
Fill behind wall is in good condition.

PIN 5512.52 Kensington Expressway  
Retaining Wall #8 (RT) along 33WB between Best St and Dodge St

# Field Sheets

FILE NAME = \\06cashlab\06\02150716.01\_kensington Preliminary Design\Drawings\Highway\Plan\set2\0551252\_cph\_pin\_11A.dgn  
 DATE = 2/7/2023  
 TIME = 12:56:26 PM


PROJECT MANAGER  
 CHECK  
 DRAFTING  
 CHECK  
 DESIGN  
 JOB MANAGER  
 DESIGN SUPERVISOR

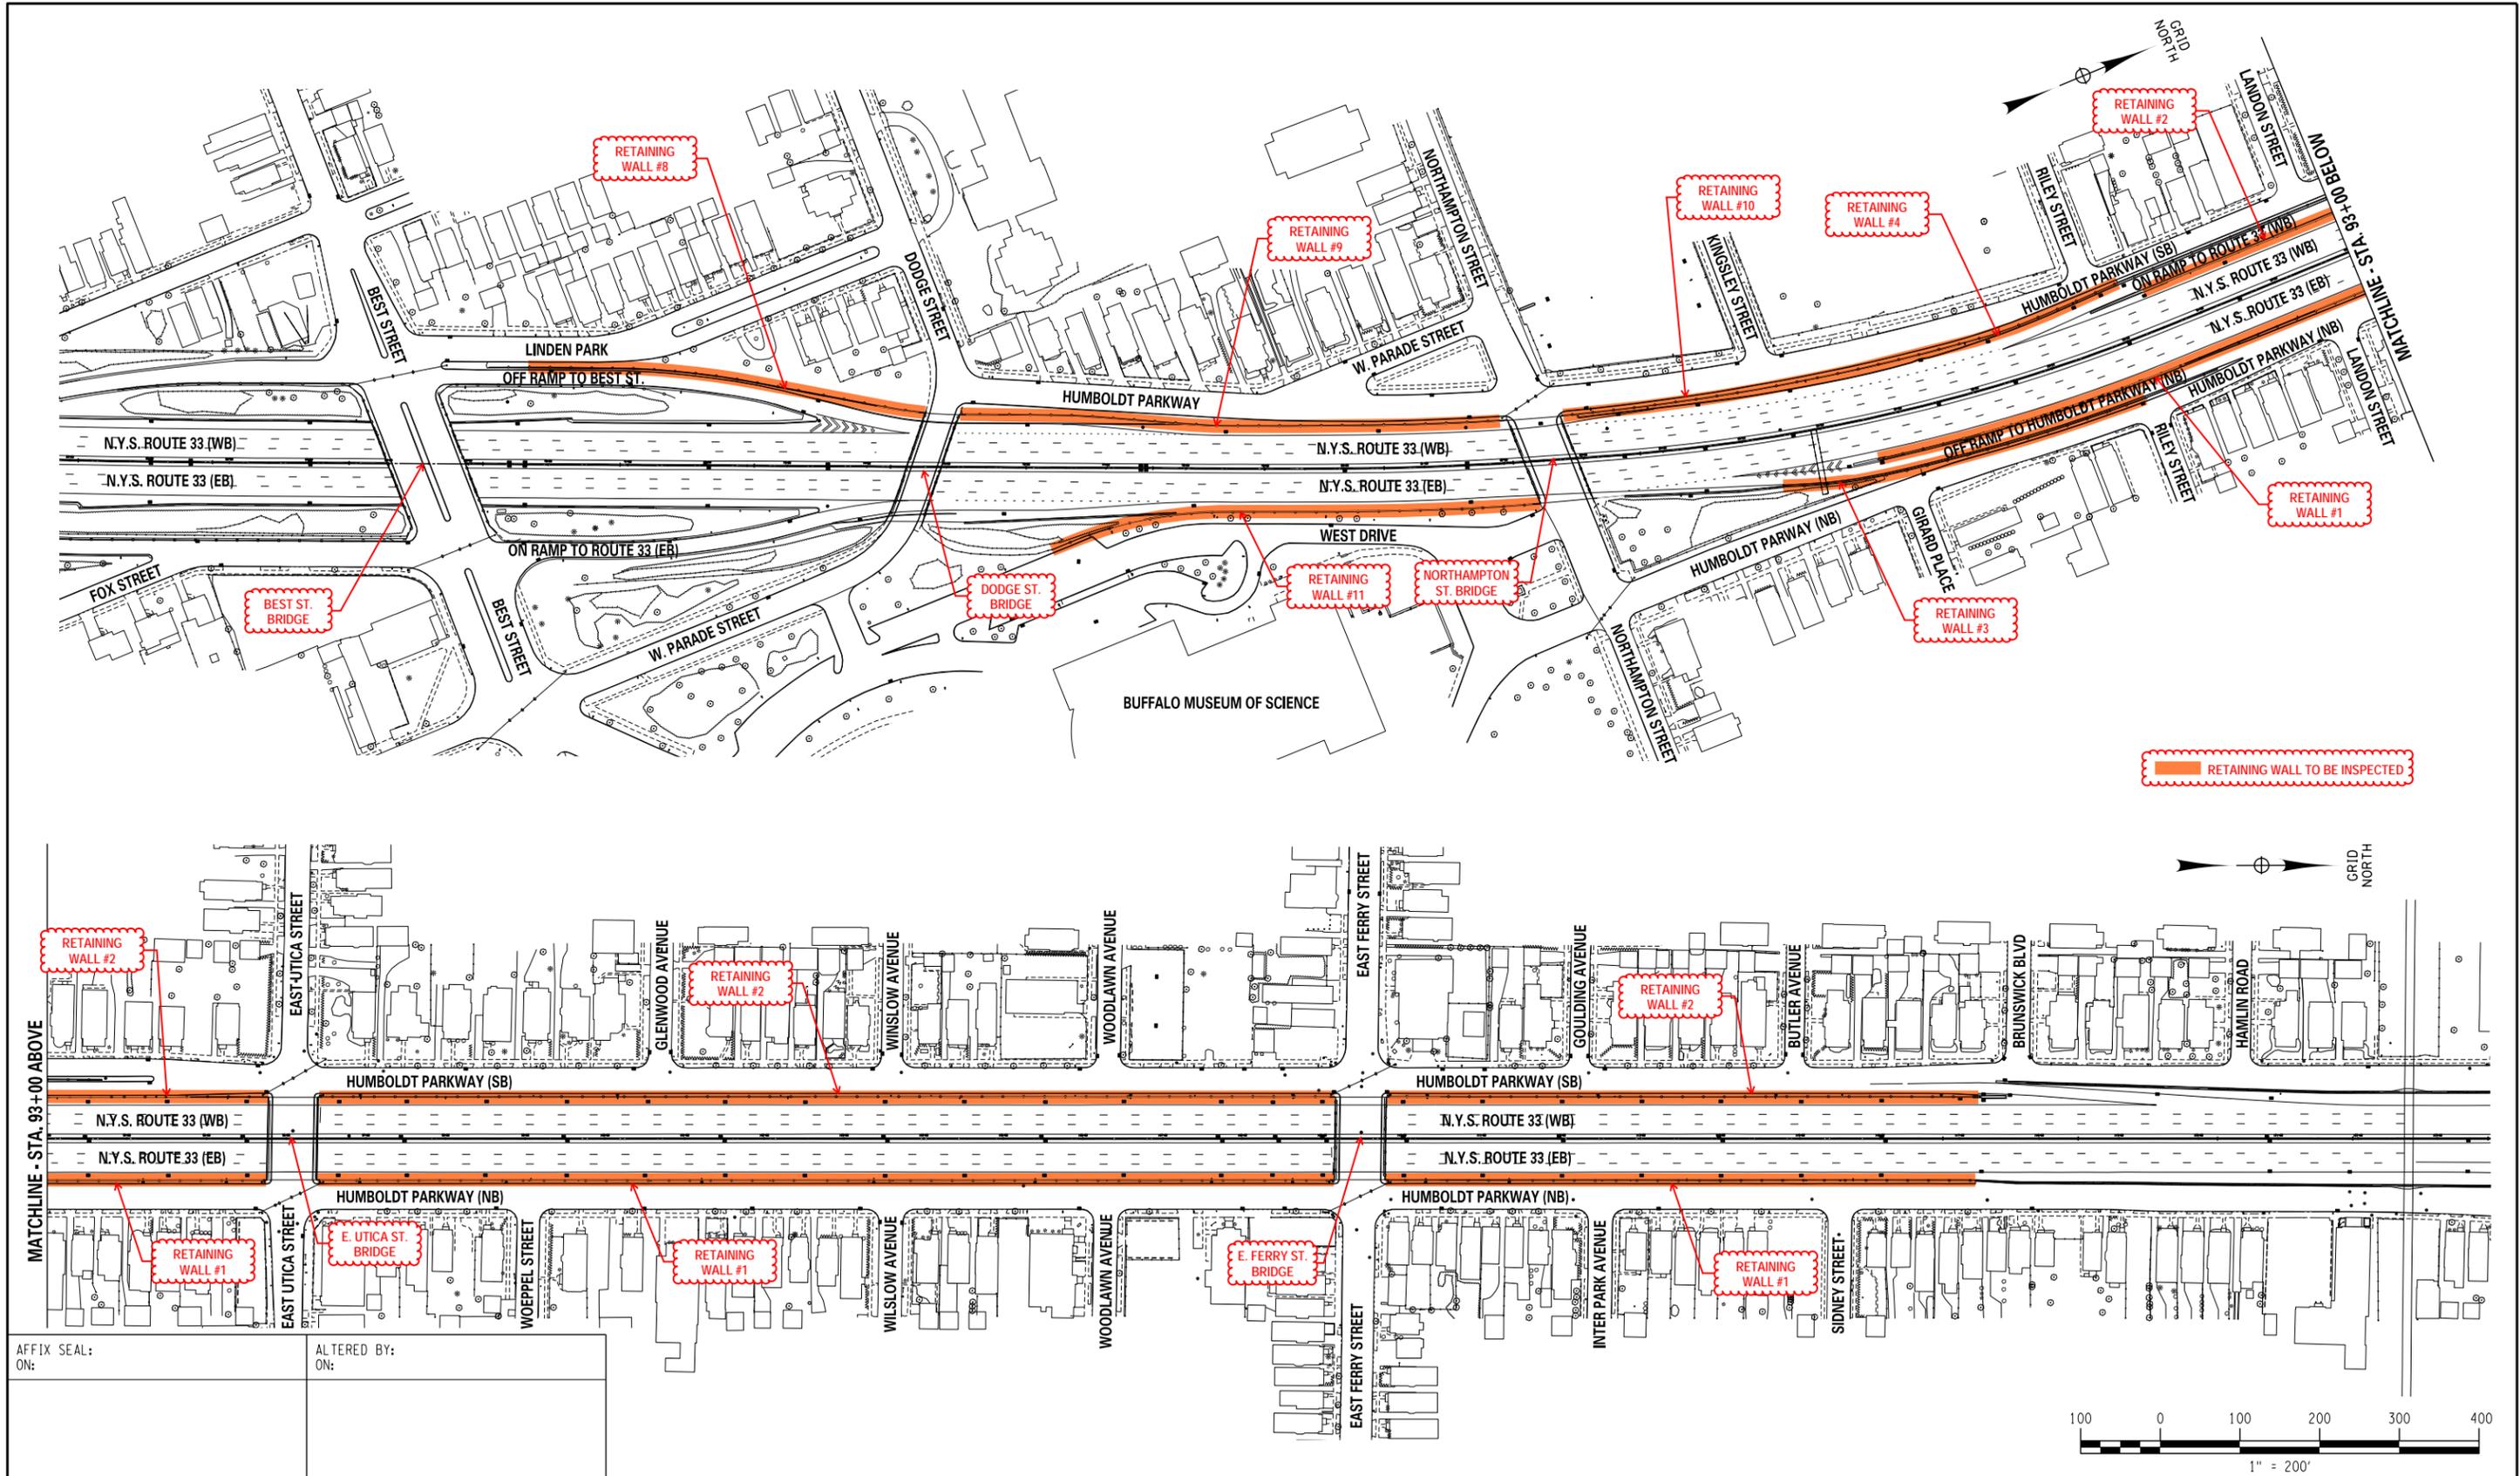

|                    |                    |
|--------------------|--------------------|
| AFFIX SEAL:<br>ON: | ALTERED BY:<br>ON: |
|--------------------|--------------------|

|   |                       |             |         |          |   |                 |
|---|-----------------------|-------------|---------|----------|---|-----------------|
| AS-BUILT REVISIONS<br>DESCRIPTION OF ALTERATIONS: | STATE ROUTE 33        | PIN 5512.52 | BRIDGES | CULVERTS | ALL DIMENSIONS IN FT UNLESS OTHERWISE NOTED                         | CONTRACT NUMBER |
|   | KENSINGTON EXPRESSWAY |             |         |          |   |                 |
|   | CITY OF BUFFALO       | REGION: 5   |         |          | <b>KENSINGTON EXPRESSWAY</b><br><b>RETAINING WALL LOCATION PLAN</b> | DRAWING NO. 1   |
|   | COUNTY: ERIE          |             |         |          |   | SHEET NO.       |

IT IS A VIOLATION OF LAW FOR ANY PERSON, UNLESS THEY ARE ACTING UNDER THE DIRECTION OF A LICENSED PROFESSIONAL ENGINEER, ARCHITECT, LANDSCAPE ARCHITECT, OR LAND SURVEYOR, TO ALTER AN ITEM IN ANY WAY. IF AN ITEM BEARING THE STAMP OF A LICENSED PROFESSIONAL IS ALTERED, THE ALTERING ENGINEER, ARCHITECT, LANDSCAPE ARCHITECT, OR LAND SURVEYOR SHALL STAMP THE DOCUMENT AND INCLUDE THE NOTATION "ALTERED BY" FOLLOWED BY THEIR SIGNATURE, THE DATE OF SUCH ALTERATION, AND A SPECIFIC DESCRIPTION OF THE ALTERATION.

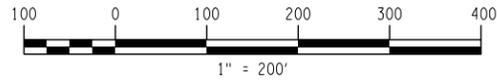

Due to limitation with road closures, field sheets for RW8 were completed from site photos taken 5-10-23. The wall was not checked for delamination.



RW 8 BEGINS AFTER BEST ST BRIDGE

Full depth longitudinal crack right below coping.

Minor cracking on coping.  
Rust staining present at vertical rebar locations in between lower panel chamfer.

Minor cracking on coping.

PANEL 1A

PANEL 1B

MATCH LINE

Minor cracking on coping and scattered vertical cracks throughout.

Minor cracking on coping.  
Rust staining present at vertical rebar locations in between most panel chamfers.

Map Cr.  
9SF

Minor cracking on coping.

2SF

Isolated map cracking near joint

PANEL 2A

PANEL 2C

MATCH LINE

MATCH LINE

Minor cracking on bottom panel and coping.

Small spalls on edge of top panel (below chamfer).

Small spalls on edge of top panel (below chamfer).

Minor cracking on coping.  
Map cracking on top 2 panels for 1.5' from each joint (9SF each side)

Minor cracking on bottom panel and coping.


PANEL 3A

PANEL 3C

MATCH LINE

MATCH LINE



## RW 8 PANELS 1A-3C

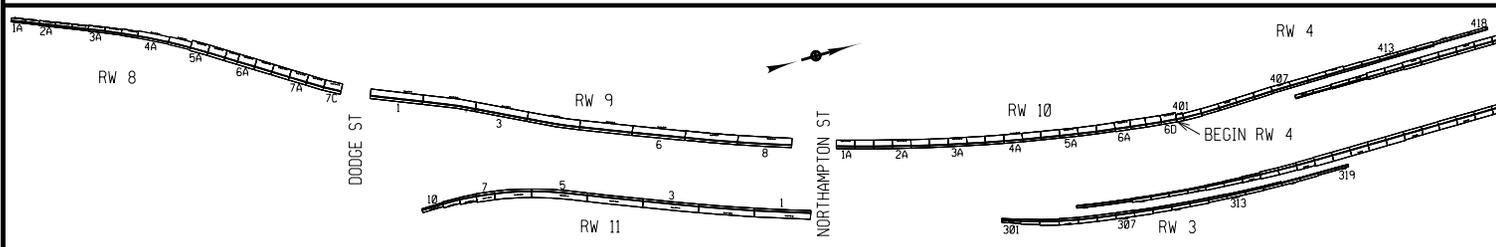


BY: RIM

DATE: 5-24-2023







SCALE: 1" = 10'

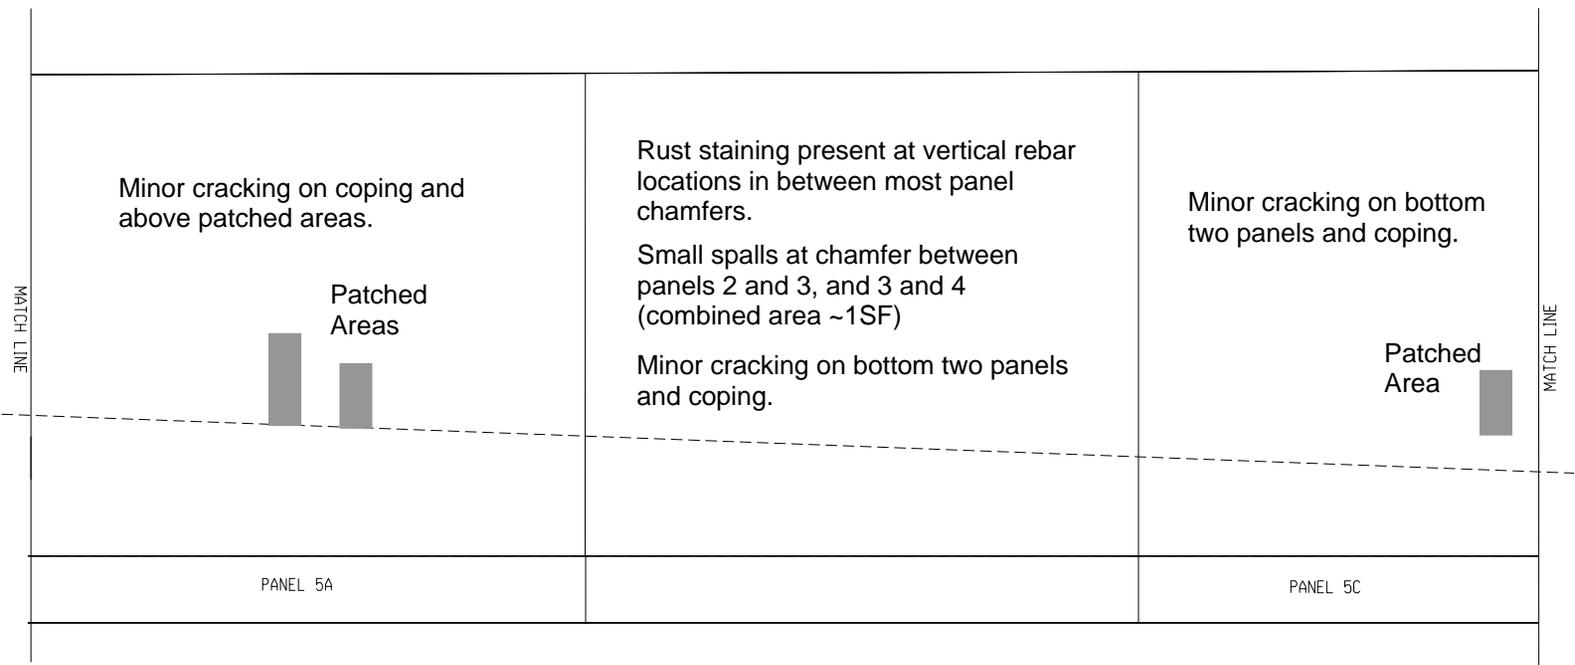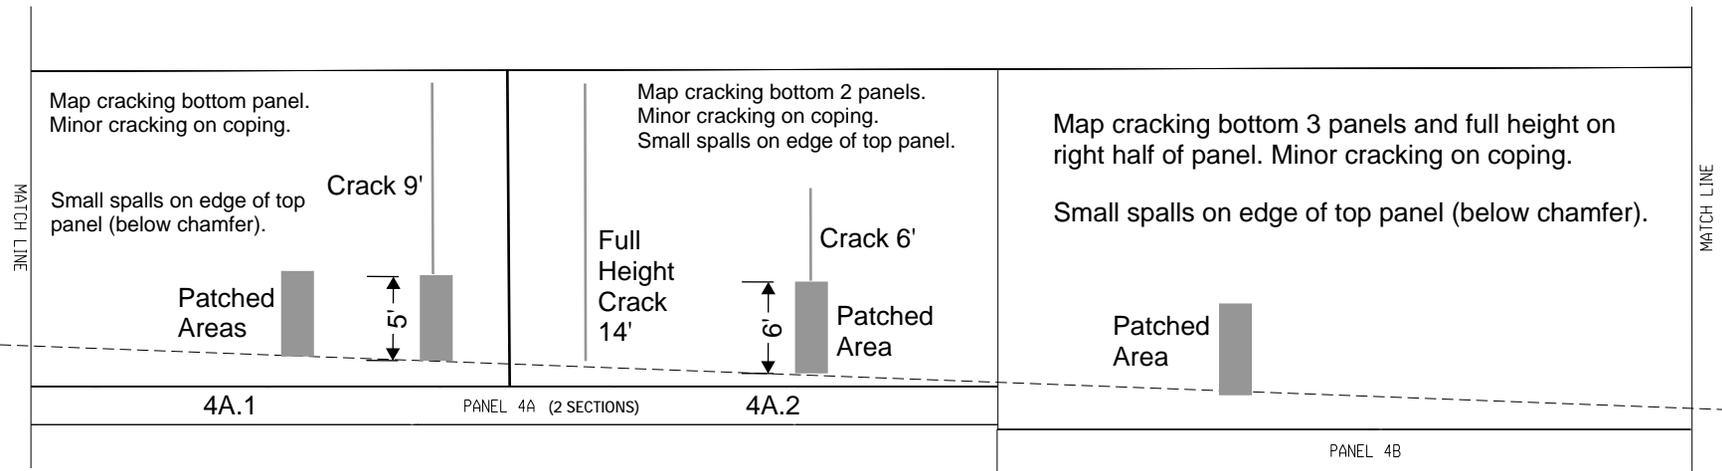



# RW 8 PANELS 4A-5C

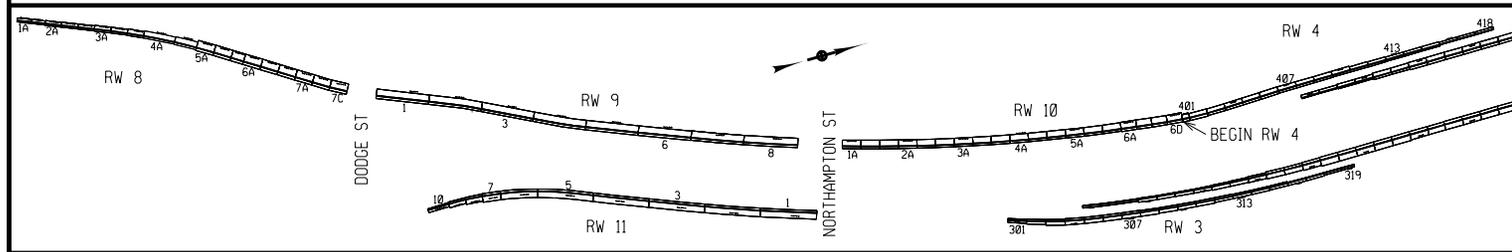

BY: RIM  
 DATE: 5-24-2023  
 SCALE: 1" = 10'

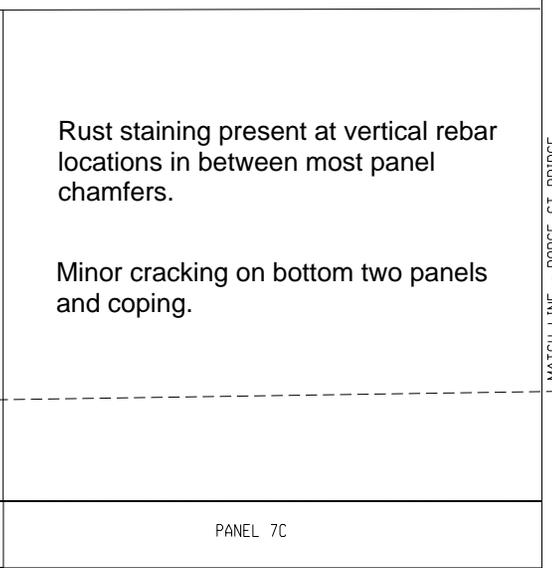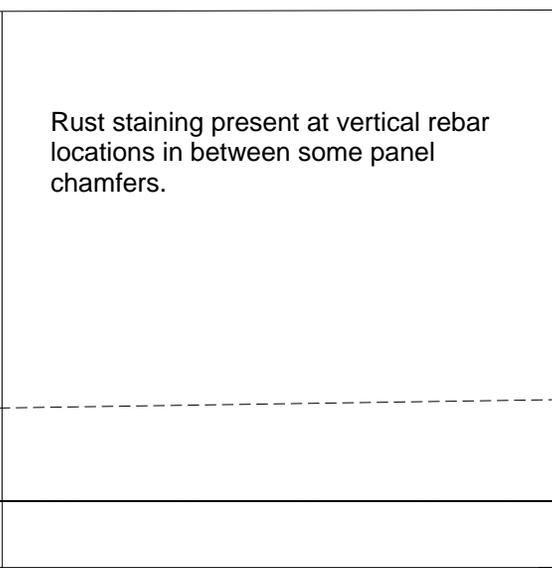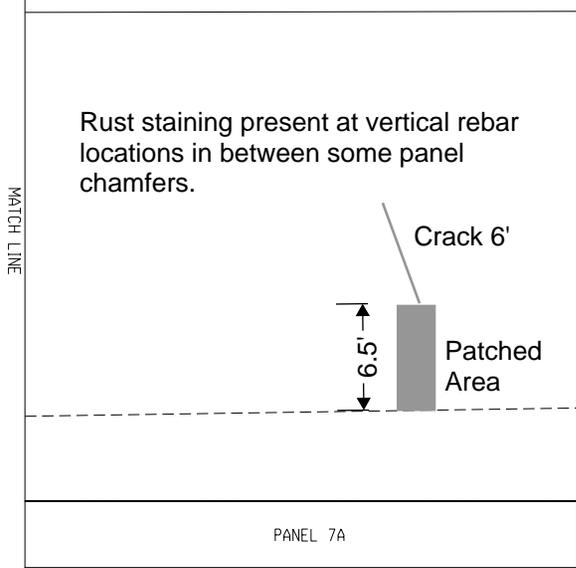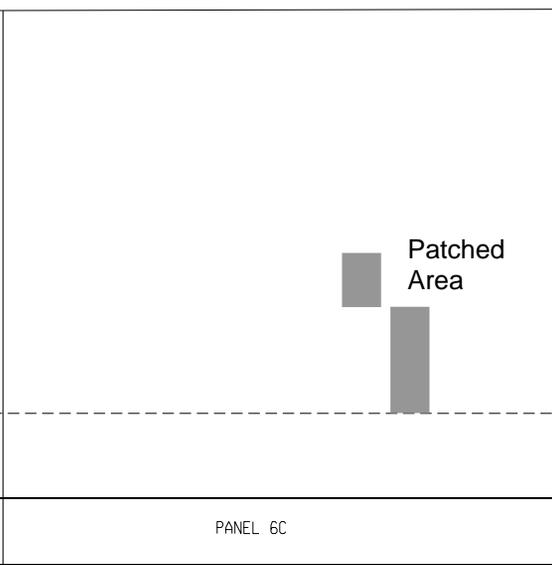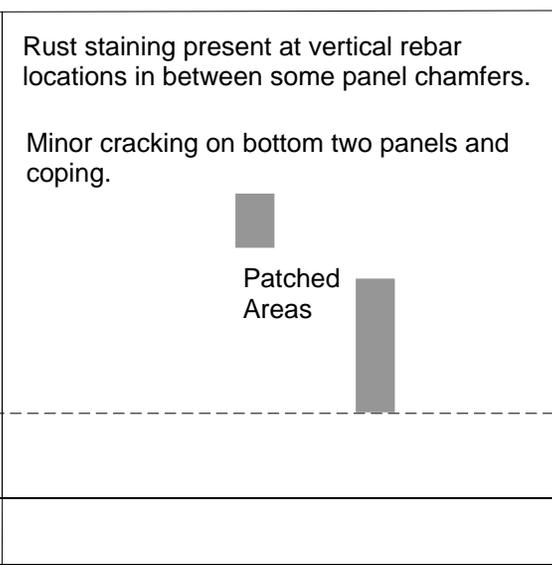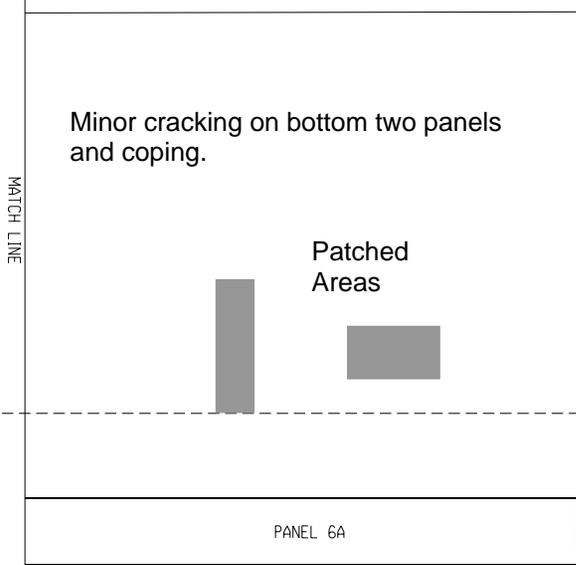

### RW 8 PANELS 6A-7C

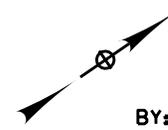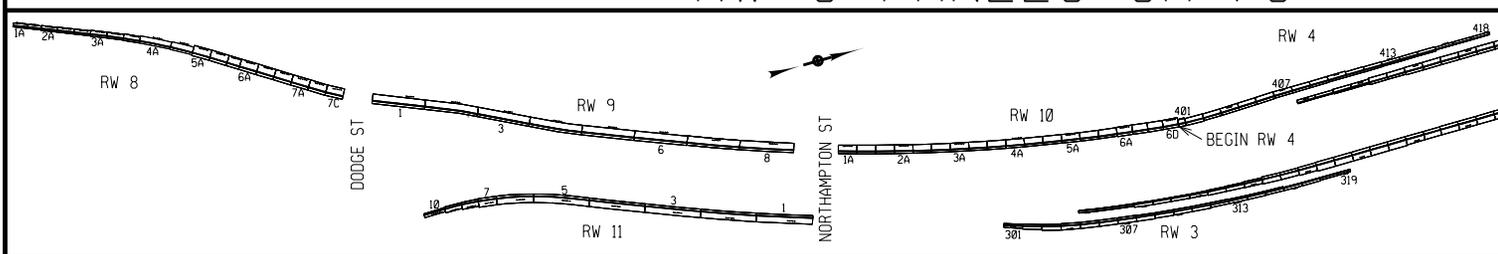

**BY:** RIM

---

**DATE:** 5-24-2023

---

**SCALE:** 1" = 10'

Retaining Wall Coping Inspection 5/30/2023

Retaining Wall 8

Northampton to Dodge:

- Typical stress cracking in balustrade railing

PIN 5512.52 Kensington Expressway  
Retaining Wall #8 (RT) along 33WB between Best St and Dodge St

# Calculations



300 State Street, Suite 201 • Rochester, NY 14614  
 Phone 585.454.6110 • Fax 585.454.3066  
 www.labellapc.com

PROJECT  
 PIN

|                        |          |     |           |
|------------------------|----------|-----|-----------|
| Kensington Inspections |          |     |           |
| 5512.52                | CALC. BY | RIM | DATE      |
|                        |          |     | 5/26/2023 |

Condition Estimates

- Retaining Wall 8
  - Condition 2 - map cracks, stains, isolated delam, minor cracks
  - Condition 3 - spalls, widespread delam, major cracks
  - Areas with multiple forms of deterioration were measured under only one category. Condition 3 categories were prioritized over condition 2.

| Panel              | Minor/Map Crack (sf) | Major Cracks (ft) | Spalls (sf) | Delam (sf)  | Other (staining, efflor., etc.) |               |               |
|--------------------|----------------------|-------------------|-------------|-------------|---------------------------------|---------------|---------------|
| 1A                 |                      | 15                |             |             | 1                               |               |               |
| 1B                 |                      |                   |             |             |                                 |               |               |
| 2A                 | 25                   |                   |             |             |                                 |               |               |
| 2B                 | 9                    |                   |             |             | 1                               |               |               |
| 2C                 | 2                    |                   |             |             |                                 |               |               |
| 3A                 | 12                   |                   |             |             |                                 |               |               |
| 3B                 | 18                   |                   | 0.5         |             |                                 |               |               |
| 3C                 | 18                   |                   | 0.5         |             |                                 |               |               |
| 4A.1               | 30                   | 9                 | 0.5         |             |                                 |               |               |
| 4A.2               | 95.5                 | 9                 | 0.5         |             |                                 |               |               |
| 4B                 | 330                  |                   | 0.5         |             |                                 |               |               |
| 5A                 | 4                    |                   |             |             |                                 |               |               |
| 5B                 | 45                   |                   |             | 1           | 6.67                            |               |               |
| 5C                 | 36                   |                   |             |             |                                 |               |               |
| 6A                 | 24                   |                   |             |             |                                 |               |               |
| 6B                 | 27                   |                   |             |             | 1                               |               |               |
| 6C                 |                      |                   |             |             |                                 |               |               |
| 7A                 | 3                    |                   |             |             | 1                               |               |               |
| 7B                 |                      |                   |             |             | 1                               |               |               |
| 7C                 | 36                   |                   |             |             | 10                              |               |               |
| Coping             | 68.1                 |                   |             |             |                                 |               |               |
| <b>Total (sf):</b> | <b>782.60</b>        | <b>16.50</b>      | <b>3.50</b> | <b>0.00</b> | <b>21.67</b>                    | <b>COND 2</b> | <b>COND 3</b> |
|                    |                      | (sf)              |             |             |                                 | 805           | 20            |

PIN 5512.52 Kensington Expressway  
Retaining Wall #8 (RT) along 33WB between Best St and Dodge St

# Wall Inventory Sheet

## INVENTORY, INSPECTION, AND DATA COLLECTION

|                                  |  | WALL INSPECTION LOCATION INFORMATION & NOTES |
|----------------------------------|--|--|
| PRIMARY OWNER                    | NYS DOT - New York State Department of Transportation  |  |
| REGION                           | 05-Region 05 - Buffalo   |  |
| COUNTY                           | 3-County 3 - Erie  |  |
| RESIDENCY                        | 534 - Erie North Residency   |  |
| NYS ROUTE                        | Rte. 33  |  |
| REFERENCE MARKER                 | 53011027   |  |
| LONGITUDE                        | 78.84522   |  |
| LATITUDE                         | 42.90542   |  |
| ADDITIONAL LOCATION DESCRIPTION  | Located along the off-ramp shoulder from W.B. Kensington to Best Street (approximately 544 ft. long, 21.5 ft. maximum exposed height). |  |
| TYPE OF SERVICE PROVIDED         | Support/Protect a Roadway  |  |
| WALL TYPE                        | Cantilever - Concrete  |  |
| LEGACY RETAINING WALL TYPE       |  |  |
| WALL FACING TYPE                 | Cast - in -Place Concrete  |  |
| WALL BACKFILL REINFORCEMENT TYPE | N/A  |  |
| ADDITIONAL WALL DESCRIPTION      |  |  |
| WALL LENGTH                      | 544 Ft   |  |
| WALL MAXIMUM HEIGHT              | 21.5 Ft  |  |
| WALL AREA                        | 11960 SF   |  |
| YEAR BUILT                       | 1960   |  |
| CONTRACT NUMBER                  | FAC 59-19  |  |
| AADT                             | 82,171   |  |
| QC REVIEWER                      |  |  |
| QC APPROVED DATE                 |  |  |
| SITE ACCESS NOTES                | With WZTC in place to close the adjacent shoulder and travel lane, access was performed by walking and extension ladder.               |  |
| INSPECTION FREQUENCY             |  |  |
| LAST INSPECTION STATUS           |  |  |
| INSTRUMENTED                     | N/A  |  |
| MONITORED BY                     | ----   |  |
| INSTRUMENTATION COMMENT          | ----   |  |
| CONSEQUENCE OF FAILURE           | 3-Major  |  |
| WALL POSITION                    | Above Road   |  |
| GENERAL NOTES                    |  |  |
| RETAINING WALL DATABASE ID       |  |  |
| NUMBER OF ERRORS AND WARNINGS    |  |  |
| USER UPDATE                      |  |  |
| SUBMISSION DATE                  |  |  |
| DATE UPDATE                      |  |  |

**NY33 RETAINING WALL CONDITION EVALUATION 2023**  
**KENSINGTON EXPRESSWAY PROJECT**  
**PIN 5512.52**  
**CITY OF BUFFALO, ERIE COUNTY**  
**RETAINING WALL 9**



Prepared By:

Merton J. Edwards, PE (NYSPE 064981)  
Inspection Team Leader | Sr. Structural Engineer  
Date: 5/30/2023

Reviewed By:

Stephen L. Gauthier, PE (NYSPE 0075775)  
Quality Control Engineer | Sr. Structural Engineer  
Date: 6/16/2023

 **LaBella**  
Powered by partnership.  
300 State Street  
Rochester, New York 14614  
ph: 585-454-6110  
[www.labellapc.com](http://www.labellapc.com)

# PIN5512.52 – NY33 RETAINING WALL CONDITION EVALUATION 2023 FIELD INSPECTION SUMMARY

STRUCTURE: Retaining Wall #9 (RT) along 33WB between Dodge St and Northampton St

STRUCTURE TYPE: Reinforced Concrete Cantilever Buttressed Wall on Spread Footings (Panels 1-6)  
Reinforced Concrete Cantilever Wall on Piles (Panels 7-8)  
Year Built: 1970

CURRENT INSPECTION: 05/01/23 – 5/09/23 (LaBella Inspections)

LAST KNOWN INSPECTION: Unknown

CONDITION STATE: FAIR

## RETAINING WALL INSPECTION & DOCUMENTATION:

Inspection of the retaining walls will be in conformance with the NYSDOT Retaining Wall Inventory and Inspection Program Manual, October 2018. Inspection of the following elements will be inspected and documented as appropriate:

### - Inspection:

The following procedure will be followed for the inspection of retaining walls:

- Walls were checked for signs of settlement, rotation, or bulging. Walls faces were checked for vertical alignment using a smart level. The walls being evaluated are vertical with no batter.
- Construction joints between sections of the wall were examined for misalignment, and near the ground line for fill material washing out from between panels or joint.
- Walls were inspected for erosion material in front of the wall, for heaving of material in front of the wall, and for settlement of fill behind the wall.
- Examined the wall for deterioration of the material, such as cracking, spalling, and/or corrosion, noting the width, length, depth, and/or orientation of the deterioration. Photographs are provided, documenting defects found.
- Wall façades were reviewed for evidence of water seepage, efflorescence, or rust staining.
- Examined the base of walls for evidence of water flow where the water table may be within the retained earth.
- Examined and probed drains for signs of clogging. Examined drainage around ends of wall and note if embankments have been experiencing erosion.
- Examined site grading for any locations that may prohibit proper drainage from behind the wall looking for evidence of ponding above the wall, such as debris accumulation in the lower spots.
- Ascertain why water is not draining properly and note in the inspection.
- Inspected roadway components above wall for signs of joint separation, potholes, and areas of settlement.
- Examined vegetation growth along and above the wall for root infiltration creating undesirable stresses on the wall. Documented any induce cracking, bulging or failure.
- Examined the wall system for vehicular damage and document the location and degree of damage.

GENERAL OBSERVATIONS:

1. Retaining Wall Panels are generally 30 ft in length with horizontal chamfered panels spaced 3'-0" vertically, from the top of the wall. There is some variation in panel length due to the location of bridges within the corridor. For specific panel lengths see the DOCUMENTION Section of this report.
2. The lower 6-12 ft of the subject retaining wall was found to be in FAIR-POOR condition with extensive map cracking, dampness, isolated efflorescence, spalls, and small areas of delamination. For specific conditions found and photographs of the wall panels, see the DOCUMENTION Section of this report.
3. The upper portions of theses wall panels were generally found to be in GOOD-FAIR condition with the exception of a few locations. Staining was found on the top panel. About half of the panels were found to have map cracking near either side of each joint for the full height of the panel. For specific conditions found and photographs of the wall panels, see the DOCUMENTION Section of this report.
4. The panels were found to have several full-height or mid-height vertical cracks. For specific conditions found, photographs of the of wall panels, and condition calculations see the attached sections of this report.

| General:                    |             |
|-----------------------------|-------------|
| DEFECT                      | DESCRIPTION |
| Misalignment                | None noted. |
| Settlement                  | None noted. |
| Sinkhole (cavity) Formation | None noted. |

| Concrete Cracks:                                     |   |
|--|---|
| DEFECT   | DESCRIPTION   |
| Insignificant Cracks<br>(cracks < 0.012 inches wide) | Almost all panels have several vertical cracks on the bottom half of the panel.   |
| Map cracks   | Map cracking is present on the bottom 3'-9' of the panels.<br><br>About half the panels also have map cracking near either side of each joint for the full height of the panel. |
| Moderate Cracks<br>(0.012 - 0.05 inches wide)        | Most panels have at least one mid- to full-height moderate crack.   |
| Wide Cracks<br>(cracks > 0.05 inches wide)           | None noted.   |

PIN 5512.52 Kensington Expressway  
Retaining Wall #9 (RT) along 33WB between Dodge St and West Parade Street

| Additional Concrete Distress: |   |
|-------------------------------|---|
| DEFECT                        | DESCRIPTION   |
| Spalling / Delamination       | There are 1' to 2' wide spalls present on the panels in group 5. Panels 1.1 and 1.2 have smaller (3"x3") spalls, 6' above the ground.<br><br>Some panels have isolated areas of delamination, typically in the lower half of the panel. Panel 7.3 has widespread delamination in the bottom 9'. |
| Staining                      | A few isolated areas of rust staining are present.<br><br>There is efflorescence staining on the top panel as well as in some of the vertical cracks.   |
| Exposed Rebar                 | None noted.   |

**Notes:**

RW 9 consists of 24 panels grouped into sets of 3 and numbered from 1 (South-West) to 8 (North-East) on record plans. For the inspections, panels were numbered as 1.1, 1.2, and 1.3 for group one, and so on. The retaining wall supports the S.B. Humboldt Parkway above State Route 33.

Located along the W.B. mainline right shoulder between Dodge and Northampton Streets (Approximately 683 ft. long, 22 ft. maximum exposed height). The west abutments for Dodge and Northampton Street Bridges are not considered as part of RW 9.

**INVENTORY, INSPECTION, AND DATA COLLECTION**

| Element                       | Total Qty | Units | Condition State |             |             |               |
|-------------------------------|-----------|-------|-----------------|-------------|-------------|---------------|
|                               |           |       | 1               | 2           | 3           | 4             |
|                               |           |       | <i>GOOD</i>     | <i>FAIR</i> | <i>POOR</i> | <i>SEVERE</i> |
| RW.01 - Entire Wall           | 1         | Each  | 0.69            | 0.28        | 0.03        |               |
| RW.02 - Wall Facing           | 13968     | SF    | 9369            | 4288        | 516         |               |
| RW.03 - Ground Surface, Front | 683       | FT    | 683             |             |             |               |
| RW.04 - Ground Surface, Back  | 683       | FT    | 683             |             |             |               |
| RW.05 - Weep Holes            | N/A       | Each  | ---             | ---         | ---         | ---           |
| 800 - Scour                   | N/A       | FT    | ---             | ---         | ---         | ---           |

PIN 5512.52 Kensington Expressway  
Retaining Wall #9 (RT) along 33WB between Dodge St and West Parade Street

#### INSPECTION RESULTS/ RECOMMENDATIONS

- **Overall Condition State Recommendation: 2 – FAIR**
- PROJECT DOCUMENTATION CAN BE FOUND IN THE ATTACHED SECTIONS

PIN 5512.52 Kensington Expressway  
Retaining Wall #9 (RT) along 33WB between Dodge St and West Parade Street

## Inspection Photos

# PIN 5512.52 – NY33 RETAINING WALL CONDITION EVALUATION 2023 FIELD INSPECTION SUMMARY

Retaining Wall #9 (RT) along 33WB between Dodge St and Northampton St



PHOTO 1  
PANEL 8.3  
Description:  
End RW9. Right of Northampton St bridge west abutment.  
Staining on top panel is typical for all panels.  
Scattered vertical cracks on the bottom three panels.  
Map cracking is present in the top 5 panels near the left joint for 3'.  
There is a 16' vertical crack at midspan of the panel.



PHOTO 2  
PANEL 8.2  
Description:  
Staining on top panel is typical for all panels.  
Scattered map cracking on the bottom three panels.  
Map cracking is present for 3' to 5' from the right joint for the full height. Also, for 3' from the left joint for the top three panels.  
There is a 13' vertical crack at midspan of the panel.  
Panels 8.1 and 7.2 are similar with smaller areas of map cracking.

# PIN 5512.52 – NY33 RETAINING WALL CONDITION EVALUATION 2023 FIELD INSPECTION SUMMARY

Retaining Wall #9 (RT) along 33WB between Dodge St and Northampton St



PHOTO 3  
PANEL 7.3  
Description:  
Staining on top panel is typical for all panels.  
There is map cracking and 70% delamination on the bottom three panels. Map cracking reaches higher near the joints - 5 panels near the right joint, and full height near the left joint.



PHOTO 4  
PANEL 5.3  
Description:  
There are several long vertical / right leaning cracks. Longest is 14'. There is some map cracking near these long cracks and in bottom panel.  
The 7' crack near the right joint is delaminated.  
There is a 1' spall in the fifth panel from the bottom.  
Panel 6.3 is similar without spalls.

# PIN 5512.52 – NY33 RETAINING WALL CONDITION EVALUATION 2023 FIELD INSPECTION SUMMARY

Retaining Wall #9 (RT) along 33WB between Dodge St and Northampton St



PHOTO 5

PANEL 5.2

**Description:**

There are two full height vertical cracks with efflorescence near midspan and several other long cracks. There is some map cracking near these long cracks and in bottom panel.

On one of the full-height cracks there is a 1' spall in the third panel from the bottom.

There are a few isolated areas of delamination.

Panel 6.2 is similar without spalls



PHOTO 6

PANEL 5.1

**Description:**

There are several long vertical / left leaning cracks. Longest is 14'. There is some map cracking near these long cracks and in bottom panel.

There are isolated areas of delamination.

There is a 1' spall in the fifth panel from the bottom and a 2' spall near the bottom right of the panel.

Panel 6.1 is similar without spalls.

# PIN 5512.52 – NY33 RETAINING WALL CONDITION EVALUATION 2023 FIELD INSPECTION SUMMARY

Retaining Wall #9 (RT) along 33WB between Dodge St and Northampton St



PHOTO 7  
PANEL 3.3

Description:

There are several long vertical / right leaning cracks. Longest is 18'.

There is scattered map cracking in the bottom 3 panels. Map cracking extends the full height for 2' near the left joint.

Panel 4.3 is similar.



PHOTO 8  
PANEL 3.2

Description:

There are two full-height vertical cracks with efflorescence, one at midspan and one near the right joint. There are several other long vertical cracks as well.

There is map cracking in the bottom 4 panels, more in the bottom 2. Map cracking extends full height near joints.

Panel 4.2 is similar.

# PIN 5512.52 – NY33 RETAINING WALL CONDITION EVALUATION 2023 FIELD INSPECTION SUMMARY

Retaining Wall #9 (RT) along 33WB between Dodge St and Northampton St



PHOTO 9

PANEL 3.1

**Description:**

There is a full-height vertical / left leaning crack with efflorescence. There are a few other long cracks as well.

The bottom 3 to 5 panels are map cracked. There is full-height map cracking for 1' to 2' from the right joint.

Panel 4.1 is similar.



PHOTO 10

PANEL 2.3

**Description:**

There is an 11' long vertical / right leaning crack.

There is scattered map cracking throughout. More concentrated near the left joint and long cracks.

# PIN 5512.52 – NY33 RETAINING WALL CONDITION EVALUATION 2023 FIELD INSPECTION SUMMARY

Retaining Wall #9 (RT) along 33WB between Dodge St and Northampton St



PHOTO 11

PANEL 2.2

**Description:**

There is a full-height vertical crack with efflorescence near midspan of the panel. There are a few other long vertical cracks.

Map cracking bottom 4 panels. Map cracking extends full-height near joints and center of panel.



PHOTO 12

PANEL 2.1

**Description:**

Map cracking throughout. More concentrated near joints and on bottom 3 panels. A few more prominent vertical cracks 4' to 7' in length.

# PIN 5512.52 – NY33 RETAINING WALL CONDITION EVALUATION 2023 FIELD INSPECTION SUMMARY

Retaining Wall #9 (RT) along 33WB between Dodge St and Northampton St



PHOTO 13  
PANEL 1.2  
Description:  
Full-height crack and 5' crack with efflorescence near midspan of panel.  
Map cracking bottom 4 panels. Map cracking extends to full-height near left joint and full-height crack.  
Small spall 6' off the ground closer to left joint.

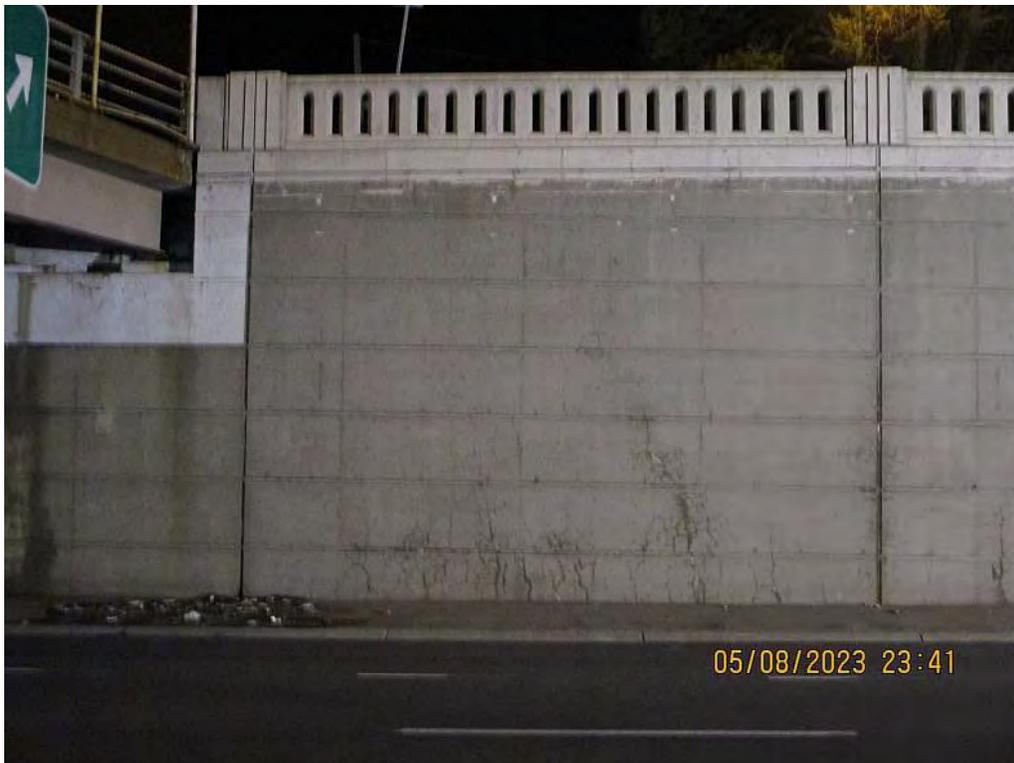


PHOTO 14  
PANEL 1.1  
Description:  
Begin RW9. Left of Dodge St bridge west abutment.  
There is a 13' long vertical / left leaning crack with 2' wide delamination in the bottom panel.  
There is a 5' high isolated area of delamination near the right joint.  
Map cracking bottom 4 panels.  
Small spall 6' off the ground closer to left joint.

PIN 5512.52 Kensington Expressway  
Retaining Wall #9 (RT) along 33WB between Dodge St and West Parade Street

## Field Sheets




 delaminated

Map Cr. bot 4 pnls, full height near crack and left joint

Map Cr. bot 4 panels

MATCH LINE - DOODGE ST BRIDGE

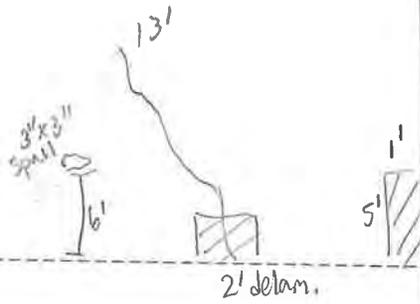

(7 panels)

1.1

(7 panels)


PANEL 1  
(3 SECTIONS)

1.2

(7 panels) 1.3

full height crack w/ effl.

- Map Cr. bot 3 pnls, scattered map cr. throughout
- Effl. in bot. pnl cracks

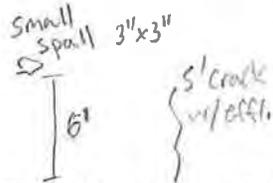

MATCH LINE



(7 panels)

2.1

Map Cr. bot 4 pnls, full height near center and joints

(8 panels)

PANEL 2  
(3 SECTIONS)

2.2


full height crack w/ effl.

speed limit sign

RW 9 PANELS 1-2

(8 panels)


2.3

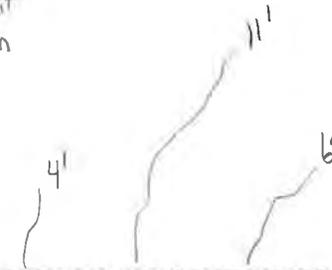

(bot pnl 1')  
Map Cr throughout, worst at bot 3 pnls and near joints

(bot pnl 1') (top pnl ends hwy)

Map cracking throughout, especially near left joint

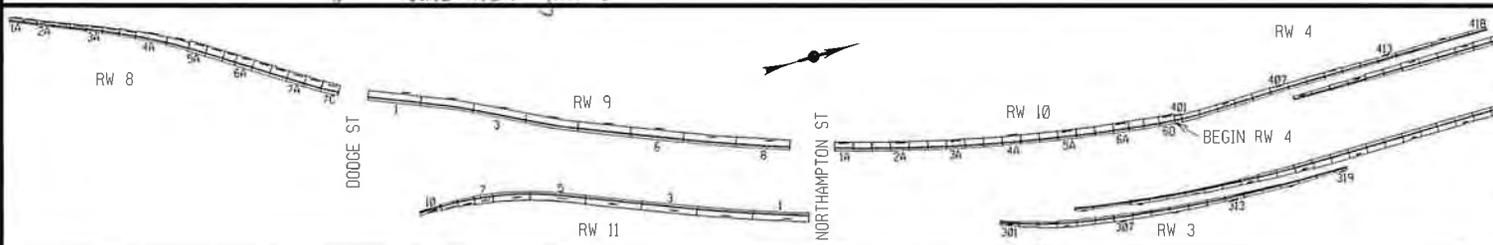

BY: RIM  
DATE: 5/9/23  
SCALE: 1' = 10'


- Map Cr. Bot 5 pnts, worst for bot 3
- Map Cr. near right jnt 1' to 2'

- Map Cr. bot 4 pnts, worst for bot 2
- Map Cr. full height near jnts


full height cracks behind sign w/ effl.

- Scattered Map Cr. bot 3 pnts
- Map Cr. full height for 2' from left jnt


MATCH LINE

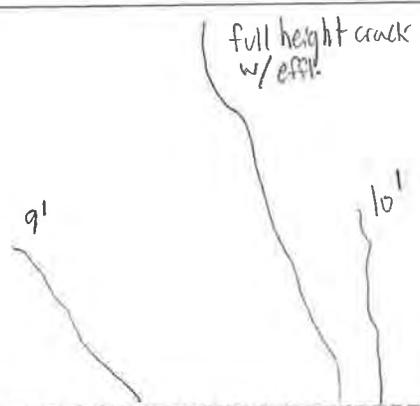

(8 panels) 3.1  
(Bot pnt 6")

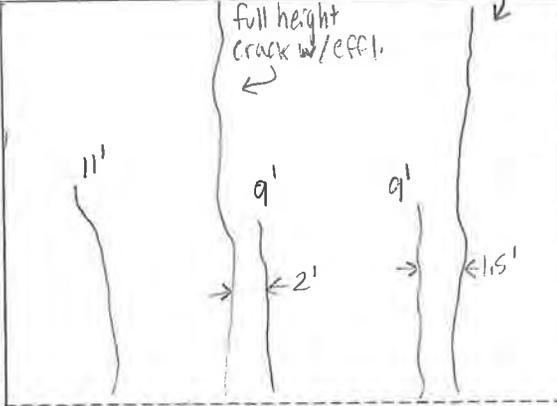


(7 pnts) 3.2  
PANEL 3 (3 SECTIONS)  
RT33 Sign

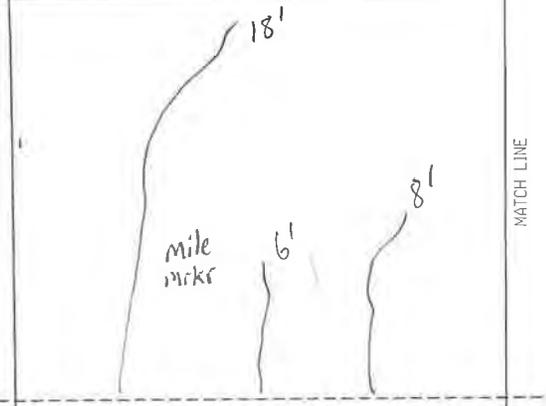


(7 panels) 3.3

MATCH LINE


MATCH LINE

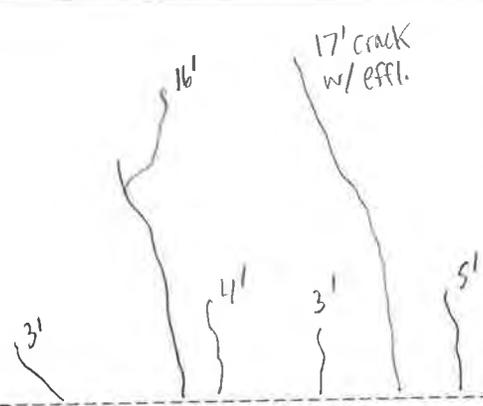

4.1  
Minimal Map cr. bot pnt

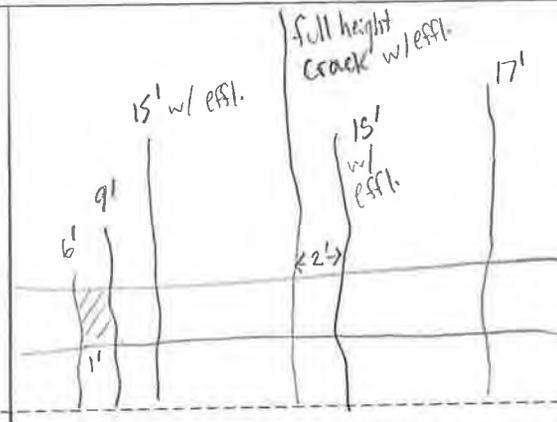


4.2  
PANEL 4 (3 SECTIONS)  
Map Cr. bot 3 pnts, higher near cracks

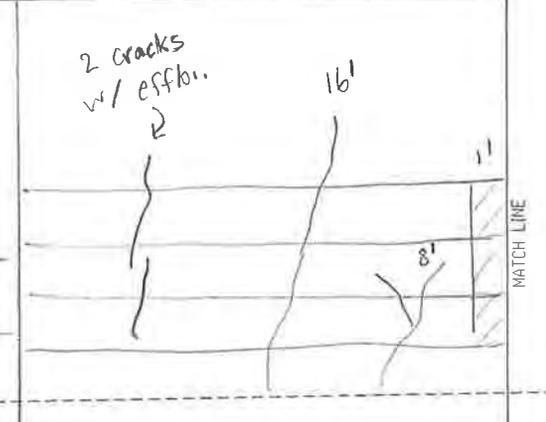



(7 panels) 4.3  
Map cracking bot 4 pnts, worse for bot 2

MATCH LINE


RW 9 PANELS 3-4

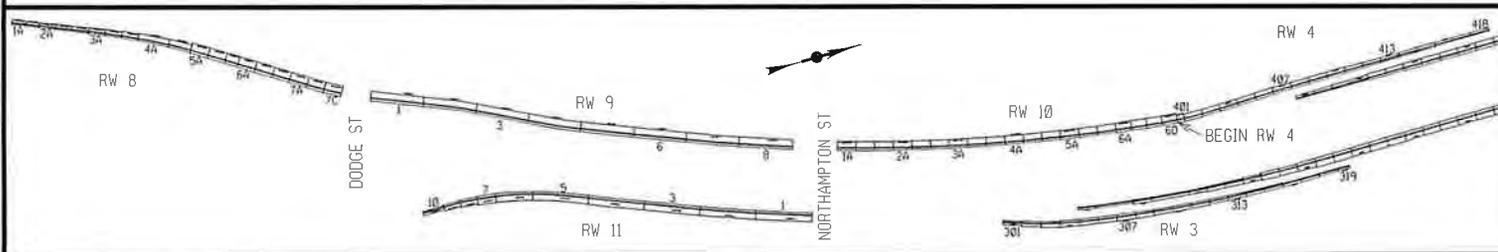

BY: RM  
DATE: 5/9/23  
SCALE: 1" = 10'

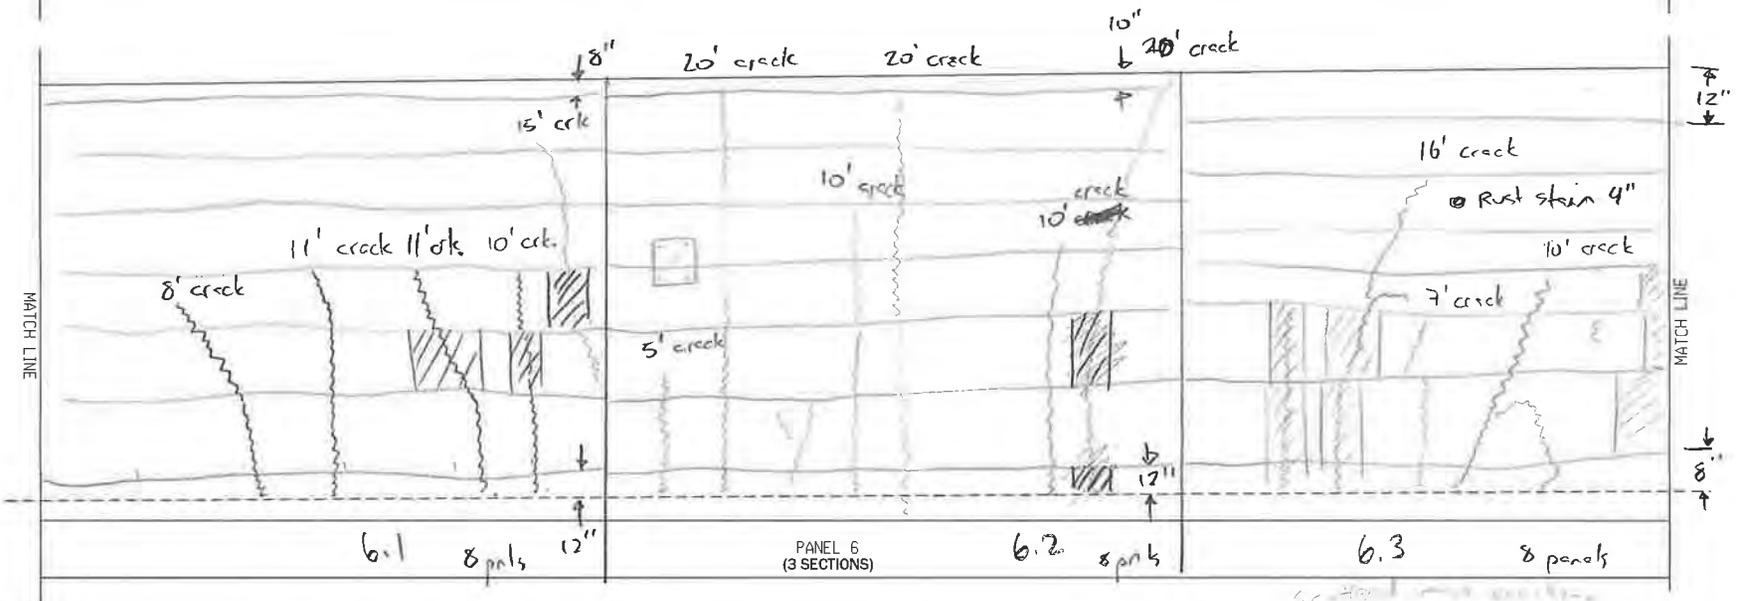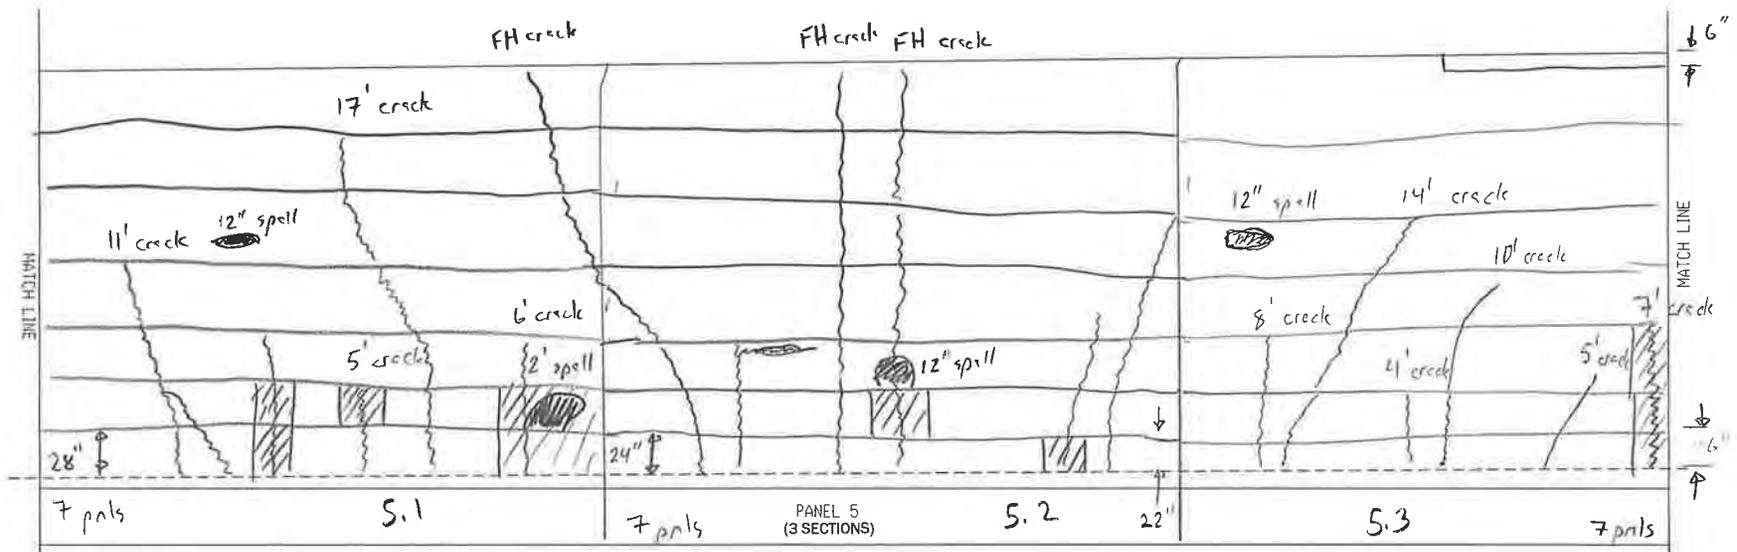

RW 9 PANELS 5-6

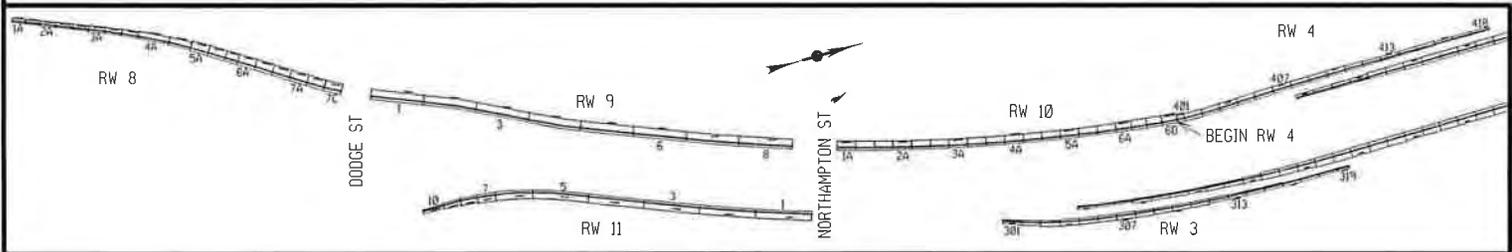


BY: CM  
 DATE: 5/9/23  
 SCALE: 1" = 10'

General Note: Staining on Top PNL

• Sparse Map Cr. bot 2 pnls

• Sparse vert. cracks bot 2 pnls

• Map cracking bot 3 pnls, 5 pnls near right joint, full height near left joint (3 to 4' from joint)

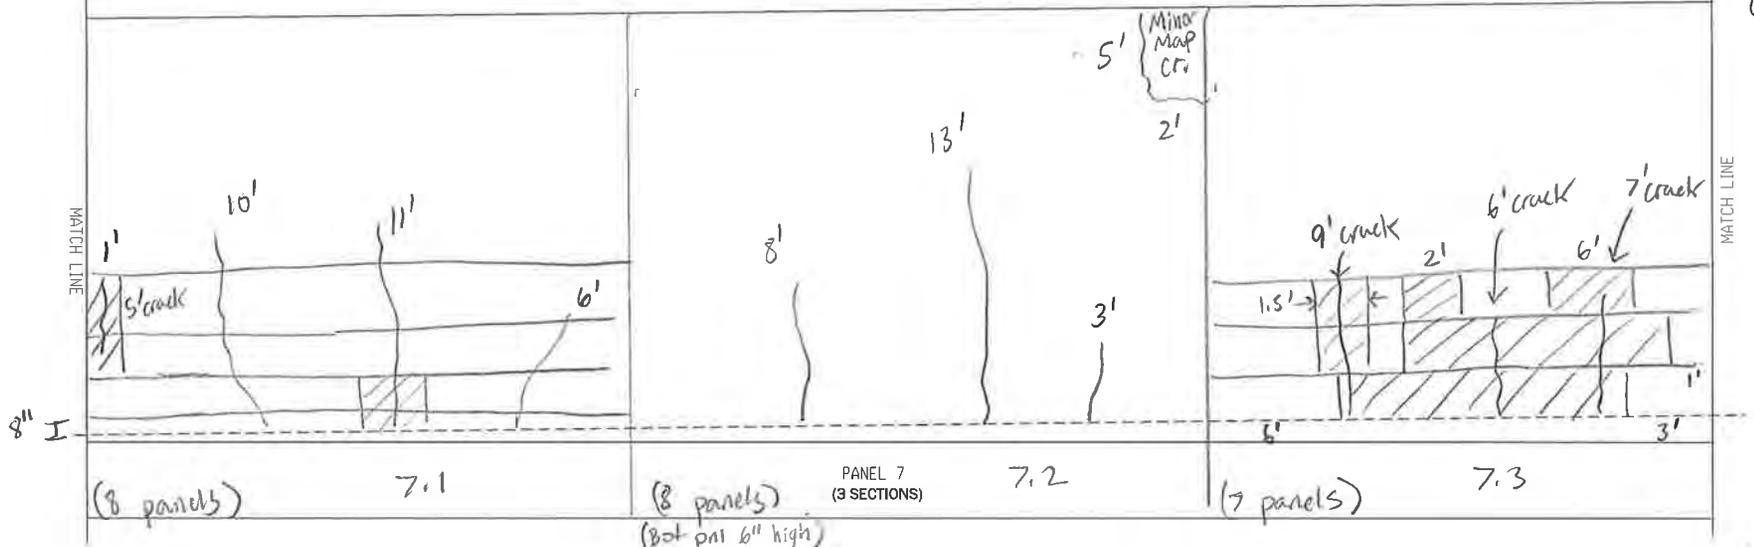

(8 panels)

7.1

(8 panels)


PANEL 7  
(3 SECTIONS)

7.2

(7 panels)

7.3

(Bot pnt 6" high)

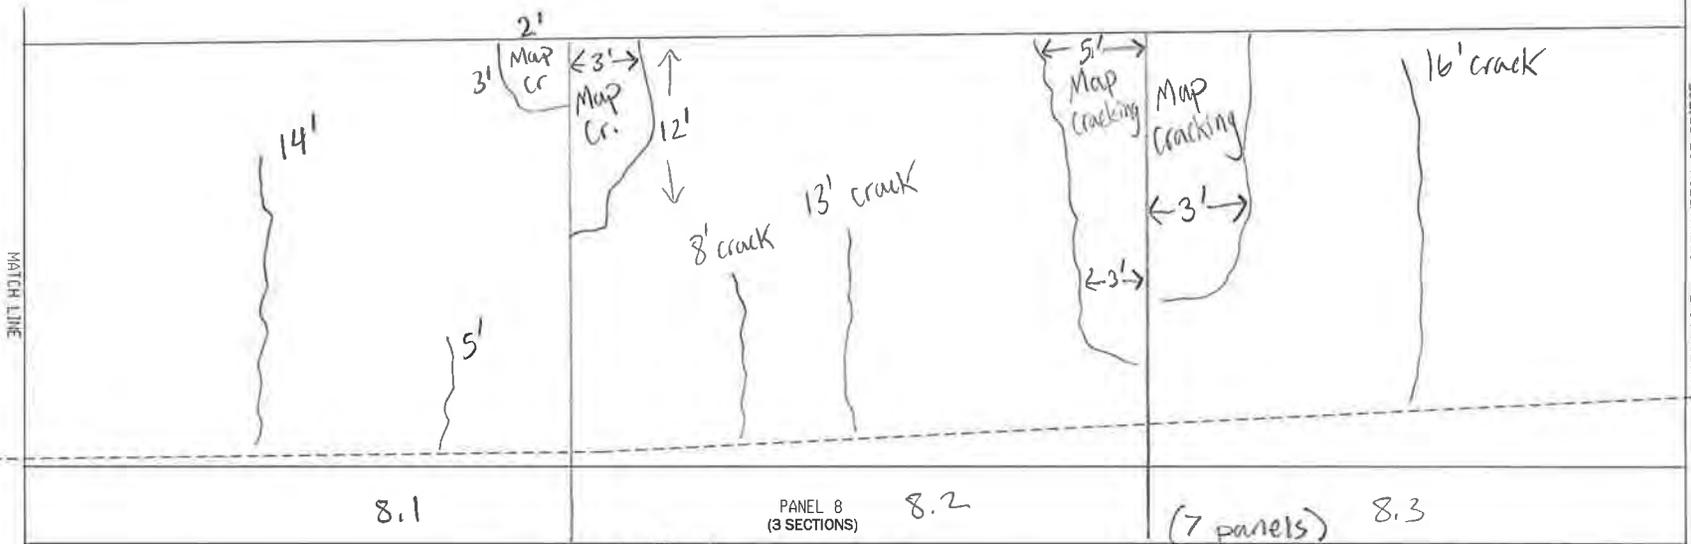

8.1

PANEL 8  
(3 SECTIONS)

8.2

(7 panels)


8.3

• Scattered vert. cracks bot pnt

• Scattered map cracking bot 3 pnls

• Scattered vert. cracks bot 3 pnls

RW 9 PANELS 7-8

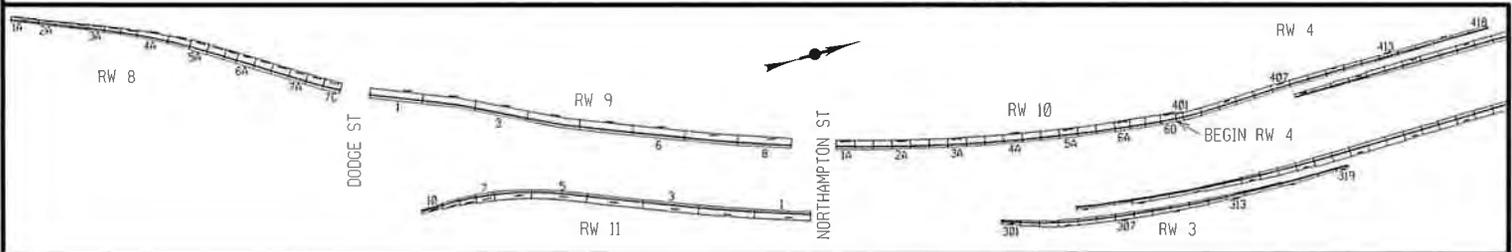

BY: RIM  
 DATE: 5/9/23  
 SCALE: 1" = 10'

PIN 5512.52 Kensington Expressway  
Retaining Wall #9 (RT) along 33WB between Dodge St and West Parade Street

## Calculations



300 State Street, Suite 201 • Rochester, NY 14614  
 Phone 585.454.6110 • Fax 585.454.3066  
 www.labellapc.com

PROJECT  
 PIN

|                        |              |
|------------------------|--------------|
| Kensington Inspections |              |
| 5512.52                | CALC. BY RIM |
| DATE                   | 5/26/2023    |

Condition Estimates

- Retaining Wall 9
  - Condition 2 - map cracks, stains, isolated delam, minor cracks
  - Condition 3 - spalls, widespread delam, major cracks
  - Areas with multiple forms of deterioration were measured under only one category. Condition 3 categories were prioritized over condition 2.

| Panel       | Minor/Map Crack (sf) | Major Cracks (ft) | Spalls (sf) | Widespread Delam (sf) | Other (staining, efflor., etc.) |                       |                      |
|-------------|----------------------|-------------------|-------------|-----------------------|---------------------------------|-----------------------|----------------------|
| 1.1         | 228.94               | 13                | 0.06        | 11                    |                                 |                       |                      |
| 1.2         | 180.94               | 18                | 0.06        |                       |                                 |                       |                      |
| 1.3         | 198                  |                   |             |                       |                                 |                       |                      |
| 2.1         | 191                  |                   |             |                       |                                 |                       |                      |
| 2.2         | 163                  | 19                |             |                       |                                 |                       |                      |
| 2.3         | 285                  |                   |             |                       |                                 |                       |                      |
| 3.1         | 223.5                | 19                |             |                       |                                 |                       |                      |
| 3.2         | 174                  | 38                |             |                       |                                 |                       |                      |
| 3.3         | 99                   |                   |             |                       |                                 |                       |                      |
| 4.1         | 46                   | 16                |             |                       |                                 |                       |                      |
| 4.2         | 180                  | 45                |             | 3                     |                                 |                       |                      |
| 4.3         | 240                  | 12                |             | 9                     |                                 |                       |                      |
| 5.1         | 225                  | 21                | 3           | 36                    |                                 |                       |                      |
| 5.2         | 300                  | 71                | 1           | 10                    |                                 |                       |                      |
| 5.3         | 202                  | 32                | 1           | 7                     |                                 |                       |                      |
| 6.1         | 188                  | 31                |             | 12                    |                                 |                       |                      |
| 6.2         | 341                  | 60                |             | 4                     |                                 |                       |                      |
| 6.3         | 111                  |                   |             | 46                    |                                 |                       |                      |
| 7.1         | 40                   |                   |             | 14                    |                                 |                       |                      |
| 7.2         | 43                   |                   |             |                       |                                 |                       |                      |
| 7.3         | 115.5                |                   |             | 160.5                 |                                 |                       |                      |
| 8.1         | 33.5                 |                   |             |                       |                                 |                       |                      |
| 8.2         | 154                  |                   |             |                       |                                 |                       |                      |
| 8.3         | 120.5                |                   |             |                       |                                 |                       |                      |
| General     | 204.9                |                   |             |                       |                                 |                       |                      |
| Total (sf): | 4287.78              | 197.50 (sf)       | 5.13        | 312.50                | 0.00                            | <b>COND 2</b><br>4288 | <b>COND 3</b><br>516 |

PIN 5512.52 Kensington Expressway  
Retaining Wall #9 (RT) along 33WB between Dodge St and West Parade Street

# Wall Inventory Sheet

## INVENTORY, INSPECTION, AND DATA COLLECTION

|                                  |   | WALL INSPECTION LOCATION INFORMATION & NOTES |
|----------------------------------|---|--|
| PRIMARY OWNER                    | NYS DOT - New York State Department of Transportation   |  |
| REGION                           | 05-Region 05 - Buffalo  |  |
| COUNTY                           | 3-County 3 - Erie   |  |
| RESIDENCY                        | 534 - Erie North Residency  |  |
| NYS ROUTE                        | Rte. 33   |  |
| REFERENCE MARKER                 | 3353011028  |  |
| LONGITUDE                        | 78.84417  |  |
| LATITUDE                         | 42.90724  |  |
| ADDITIONAL LOCATION DESCRIPTION  | Located along the W.B. mainline right shoulder between Dodge and Northampton Streets and supports S.B. Humboldt Parkway (approximately 683 ft. long, 22 ft. maximum exposed height). The west abutments for the Dodge and Northampton Street Bridge Overpasses are not considered as part of RW #9. |  |
| TYPE OF SERVICE PROVIDED         | Support/Protect a Roadway   |  |
| WALL TYPE                        | Cantilever - Concrete   |  |
| LEGACY RETAINING WALL TYPE       |   |  |
| WALL FACING TYPE                 | Cast - in -Place Concrete   |  |
| WALL BACKFILL REINFORCEMENT TYPE | N/A   |  |
| ADDITIONAL WALL DESCRIPTION      |   |  |
| WALL LENGTH                      | 680 FT  |  |
| WALL MAXIMUM HEIGHT              | 22 FT   |  |
| WALL AREA                        | 17560 SF  |  |
| YEAR BUILT                       | 1960  |  |
| CONTRACT NUMBER                  | FAC 59-19   |  |
| AADT                             | 82,171  |  |
| QC REVIEWER                      |   |  |
| QC APPROVED DATE                 |   |  |
| SITE ACCESS NOTES                | With WZTC in place to close the adjacent shoulder and travel lane, access was performed by walking and extension ladder.  |  |
| INSPECTION FREQUENCY             |   |  |
| LAST INSPECTION STATUS           |   |  |
| INSTRUMENTED                     | N/A   |  |
| MONITORED BY                     | ----  |  |
| INSTRUMENTATION COMMENT          | ----  |  |
| CONSEQUENCE OF FAILURE           | 3-Major   |  |
| WALL POSITION                    | Between Roads   |  |
| GENERAL NOTES                    |   |  |
| RETAINING WALL DATABASE ID       |   |  |
| NUMBER OF ERRORS AND WARNINGS    |   |  |
| USER UPDATE                      |   |  |
| SUBMISSION DATE                  |   |  |
| DATE UPDATE                      |   |  |



**NY33 RETAINING WALL CONDITION EVALUATION 2023**  
**KENSINGTON EXPRESSWAY PROJECT**  
**PIN 5512.52**  
**CITY OF BUFFALO, ERIE COUNTY**  
**RETAINING WALL 10**



Prepared By:

Merton J. Edwards, PE (NYSPE 064981)  
Inspection Team Leader | Sr. Structural Engineer  
Date: 5/30/2023

Reviewed By:

Stephen L. Gauthier, PE (NYSPE 0075775)  
Quality Control Engineer | Sr. Structural Engineer  
Date: 6/16/2023

 **LaBella**  
Powered by partnership.  
300 State Street  
Rochester, New York 14614  
ph: 585-454-6110  
[www.labellapc.com](http://www.labellapc.com)

# PIN 5512.52 – NY33 RETAINING WALL CONDITION EVALUATION 2023 FIELD INSPECTION SUMMARY

STRUCTURE: Retaining Wall #10 (RT) along 33WB between Northampton St and on ramp from Humboldt Parkway to Rte 33 WB

STRUCTURE TYPE: Reinforced Concrete Cantilever Wall on Piles  
Year Built: 1960

CURRENT INSPECTION: 05/01/23 – 5/09/23 (LaBella Inspections)

LAST KNOWN INSPECTION: Unknown

CONDITION STATE: FAIR

## RETAINING WALL INSPECTION & DOCUMENTATION:

Inspection of the retaining walls will be in conformance with the NYSDOT Retaining Wall Inventory and Inspection Program Manual, October 2018. Inspection of the following elements will be inspected and documented as appropriate:

### - Inspection:

The following procedure will be followed for the inspection of retaining walls:

- Walls were checked for signs of settlement, rotation, or bulging. Walls faces were checked for vertical alignment using a smart level. The walls being evaluated are vertical with no batter.
- Construction joints between sections of the wall were examined for misalignment, and near the ground line for fill material washing out from between panels or joint.
- Walls were inspected for erosion material in front of the wall, for heaving of material in front of the wall, and for settlement of fill behind the wall.
- Examined the wall for deterioration of the material, such as cracking, spalling, and/or corrosion, noting the width, length, depth, and/or orientation of the deterioration. Photographs are provided, documenting defects found.
- Wall façades were reviewed for evidence of water seepage, efflorescence, or rust staining.
- Examined the base of walls for evidence of water flow where the water table may be within the retained earth.
- Examined and probed drains for signs of clogging. Examined drainage around ends of wall and note if embankments have been experiencing erosion.
- Examined site grading for any locations that may prohibit proper drainage from behind the wall looking for evidence of ponding above the wall, such as debris accumulation in the lower spots.
- Ascertain why water is not draining properly and note in the inspection.
- Inspected roadway components above wall for signs of joint separation, potholes, and areas of settlement.
- Examined vegetation growth along and above the wall for root infiltration creating undesirable stresses on the wall. Documented any induce cracking, bulging or failure.
- Examined the wall system for vehicular damage and document the location and degree of damage.

PIN 5512.52 Kensington Expressway  
 Retaining Wall #10 (RT) along 33WB  
 between Northampton St and on ramp from Humboldt Parkway to Rte 33 WB

GENERAL OBSERVATIONS:

1. Retaining Wall Panels are generally 30 ft in length with horizontal chamfered panels spaced 3'-0" vertically, from the top of the wall. There is some variation in panel length due to the location of bridges within the corridor. For specific panel lengths see the DOCUMENTION Section of this report.
2. The lower 6-12 ft of the subject retaining wall was found to be in FAIR condition with scattered map cracking, dampness, and small areas of delamination. For specific conditions found and photographs of the wall panels, see the DOCUMENTION Section of this report.
3. The upper portions of theses wall panels were generally found to be in GOOD condition with the exception of a few locations. About one third of the panels were found to have map cracking near the joint for the upper-half to full-height of the panel. . For specific conditions found, photographs of the of wall panels, and condition calculations see the attached sections of this report.
4. The panels were typically found to have a full-height or mid-height vertical crack near midspan of the panel.

| General:                    |             |
|-----------------------------|-------------|
| DEFECT                      | DESCRIPTION |
| Misalignment                | None noted. |
| Settlement                  | None noted. |
| Sinkhole (cavity) Formation | None noted. |

| Concrete Cracks:                                     |   |
|--|---|
| DEFECT   | DESCRIPTION   |
| Insignificant Cracks<br>(cracks < 0.012 inches wide) | A few panels have minor vertical cracking. The location of the cracks mirrors the rebar placement.  |
| Map cracks   | Most panels have scattered/sparse map cracking in the bottom 2 to 4 panels (6'-12').<br><br>Some panels have isolated areas of heavier map cracking near larger vertical cracks and joints. |
| Moderate Cracks<br>(0.012 - 0.05 inches wide)        | Most panels have a 2/3-height to full-height vertical crack near midspan of the panel.  |
| Wide Cracks<br>(cracks > 0.05 inches wide)           | None noted.   |

PIN 5512.52 Kensington Expressway  
 Retaining Wall #10 (RT) along 33WB  
 between Northampton St and on ramp from Humboldt Parkway to Rte 33 WB

| Additional Concrete Distress: |   |
|-------------------------------|---|
| DEFECT                        | DESCRIPTION   |
| Spalling / Delamination       | Areas of spalling and delamination are minimal. Spalls are present on panels 3A and 4A and isolated delamination is present on panels 4C, 6B, and 6D. |
| Staining                      | The top panel has minor staining throughout.<br><br>A few isolated areas of rust staining are present.  |
| Exposed Rebar                 | None noted.   |

**Notes:**

RW 10 consists of 19 panels numbered from 1A (South) to 6D (North). The retaining wall supports the S.B. Humboldt Parkway above State Route 33 (Kensington Expressway).

Located along the right side of W.B. Kensington Expressway from Northampton St Bridge to retaining wall 4 panel 401 (Approximately 550 ft. long, 19 ft. maximum exposed height). The west abutment of Northampton St Bridge is not included as part of retaining wall 10.

**INVENTORY, INSPECTION, AND DATA COLLECTION**

| Element                       | Total Qty | Units | Condition State |             |             |               |
|-------------------------------|-----------|-------|-----------------|-------------|-------------|---------------|
|                               |           |       | 1               | 2           | 3           | 4             |
|                               |           |       | <i>GOOD</i>     | <i>FAIR</i> | <i>POOR</i> | <i>SEVERE</i> |
| RW.01 - Entire Wall           | 1         | Each  | 0.78            | 0.21        | 0.01        |               |
| RW.02 - Wall Facing           | 9617      | SF    | 7302            | 2267        | 48          |               |
| RW.03 - Ground Surface, Front | 550       | FT    | 550             |             |             |               |
| RW.04 - Ground Surface, Back  | 550       | FT    | 550             |             |             |               |
| RW.05 - Weep Holes            | 1         | Each  |                 |             | 1           |               |
| 800 - Scour                   | N/A       | FT    | ---             | ---         | ---         | ---           |

PIN 5512.52 Kensington Expressway  
Retaining Wall #10 (RT) along 33WB  
between Northampton St and on ramp from Humboldt Parkway to Rte 33 WB

#### INSPECTION RESULTS/ RECOMMENDATIONS

- **Overall Condition State Recommendation: 2 – FAIR**
- PROJECT DOCUMENTATION CAN BE FOUND IN THE ATTACHED SECTIONS

PIN 5512.52 Kensington Expressway  
Retaining Wall #10 (RT) along 33WB  
between Northampton St and on ramp from Humboldt Parkway to Rte 33 WB

## Inspection Photos

# PIN 5512.52 – NY33 RETAINING WALL CONDITION EVALUATION 2023 FIELD INSPECTION SUMMARY

Retaining Wall #10 (RT) along 33WB between Northampton Street and Utica Street Bridges



PHOTO 1  
PANEL 6D

Description:

End RW10. Connects to RW4.

Staining on top panel typical for entire wall.

There is a 6' vertical crack with 1' wide delamination.

There is scattered rust staining on chamfers between panels 1 and 2, and 2 and 3.



PHOTO 2  
PANEL 6A

Description:

Staining on top panel typical for entire wall.

There is a 8' vertical / right leaning crack.

Map cracking on top 2 panels.

Panel 6B is similar.

# PIN 5512.52 – NY33 RETAINING WALL CONDITION EVALUATION 2023 FIELD INSPECTION SUMMARY

Retaining Wall #10 (RT) along 33WB between Northampton Street and Utica Street Bridges



PHOTO 3  
PANEL 5B  
Description:  
Full-height crack at midspan of panel.  
Scattered map cracking throughout. Heavier map cracking around center crack and for 3' from either joint.



PHOTO 4  
PANEL 4C  
Description:  
Full-height crack to right of sign. Delaminated 3' wide for bottom 7'.  
Map cracking throughout.

# PIN 5512.52 – NY33 RETAINING WALL CONDITION EVALUATION 2023 FIELD INSPECTION SUMMARY

Retaining Wall #10 (RT) along 33WB between Northampton Street and Utica Street Bridges



PHOTO 5  
PANEL 4B

Description:

There is a 12' vertical crack near midspan of the panel.

Map cracking throughout, heaviest near joints.

Rust staining under the luminaire.



PHOTO 6  
PANEL 3C

Description:

Scattered vertical cracks on bottom 3 panels. Map cracking near left joint on top 3 panels.

Weep hole is in poor condition with debris build-up and a crack through the weep hole.

# PIN 5512.52 – NY33 RETAINING WALL CONDITION EVALUATION 2023 FIELD INSPECTION SUMMARY

Retaining Wall #10 (RT) along 33WB between Northampton Street and Utica Street Bridges



PHOTO 7  
PANEL 3A

Description:

There are 11' and 12' vertical cracks.

Map cracking bottom on bottom 2 panels. Scattered map cracking on panels 3 and 4.

There is a small spall with rust staining near the left joint.

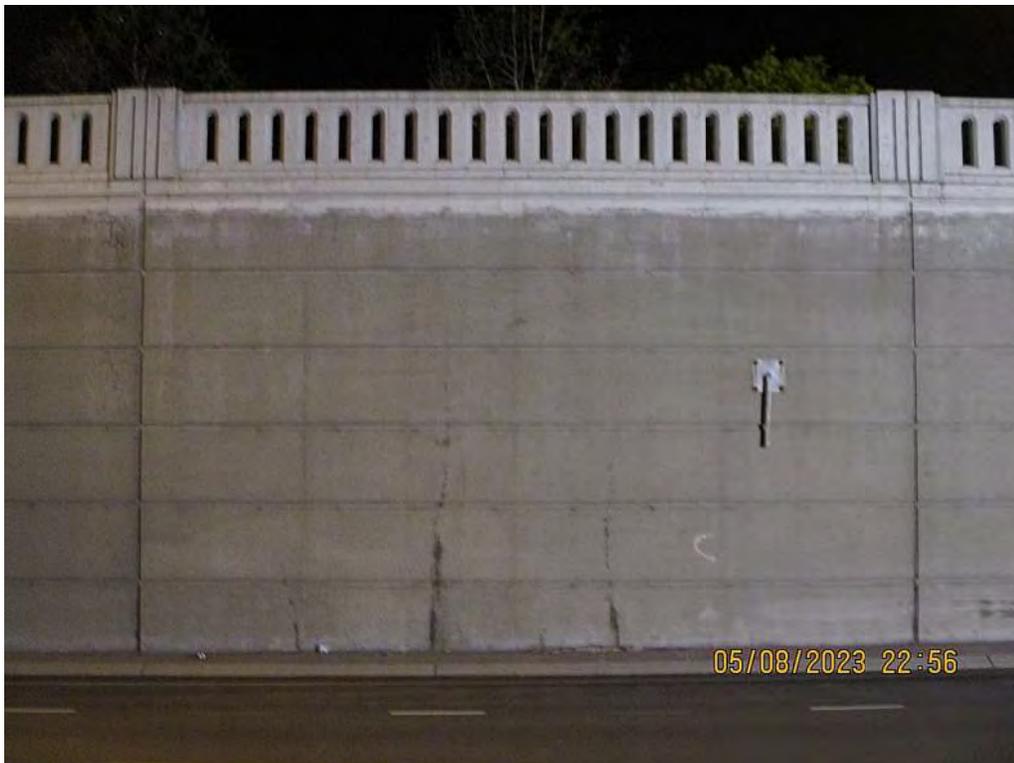


PHOTO 8  
PANEL 2B

Description:

There is a 4', 13', and 9' vertical crack with minor map cracking nearby.

# PIN 5512.52 – NY33 RETAINING WALL CONDITION EVALUATION 2023 FIELD INSPECTION SUMMARY

Retaining Wall #10 (RT) along 33WB between Northampton Street and Utica Street Bridges



PHOTO 9  
PANEL 2A

Description:

There is a 15' crack under the luminaire.

Staining on top panel typical for entire wall.

Scattered map cracking on the bottom 2 panels. More concentrated map cracking for 2' from the right joint.

Panels 2C is similar with map cracking near the left joint instead.



PHOTO 10  
PANEL 1A

Description:

Begin RW10. Right of Northampton St bridge west abutment.

Staining on top panel typical for entire wall.

There is a 15' and 8' vertical crack near midspan of the panel.



Scattered map cracking on the bottom 4 panels.

PIN 5512.52 Kensington Expressway  
Retaining Wall #10 (RT) along 33WB  
between Northampton St and on ramp from Humboldt Parkway to Rte 33 WB

## Field Sheets

FILE NAME = \\06cashlab\06\02150716.01 kensington Preliminary Design\Drawings\Highway\Plan\set2\0551252\_cph\_pin\_1ftA.dgn  
 DATE = 2/7/2023  
 TIME = 12:56:26 PM

PROJECT MANAGER  
 CHECK  
 DRAFTING  
 CHECK  
 DESIGN  
 JOB MANAGER  
 DESIGN SUPERVISOR

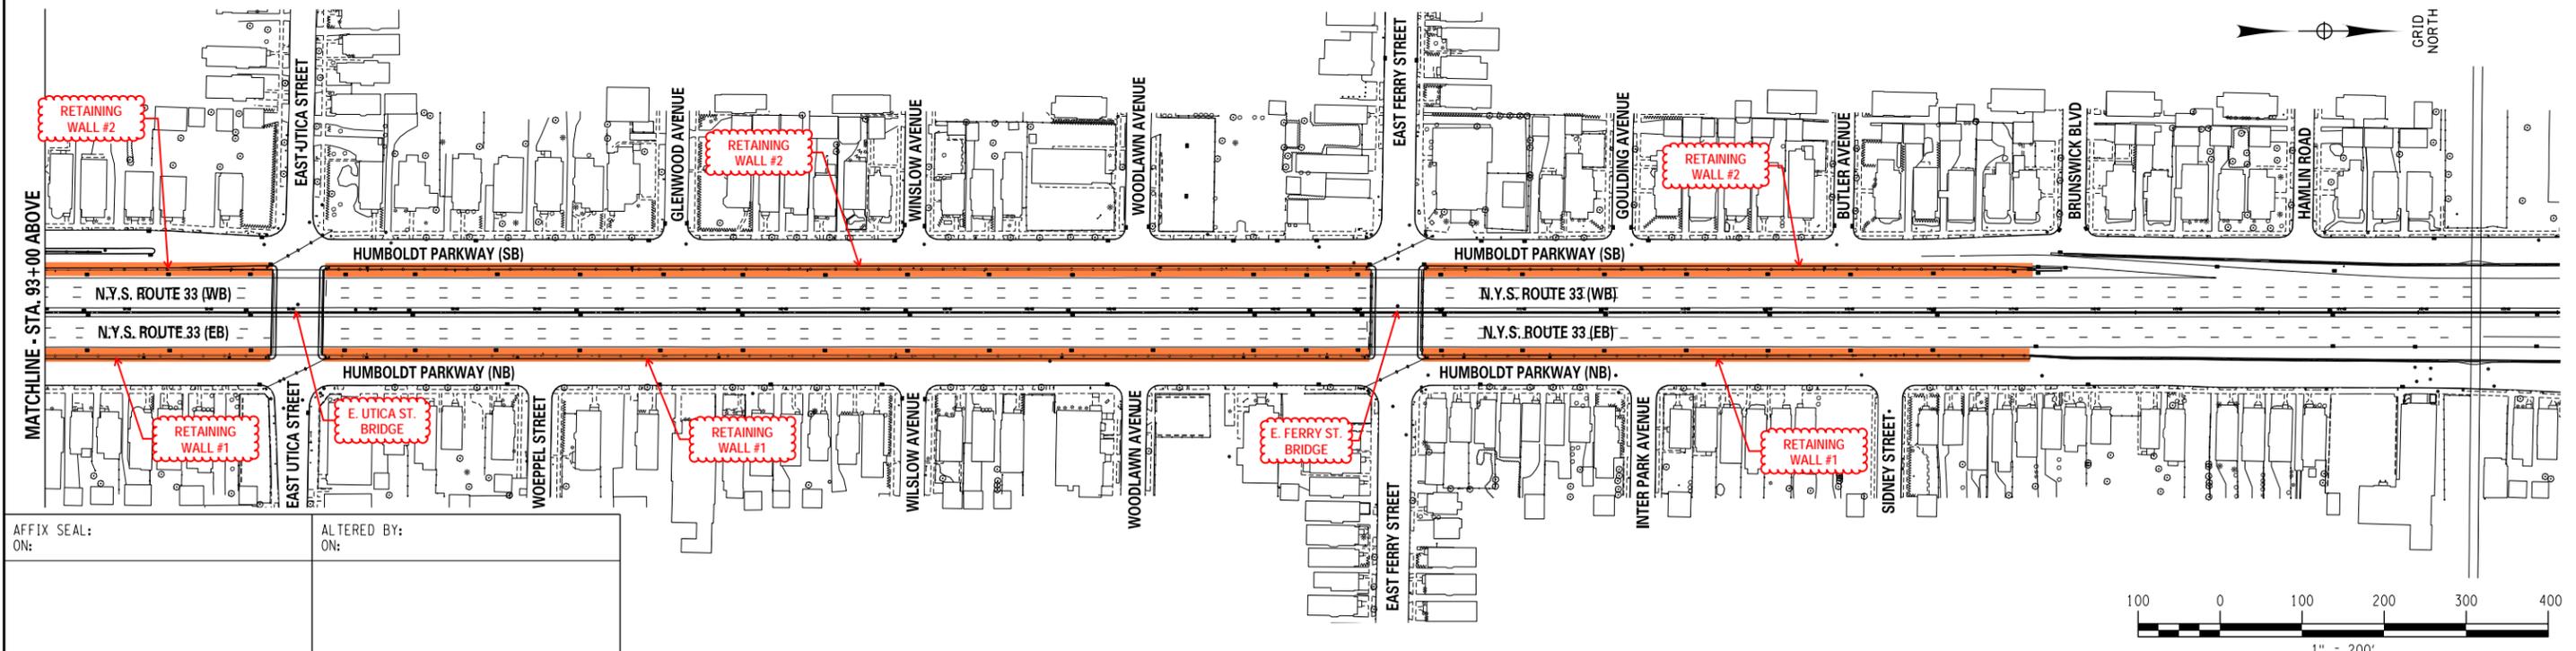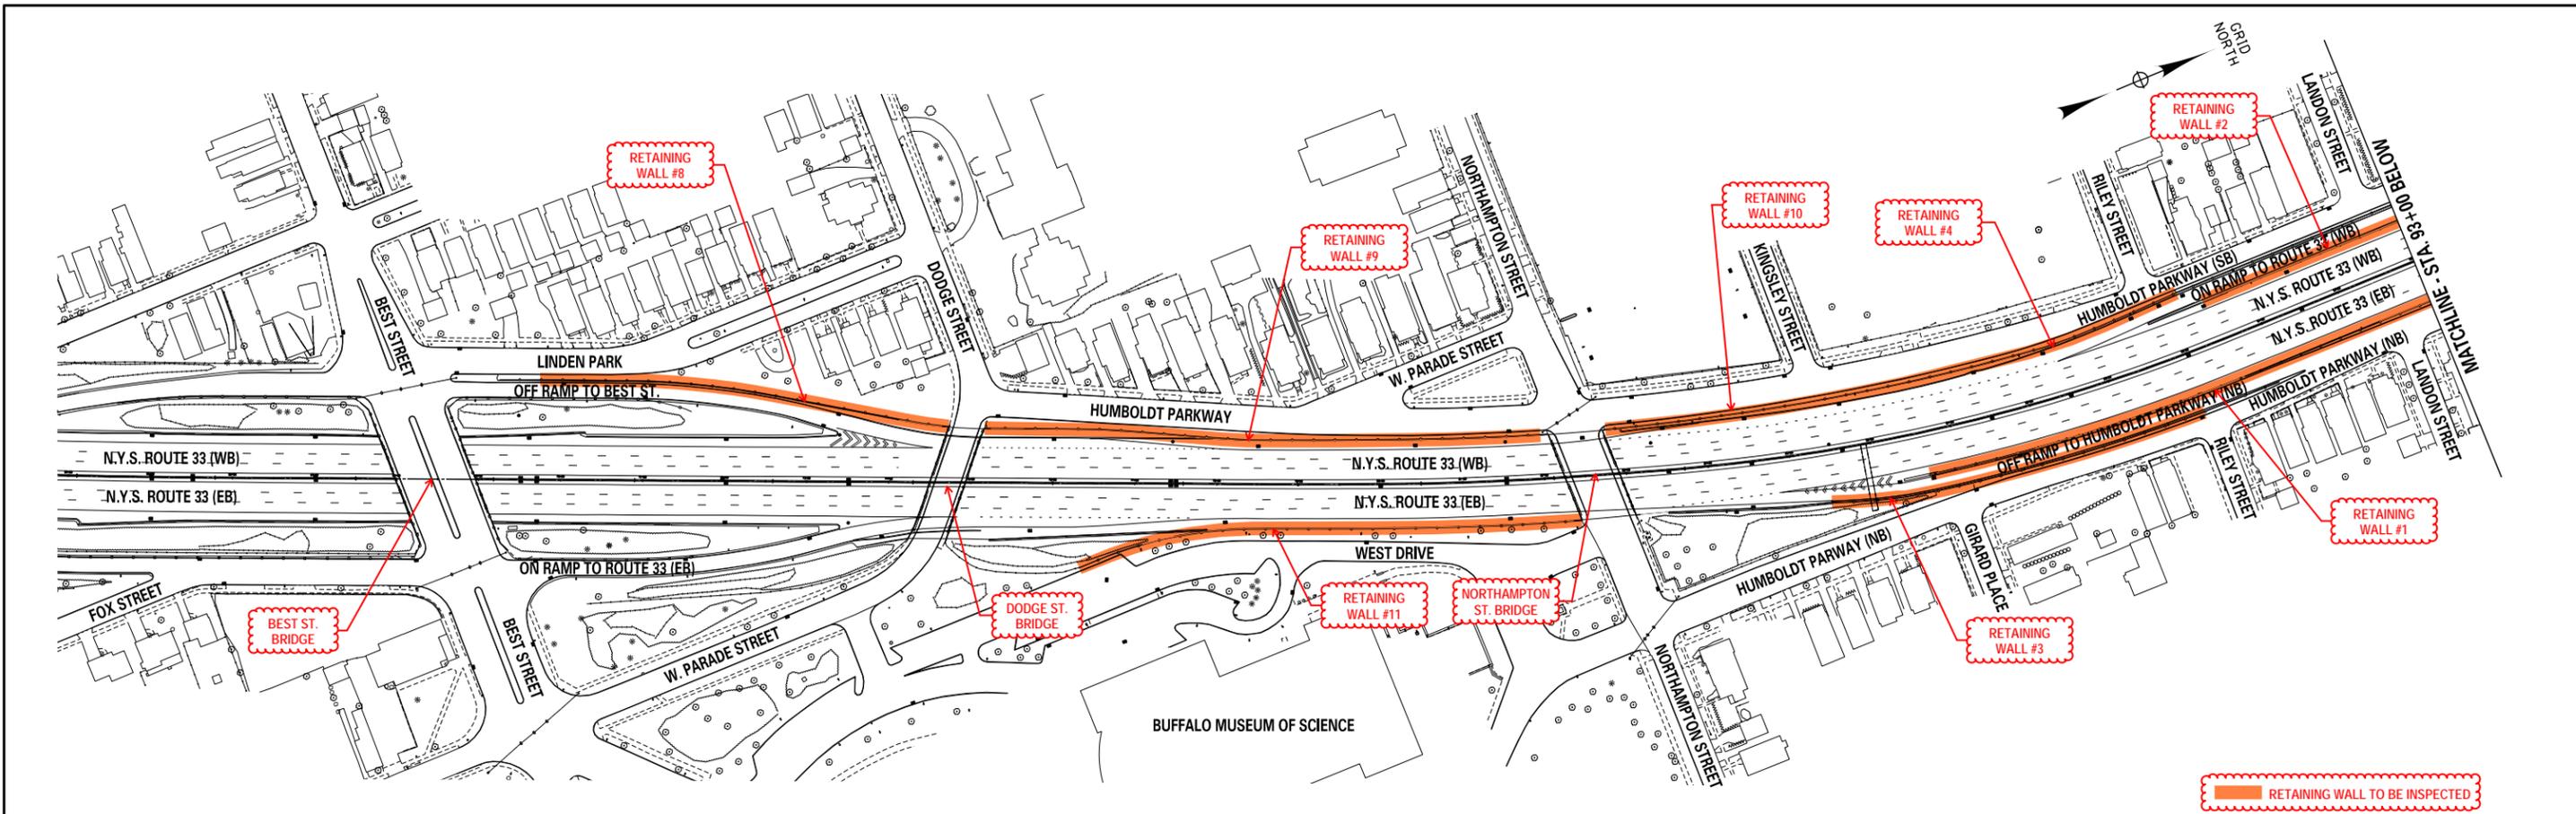

AFFIX SEAL: ON:  
 ALTERED BY: ON:




|  |                       |             |         |          |   |                 |
|--|-----------------------|-------------|---------|----------|---|-----------------|
| AS-BUILT REVISIONS<br>DESCRIPTION OF ALTERATIONS:  | STATE ROUTE 33        | PIN 5512.52 | BRIDGES | CULVERTS | ALL DIMENSIONS IN FT UNLESS OTHERWISE NOTED | CONTRACT NUMBER |
|  | KENSINGTON EXPRESSWAY |             |         |          |   |                 |
|  | CITY OF BUFFALO       |             |         |          |   |                 |
|  | COUNTY: ERIE          |             |         |          |   |                 |
| IT IS A VIOLATION OF LAW FOR ANY PERSON, UNLESS THEY ARE ACTING UNDER THE DIRECTION OF A LICENSED PROFESSIONAL ENGINEER, ARCHITECT, LANDSCAPE ARCHITECT, OR LAND SURVEYOR, TO ALTER AN ITEM IN ANY WAY. IF AN ITEM BEARING THE STAMP OF A LICENSED PROFESSIONAL IS ALTERED, THE ALTERING ENGINEER, ARCHITECT, LANDSCAPE ARCHITECT, OR LAND SURVEYOR SHALL STAMP THE DOCUMENT AND INCLUDE THE NOTATION "ALTERED BY" FOLLOWED BY THEIR SIGNATURE, THE DATE OF SUCH ALTERATION, AND A SPECIFIC DESCRIPTION OF THE ALTERATION. |                       |             |         |          |   |                 |
| <b>KENSINGTON EXPRESSWAY<br/>         RETAINING WALL LOCATION PLAN</b>   |                       |             |         |          | DRAWING NO. 1<br>SHEET NO.                  |                 |
|  |                       |             |         |          |   |                 |

General Note: Staining on top pnl

Scattered map cracking bot 4 pnls

Sparse map cracking bot 3 pnls  
Map cracking top pnl near joints

Scattered vert cracks bot 2 pnls  
Full height map cracking in center 6'

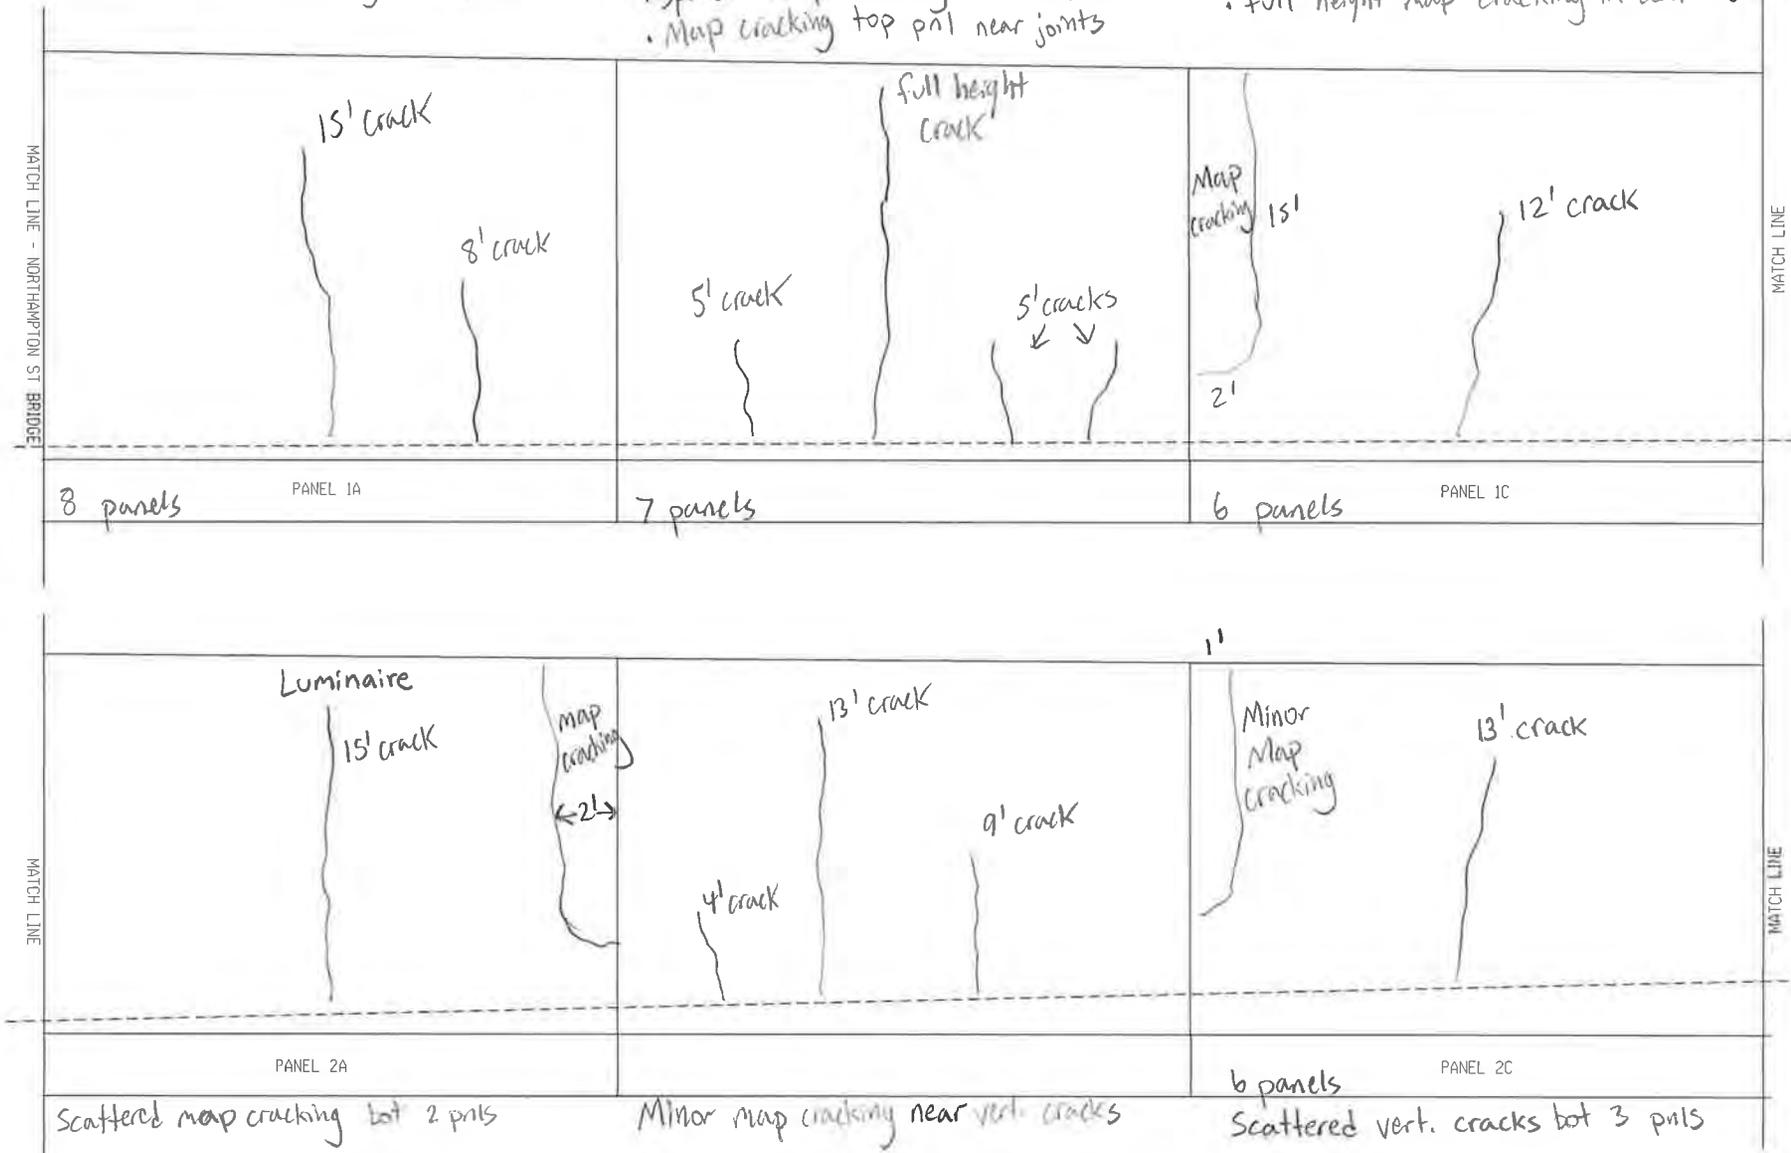


Scattered map cracking bot 2 pnls

Minor map cracking near vert. cracks

Scattered vert. cracks bot 3 pnls

delaminated

### RW 10 PANELS 1A-2C


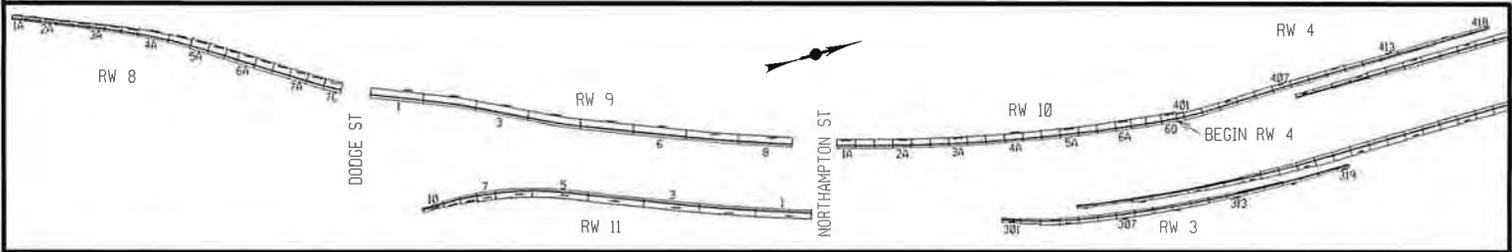


BY: RIM  
DATE: 5/9/23  
SCALE: 1" = 10'

Map cracking bot 2 pnls,  
Scattered pnls 3 & 4

Map cracking bot 4 pnls


Scattered vert. cracks on bot 3 pnls

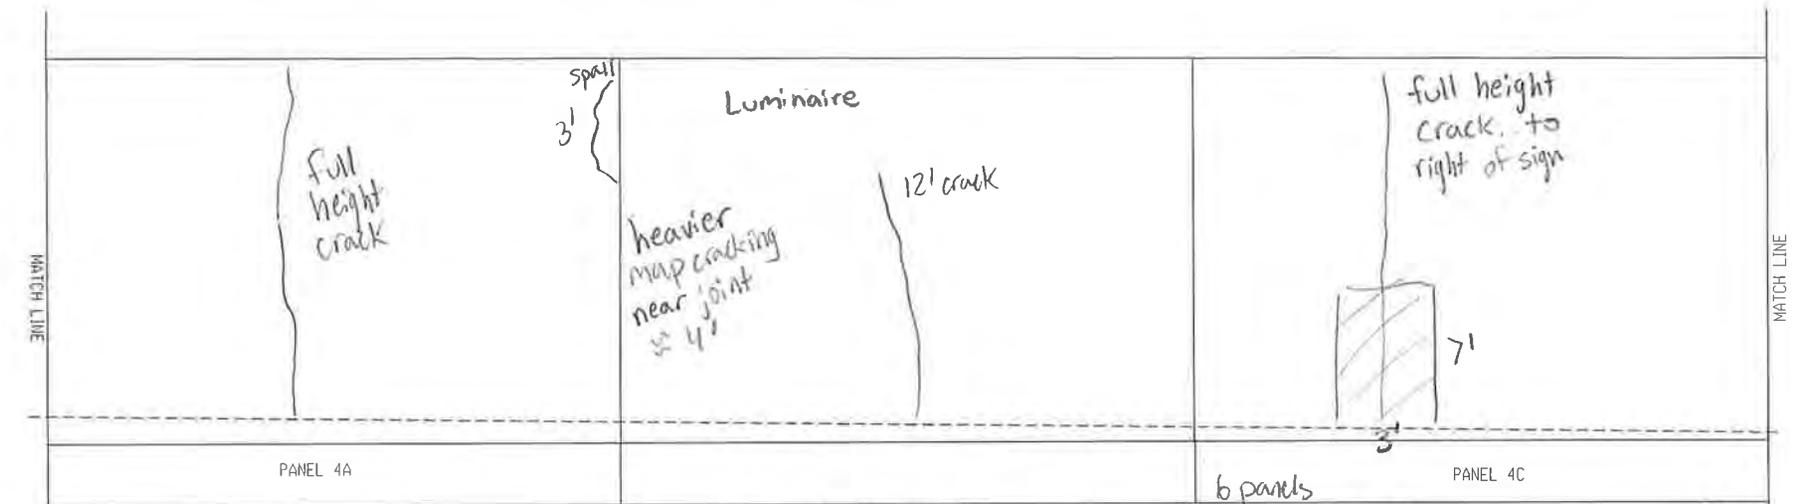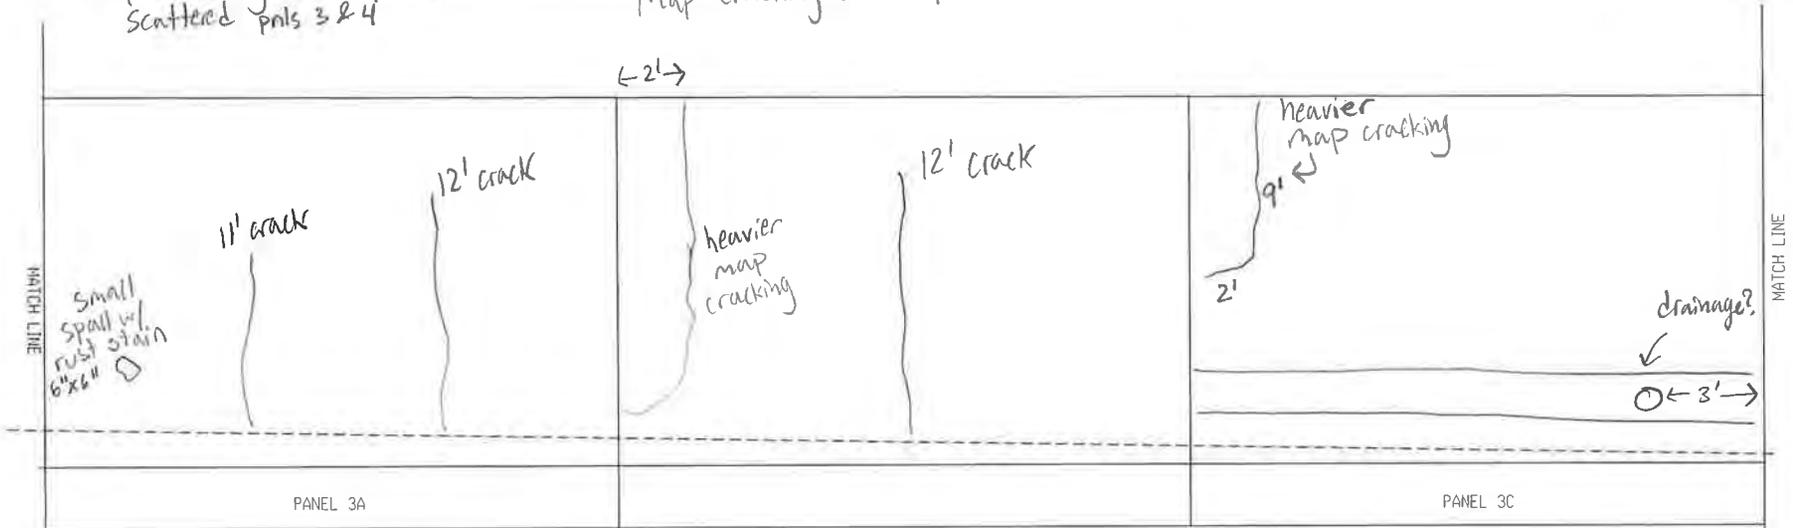

Map cracked throughout  
RW 10 PANELS 3A-4C

Speed Limit Sign



Map cracking throughout

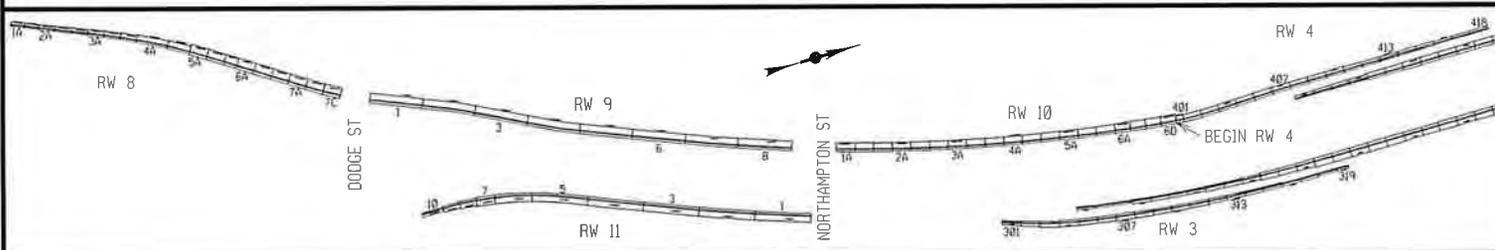

BY: RIM  
DATE: 5/9/23  
SCALE: 1" = 10'

General Note: Staining on top panel

Scattered map cracking throughout

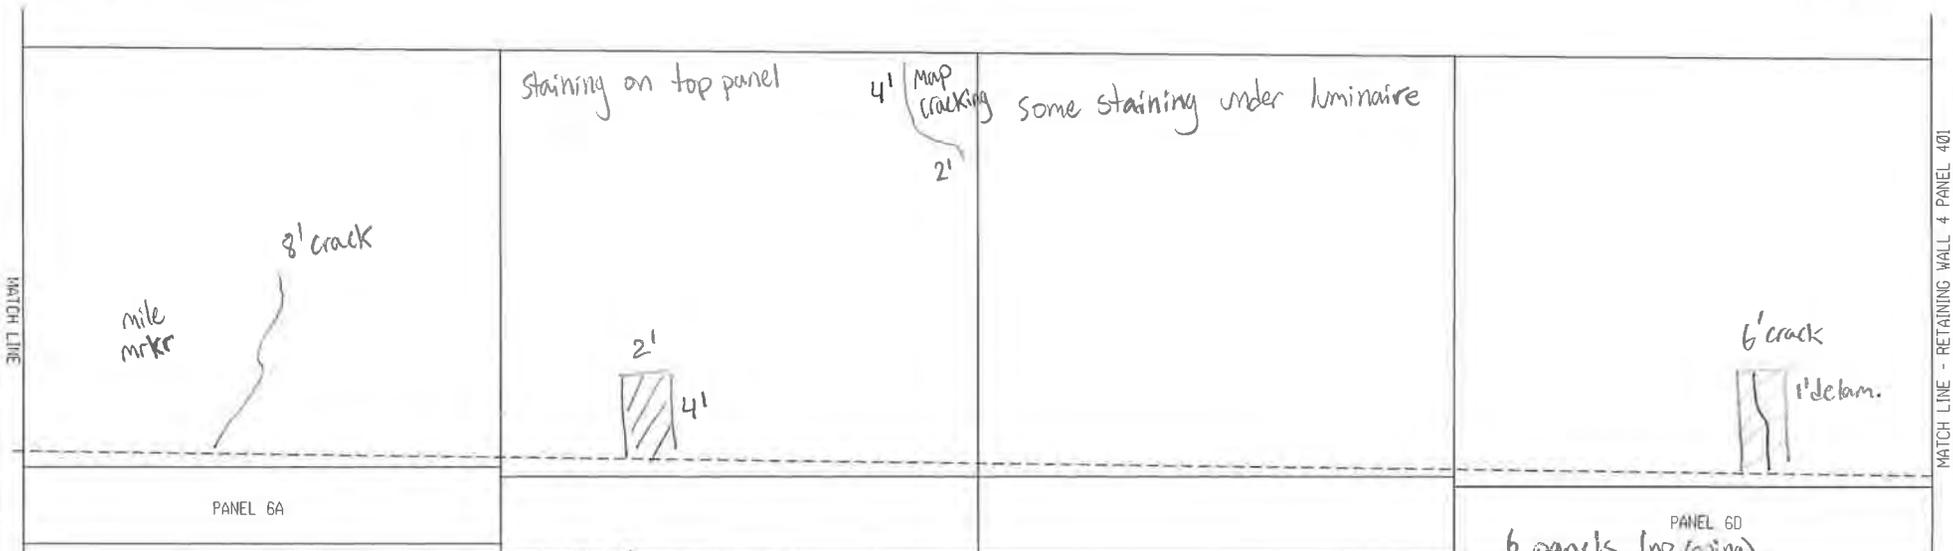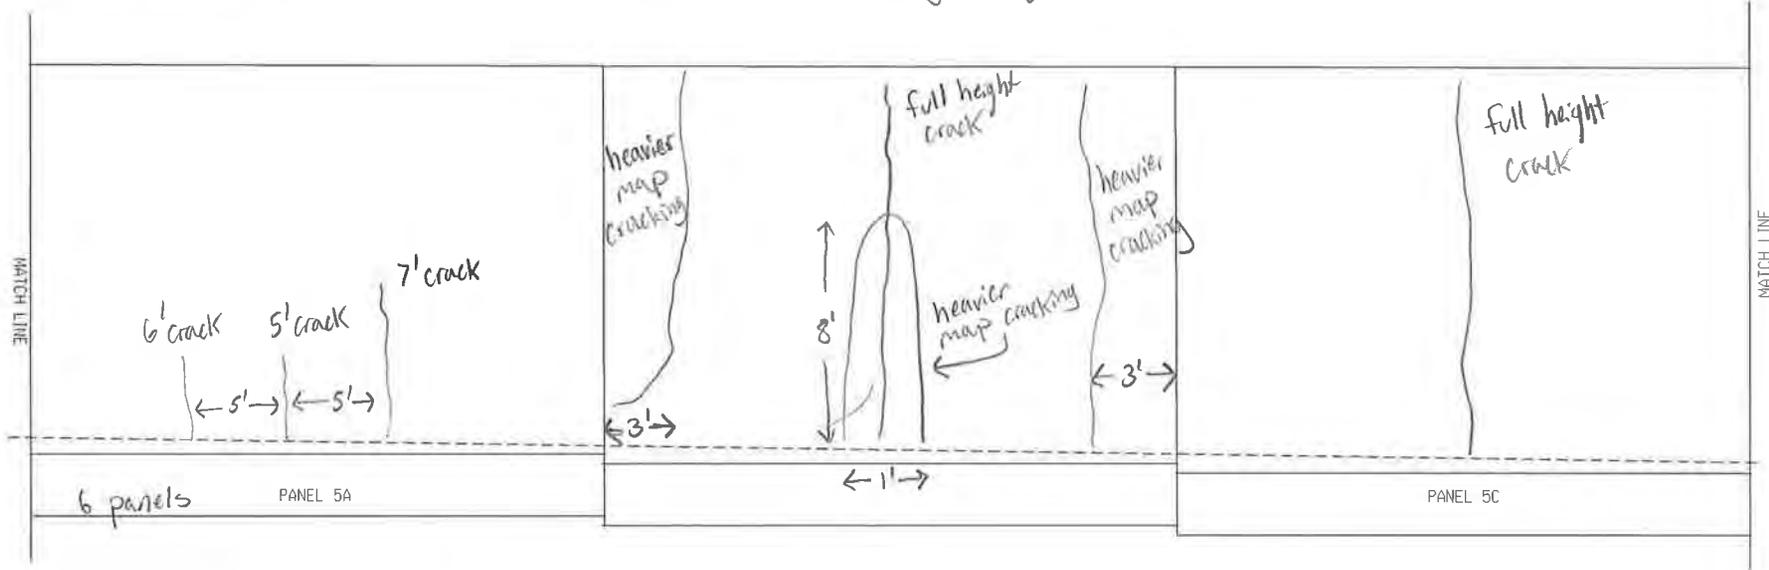


Map cracking top 2 pnts

Scattered map cracking, worst on panel 5 from bottom

6 panels (no coping)  
Scattered rust staining b/w pils 1-3

RW 10 PANELS 5A-6D

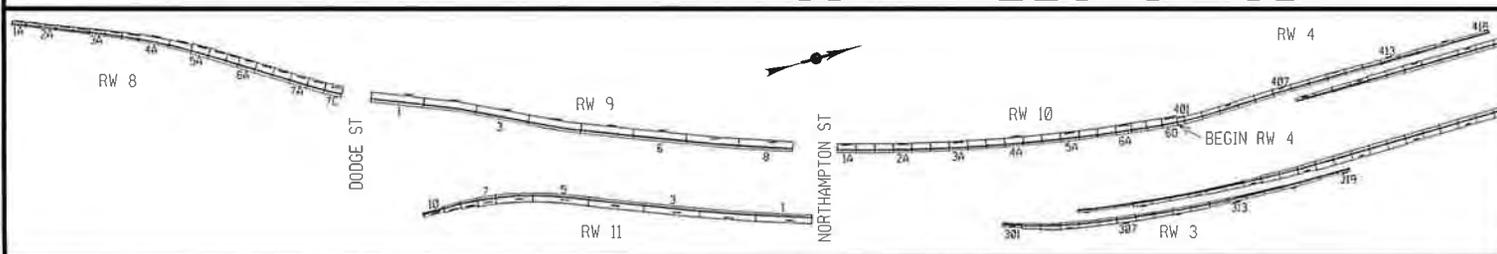

BY: RIM  
DATE: 5/9/23  
SCALE: 1" = 10'

MATCH LINE - RETAINING WALL 4 PANEL 401

## Retaining Wall Coping Inspection 5/30/2023

### Retaining Wall 10

- Concrete balustrade railing from wall 4 to Northampton
- Intermittent vertical cracking of railing

### General WB:

- Granite curb joints are gapped and curb misaligned

PIN 5512.52 Kensington Expressway  
Retaining Wall #10 (RT) along 33WB  
between Northampton St and on ramp from Humboldt Parkway to Rte 33 WB

## Calculations



300 State Street, Suite 201 • Rochester, NY 14614  
 Phone 585.454.6110 • Fax 585.454.3066  
 www.labellapc.com

PROJECT  
 PIN

|                        |              |
|------------------------|--------------|
| Kensington Inspections |              |
| 5512.52                | CALC. BY RIM |
| DATE                   | 5/26/2023    |

Condition Estimates

- Retaining Wall 10
  - Condition 2 - map cracks, stains, isolated delam, minor cracks
  - Condition 3 - spalls, widespread delam, major cracks
  - Areas with multiple forms of deterioration were measured under only one category. Condition 3 categories were prioritized over condition 2.
  - For RW10, about 1/3 of cracks are condition 3

| Panel              | Map Crack (sf) | Cracks (ft)   | Spalls (sf) | Isolated Delam (sf) | Other (staining, efflor., etc.) |               |               |
|--------------------|----------------|---------------|-------------|---------------------|---------------------------------|---------------|---------------|
| 1A                 | 72             | 23            |             |                     | 18                              |               |               |
| 1B                 | 60             | 35            |             |                     | 18                              |               |               |
| 1C                 | 138            | 12            |             |                     | 18                              |               |               |
| 2A                 | 60             | 15            |             |                     | 18                              |               |               |
| 2B                 | 26             | 26            |             |                     | 18                              |               |               |
| 2C                 | 63             | 13            |             |                     | 18                              |               |               |
| 3A                 | 126            | 23            | 0.25        |                     |                                 |               |               |
| 3B                 | 237            | 12            |             |                     |                                 |               |               |
| 3C                 | 72             |               |             |                     |                                 |               |               |
| 4A                 |                | 20            | 3           |                     |                                 |               |               |
| 4B                 | 384            | 12            |             |                     |                                 |               |               |
| 4C                 | 300            | 13            |             | 21                  |                                 |               |               |
| 5A                 |                | 18            |             |                     | 18                              |               |               |
| 5B                 | 196.6          | 18            |             |                     | 18                              |               |               |
| 5C                 |                | 18            |             |                     | 18                              |               |               |
| 6A                 | 90             | 8             |             |                     |                                 |               |               |
| 6B                 | 83             |               |             | 8                   | 30                              |               |               |
| 6C                 |                |               |             |                     | 42                              |               |               |
| 6D                 |                |               | 0           | 6                   | 1                               |               |               |
| <b>Total (sf):</b> | <b>1907.60</b> | <b>133.00</b> | <b>3.25</b> | <b>35.00</b>        | <b>235.00</b>                   | <b>COND 2</b> | <b>COND 3</b> |
|                    |                | (sf)          |             |                     |                                 | 2267          | 48            |

PIN 5512.52 Kensington Expressway  
Retaining Wall #10 (RT) along 33WB  
between Northampton St and on ramp from Humboldt Parkway to Rte 33 WB

# Wall Inventory Sheet

## INVENTORY, INSPECTION, AND DATA COLLECTION

|                                  |  | WALL INSPECTION LOCATION INFORMATION & NOTES |
|----------------------------------|--|--|
| PRIMARY OWNER                    | NYSDOT - New York State Department of Transportation   |  |
| REGION                           | 05-Region 05 - Buffalo   |  |
| COUNTY                           | 3-County 3 - Erie  |  |
| RESIDENCY                        | 534 - Erie North Residency   |  |
| NYS ROUTE                        | Rte. 33  |  |
| REFERENCE MARKER                 | 3353011030   |  |
| LONGITUDE                        | 78.84368   |  |
| LATITUDE                         | 42.90892   |  |
| ADDITIONAL LOCATION DESCRIPTION  | Located along the on-ramp right shoulder from S.B. Humboldt Parkway to W.B. Kensington Expressway (approximately 550 ft. long, 19 ft. maximum exposed height). The west abutment of the Northampton Street Overpass is not considered as part of RW #10. |  |
| TYPE OF SERVICE PROVIDED         | Support/Protect a Roadway  |  |
| WALL TYPE                        | Cantilever - Concrete  |  |
| LEGACY RETAINING WALL TYPE       |  |  |
| WALL FACING TYPE                 | Cast - in -Place Concrete  |  |
| WALL BACKFILL REINFORCEMENT TYPE | N/A  |  |
| ADDITIONAL WALL DESCRIPTION      |  |  |
| WALL LENGTH                      | 550 Ft   |  |
| WALL MAXIMUM HEIGHT              | 19 ft  |  |
| WALL AREA                        | 13130 SF   |  |
| YEAR BUILT                       | 1970   |  |
| CONTRACT NUMBER                  | C 68-2   |  |
| AADT                             | 76,347   |  |
| QC REVIEWER                      |  |  |
| QC APPROVED DATE                 |  |  |
| SITE ACCESS NOTES                | With WZTC in place to close the adjacent shoulder and travel lane, access was performed by walking and extension ladder.   |  |
| INSPECTION FREQUENCY             |  |  |
| LAST INSPECTION STATUS           |  |  |
| INSTRUMENTED                     | N/A  |  |
| MONITORED BY                     | ----   |  |
| INSTRUMENTATION COMMENT          | ----   |  |
| CONSEQUENCE OF FAILURE           | 3-Major  |  |
| WALL POSITION                    | Between Roads  |  |
| GENERAL NOTES                    |  |  |
| RETAINING WALL DATABASE ID       |  |  |
| NUMBER OF ERRORS AND WARNINGS    |  |  |
| USER UPDATE                      |  |  |
| SUBMISSION DATE                  |  |  |
| DATE UPDATE                      |  |  |



**NY33 RETAINING WALL CONDITION EVALUATION 2023**  
**KENSINGTON EXPRESSWAY PROJECT**  
**PIN 5512.52**  
**CITY OF BUFFALO, ERIE COUNTY**  
**RETAINING WALL 11**



Prepared By:

Merton J. Edwards, PE (NYSPE 064981)  
Inspection Team Leader | Sr. Structural Engineer  
Date: 5/30/2023

Reviewed By:

Stephen L. Gauthier, PE (NYSPE 0075775)  
Quality Control Engineer | Sr. Structural Engineer  
Date: 6/16/2023

 **LaBella**  
Powered by partnership.  
300 State Street  
Rochester, New York 14614  
ph: 585-454-6110  
[www.labellapc.com](http://www.labellapc.com)

# PIN 5512.52 – NY33 RETAINING WALL CONDITION EVALUATION 2023 FIELD INSPECTION SUMMARY

STRUCTURE: Retaining Wall #11 (RT) along 33EB between Dodge Street and Northampton Street Bridges

STRUCTURE TYPE: Reinforced Concrete Cantilever Wall on Spread Footings  
Year Built: 1970

CURRENT INSPECTION: 05/01/23 – 5/09/23 (LaBella Inspections)

LAST KNOWN INSPECTION: Unknown

CONDITION STATE: FAIR

## RETAINING WALL INSPECTION & DOCUMENTATION:

Inspection of the retaining walls will be in conformance with the NYSDOT Retaining Wall Inventory and Inspection Program Manual, October 2018. Inspection of the following elements will be inspected and documented as appropriate:

### - Inspection:

The following inspection procedure was followed:

- Walls were checked for signs of settlement, rotation, or bulging. Walls faces were checked for vertical alignment using a smart level. The walls being evaluated are vertical with no batter.
- Construction joints between sections of the wall were examined for misalignment, and near the ground line for fill material washing out from between panels or joint.
- Walls were inspected for erosion material in front of the wall, for heaving of material in front of the wall, and for settlement of fill behind the wall
- Examined the wall for deterioration of the material, such as cracking, spalling, and/or corrosion, noting the width, length, depth, and/or orientation of the deterioration. Photographs are provide documenting defects found.
- Wall façades were reviewed for evidence of water seepage, efflorescence, or rust staining.
- Examined the base of walls for evidence of water flow where the water table may be within the retained earth.
- Examined and probed drains for signs of clogging. Examined drainage around ends of wall and note if embankments have been experiencing erosion.
- Examined site grading for any locations that may prohibit proper drainage from behind the wall looking for evidence of ponding above the wall, such as debris accumulation in the lower spots.
- Ascertain why water is not draining properly and note in the inspection.
- Inspected roadway components above wall for signs or joint separation, potholes, and areas of settlement.
- Examined vegetation growth along and above the wall for root infiltration creating undesirable stresses on the wall. Documented any induce cracking, bulging or failure.
- Examined the wall system for vehicular damage, and document the location and degree of damage.

PIN 5512.52 Kensington Expressway  
 Retaining Wall #11 (RT) along 33EB between Dodge Street and Northampton Street Bridge

GENERAL OBSERVATIONS:

1. Retaining Wall Panels are generally 30 ft in length. The wall cap is 9" with horizontal chamfered panels spaced 3'-0" vertically, from the top of the wall. The wall cap is 9" with horizontal chamfered panels spaced 3'-0" vertically, from the top of the wall. There is some variation in panel length due to the location of bridges within the corridor. For specific panel lengths see the DOCUMENTION Section of this report.
2. The lower 6-10 ft of the subject retaining wall was found to be in FAIR-POOR condition with extensive map cracking, dampness, isolated rust staining, concrete spalls, and widespread delamination. For specific conditions found and photographs of the of wall panels, see the DOCUMENTION Section of this report.
3. The upper portions of theses wall panels were generally found to be in GOOD-FAIR condition except for a few locations. The top of wall rail coping is map cracked under approximately 50% of the railing posts and has horizontal cracking along the coping at mid height for approximately 40% of the wall length. For specific conditions found, photographs of the of wall panels, and condition calculations see the attached sections of this report.

| General:                    |   |
|-----------------------------|---|
| DEFECT                      | DESCRIPTION   |
| Misalignment                | None noted. No tipping or rotation of the wall panels was observed.   |
| Settlement                  | None noted. No heaving was detected at the wall toe, nor was West Drive above the wall showing signs of settlement. |
| Sinkhole (cavity) Formation | None noted.   |

| Concrete Cracks:                                     |  |
|--|--|
| DEFECT   | DESCRIPTION  |
| Insignificant Cracks<br>(cracks < 0.012 inches wide) | Most wall panels exhibit minor cracking. Cracking is predominately vertical and seems to mirror the rebar spacing underneath.  |
| Map cracks   | Most wall panels are exhibiting some map cracking. The map cracking is most prevalent in the bottom 6 feet of the panels and at the top of walls under railing posts.    |
| Moderate Cracks<br>(0.012 - 0.05 inches wide)        | Many wall panels exhibit moderate cracking. These cracks, where they exist, are predominately vertical, full height cracks located at or near the midpoint of the panel. |
| Wide Cracks<br>(cracks > 0.05 inches wide)           | Panels 5-1 exhibits a wide crack. The crack is full height and located at or near the midpoint of the panel.   |

PIN 5512.52 Kensington Expressway  
 Retaining Wall #11 (RT) along 33EB between Dodge Street and Northampton Street Bridge

| Additional Concrete Distress: |   |
|-------------------------------|---|
| DEFECT                        | DESCRIPTION   |
| Spalling / Delamination       | Wall panels 1 through 5 have minor areas of delamination. Delamination amounts vary from approximately 0% to 5% of the exposed wall face.<br><br>Isolated spalling was noted. Spalling is predominately found at the wall joints to adjacent wall panels and in vertical rebar areas in the lower 6 to 10 feet of wall. |
| Staining                      | Staining, both efflorescence and rust staining, is evident on every wall panel. The amount of staining varies and is best noted in the photo documentation.   |
| Exposed Rebar                 | Rebar is exposed in many of the spalled areas noted during the inspection. Most of the exposed rebar is vertically placed reinforcement. Exposed rebar was noted to have between 15% and 60% section loss.  |

| Notes:   |
|--|
| <p>RW 11 consists of 10 panels with 21 sections numbered east (north) to west (south). The retaining wall supports the West Drive above State Route 33 (Kensington Expressway).</p> <p>Located along the E.B. mainline right shoulder between Dodge and Northampton Streets supporting West Drive adjacent to the Buffalo Museum of Science (approximately 630 ft. long, 20 ft. maximum exposed height). The east abutment of the Northampton Street Overpass is not considered as part of RW #11.</p> <p>The wall exhibits a medium to high extent of low-severity distress and a low extent of medium-severity distress.</p> |

**INVENTORY, INSPECTION, AND DATA COLLECTION**

| Element                       | Total Qty | Units | Condition State |      |      |        |
|-------------------------------|-----------|-------|-----------------|------|------|--------|
|                               |           |       | 1               | 2    | 3    | 4      |
|                               |           |       | GOOD            | FAIR | POOR | SEVERE |
| RW.01 - Entire Wall           | 1         | Each  | 0.96            | 0.03 | 0.01 |        |
| RW.02 - Wall Facing           | 11410     | SF    | 10980           | 326  | 104  |        |
| RW.03 - Ground Surface, Front | 630       | FT    | 630             |      |      |        |
| RW.04 - Ground Surface, Back  | 630       | FT    | 630             |      |      |        |
| RW.05 - Weep Holes            | N/A       | Each  | ---             | ---  | ---  | ---    |
| 800 - Scour                   | N/A       | Ft    | ---             | ---  | ---  | ---    |

PIN 5512.52 Kensington Expressway  
Retaining Wall #11 (RT) along 33EB between Dodge Street and Northampton Street Bridge

#### INSPECTION RESULTS/ RECOMMENDATIONS

- **Overall Condition State Recommendation: 2 - FAIR**
- PROJECT DOCUMENTATION CAN BE FOUND IN THE ATTACHED SECTIONS

PIN 5512.52 Kensington Expressway  
Retaining Wall #11 (RT) along 33EB between Dodge Street and Northampton Street Bridge

## Inspection Photos

# PIN 5512.52 – NY33 RETAINING WALL CONDITION EVALUATION 2023 FIELD INSPECTION SUMMARY

Retaining Wall #11 (RT) along 33EB between Dodge Street and Northampton Street Bridges



PHOTO 1  
PANEL 7  
Description:  
There is map cracking on the top 7' of panel 7 near the left joint.  
Panels 4.1 and 3.1 have similar cracking near the right joint.



PHOTO 2  
PANEL 5.3  
Description:  
There is a 3"x8" spall on the edge of panel 5.3 at the left joint.

# PIN 5512.52 – NY33 RETAINING WALL CONDITION EVALUATION 2023 FIELD INSPECTION SUMMARY

Retaining Wall #11 (RT) along 33EB between Dodge Street and Northampton Street Bridges



PHOTO 3  
PANEL 4.3  
Description:  
There is a 15' vertical crack at 11' from the left joint.  
Most panels have a 6' to full-height crack at 10' to 15' from the edge of the panel.



PHOTO 4  
PANEL 4.2  
Description:  
There is a 1'x3' spall on the bottom right edge of the panel. Some rust staining is present.

# PIN 5512.52 – NY33 RETAINING WALL CONDITION EVALUATION 2023 FIELD INSPECTION SUMMARY

Retaining Wall #11 (RT) along 33EB between Dodge Street and Northampton Street Bridges



PHOTO 5  
PANEL 4.2  
Description:  
There is a 60-degree crack with delamination as outlined.  
Rust staining is present.



PHOTO 6  
PANEL 4.1  
Description:  
Vertical cracking mirrors the placement of rebar. Rust staining and efflorescence is present. Cracking continues for entire panel.

# PIN 5512.52 – NY33 RETAINING WALL CONDITION EVALUATION 2023 FIELD INSPECTION SUMMARY

Retaining Wall #11 (RT) along 33EB between Dodge Street and Northampton Street Bridges



PHOTO 7  
PANEL 3.2  
Description:  
There is a 19"x40" spall with exposed rebar on the bottom left edge of the panel.  
There is a similar spall without exposed rebar on the right edge of the panel.



PHOTO 8  
PANEL 2.3  
Description:  
There is a 10.5' vertical crack at midspan of the panel. Delamination is present for 1' on either side of the crack.  
Vertical cracking and map cracking is also present similar to panel 4.1.

# PIN 5512.52 – NY33 RETAINING WALL CONDITION EVALUATION 2023 FIELD INSPECTION SUMMARY

Retaining Wall #11 (RT) along 33EB between Dodge Street and Northampton Street Bridges



PHOTO 9  
PANEL 2.2  
Description:  
There is a 3' high x 10" wide area of delamination along the right side of the panel. Map cracking is present in the surrounding area.  
Rust staining is present in the chamfer.

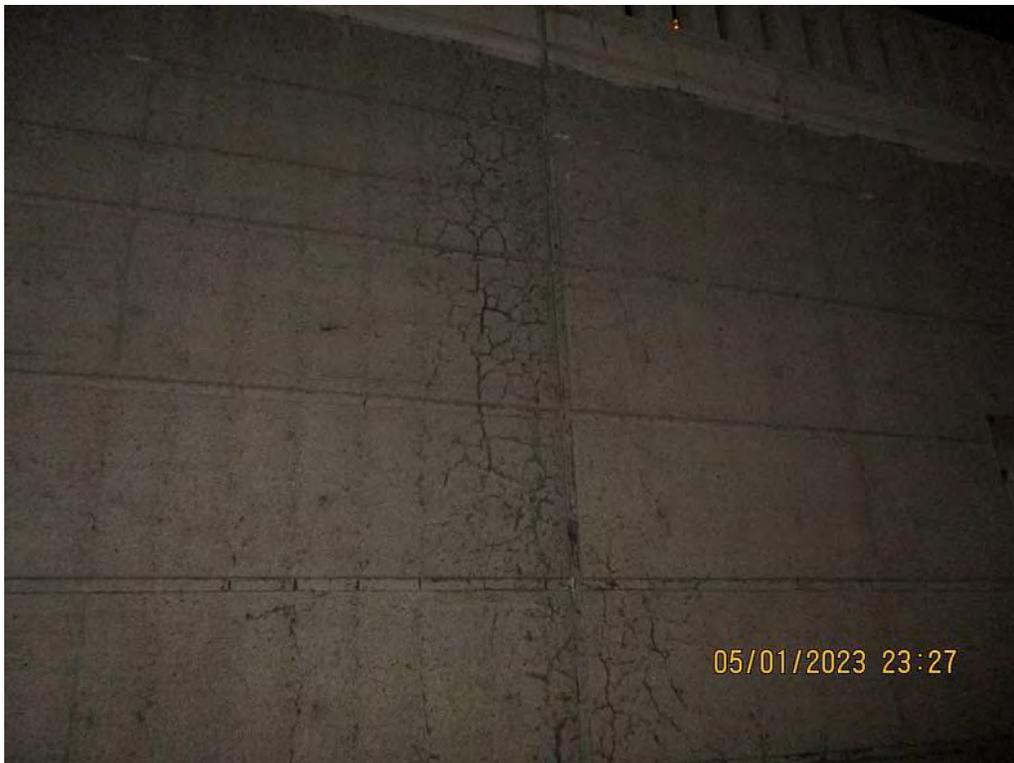


PHOTO 10  
PANEL 2.1 & 2.2  
Description:  
Map cracking is present on either side of the joint.

# PIN 5512.52 – NY33 RETAINING WALL CONDITION EVALUATION 2023 FIELD INSPECTION SUMMARY

Retaining Wall #11 (RT) along 33EB between Dodge Street and Northampton Street Bridges



PHOTO 11  
PANEL 1.2  
Description:  
There is an 11' crack at midspan of the panel. There is an 18" high area of delamination as outlined.  
Vertical rebar is showing in the wall chamfer for 10' from the left joint.

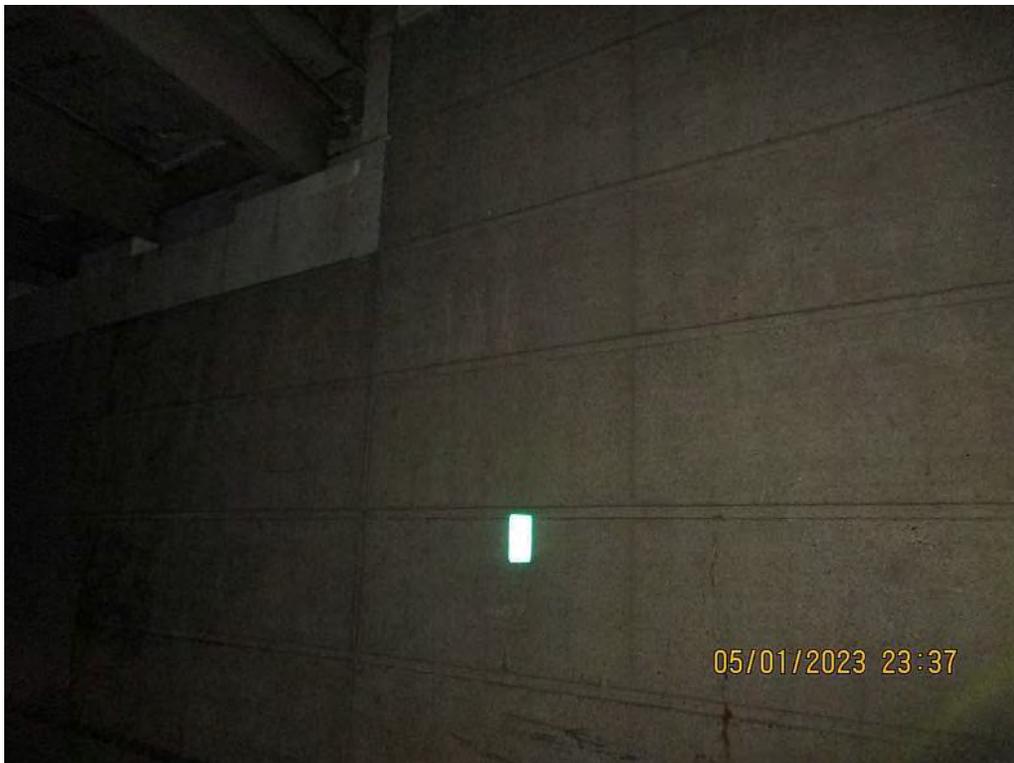



PHOTO 12  
PANEL 1.1  
Description:  
Begin RW11. Right of Northampton St bridge east abutment.  
There are 6' and 10' vertical cracks near midspan of the panel.  
The panel is in good condition near the abutment.

PIN 5512.52 Kensington Expressway  
Retaining Wall #11 (RT) along 33EB between Dodge Street and Northampton Street Bridge

## Field Sheets


FILE NAME = \\06cashlab\06\02150716.01 kensington Preliminary Design\Drawings\Highway\Plan\set2\0551252\_cph\_pin\_1ftA.dgn  
 DATE = 2/7/2023  
 TIME = 12:56:26 PM

PROJECT MANAGER  
 CHECK  
 DRAFTING  
 CHECK  
 DESIGN  
 JOB MANAGER  
 DESIGN SUPERVISOR

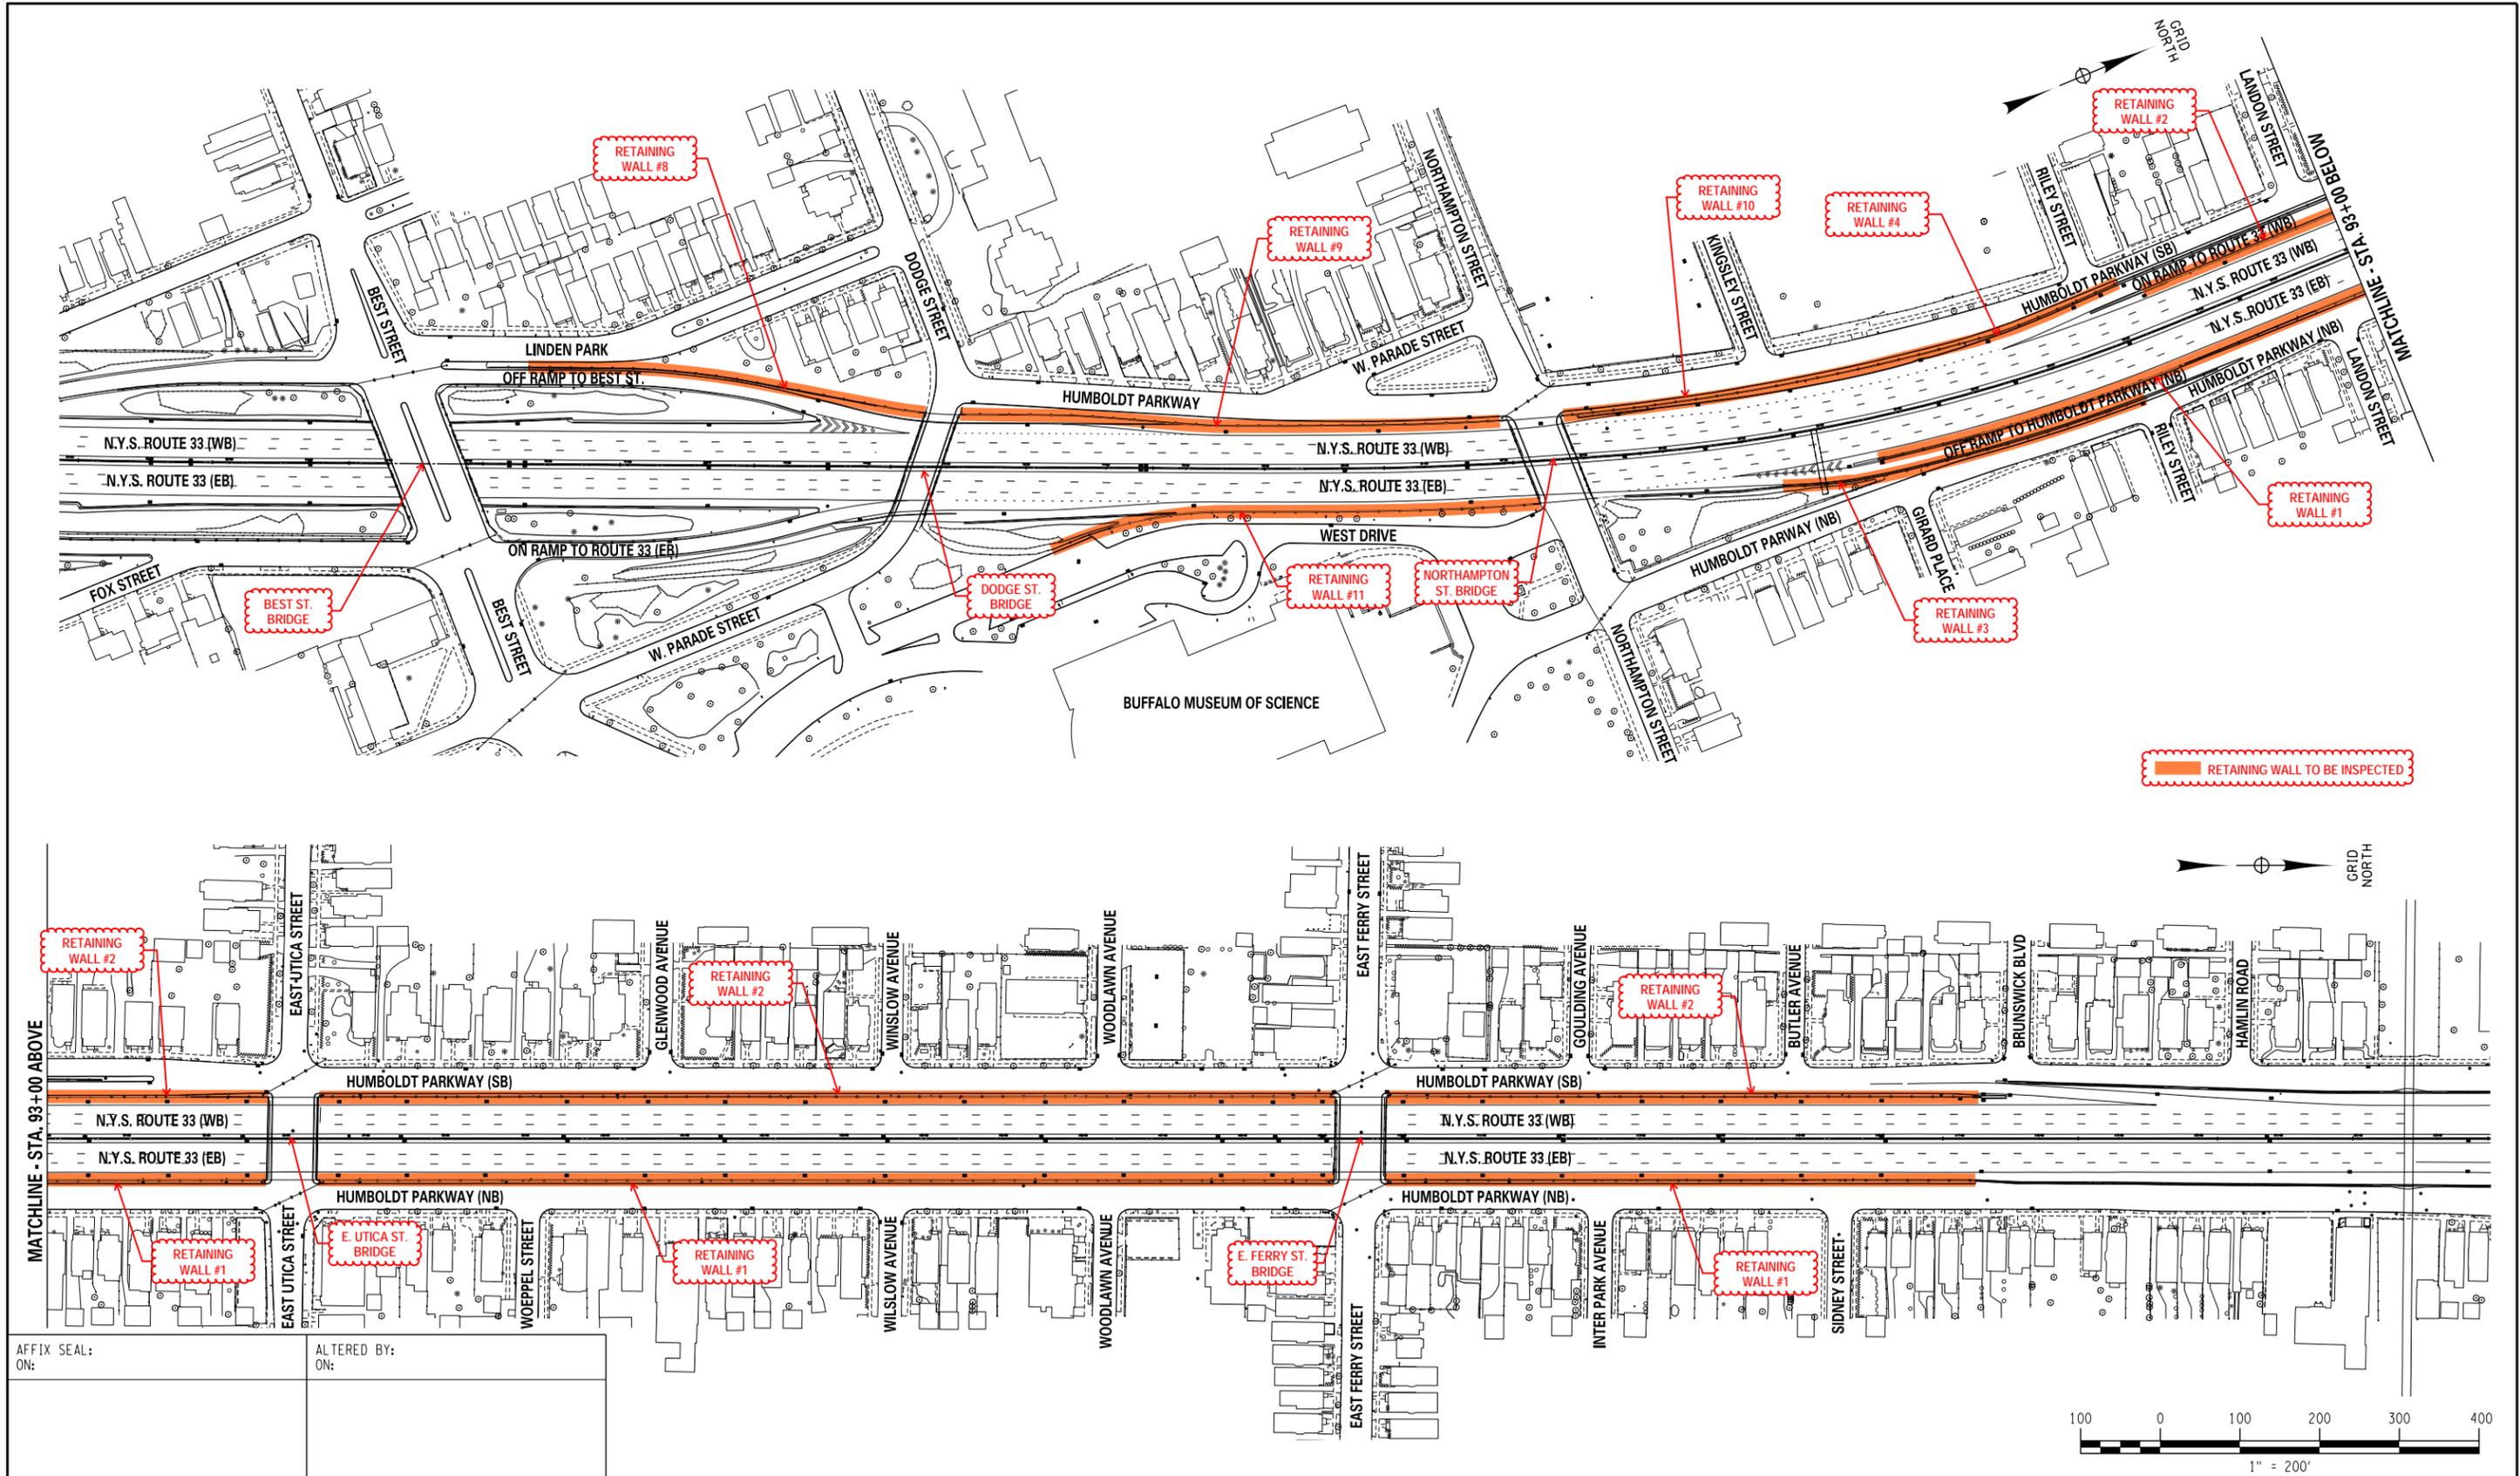

|                    |                    |
|--------------------|--------------------|
| AFFIX SEAL:<br>ON: | ALTERED BY:<br>ON: |
|--------------------|--------------------|

|  |                       |             |         |          |   |   |  |
|--|-----------------------|-------------|---------|----------|---|---|--|
| AS-BUILT REVISIONS<br>DESCRIPTION OF ALTERATIONS:  | STATE ROUTE 33        | PIN 5512.52 | BRIDGES | CULVERTS | ALL DIMENSIONS IN FT UNLESS OTHERWISE NOTED                   | CONTRACT NUMBER                           |  |
|  | KENSINGTON EXPRESSWAY |             |         |          |   |   |  |
|  | CITY OF BUFFALO       | REGION: 5   |         |          | <b>KENSINGTON EXPRESSWAY<br/>RETAINING WALL LOCATION PLAN</b> | DRAWING NO. 1<br>SHEET NO.                |  |
| IT IS A VIOLATION OF LAW FOR ANY PERSON, UNLESS THEY ARE ACTING UNDER THE DIRECTION OF A LICENSED PROFESSIONAL ENGINEER, ARCHITECT, LANDSCAPE ARCHITECT, OR LAND SURVEYOR, TO ALTER AN ITEM IN ANY WAY. IF AN ITEM BEARING THE STAMP OF A LICENSED PROFESSIONAL IS ALTERED, THE ALTERING ENGINEER, ARCHITECT, LANDSCAPE ARCHITECT, OR LAND SURVEYOR SHALL STAMP THE DOCUMENT AND INCLUDE THE NOTATION "ALTERED BY" FOLLOWED BY THEIR SIGNATURE, THE DATE OF SUCH ALTERATION, AND A SPECIFIC DESCRIPTION OF THE ALTERATION. |                       |             |         |          |   | <b>LaBella</b><br>Powered by partnership. | <b>NEW YORK</b><br>STATE OF OPPORTUNITY. <b>Department of Transportation</b> |

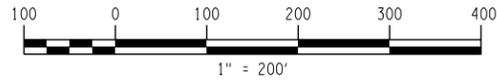


 delaminated

vert. rebar is showing in wall chamfer for 10' from left

MATCH LINE - NORTHAMPTON ST BRIDGE


3/4" gap at joint

MATCH LINE

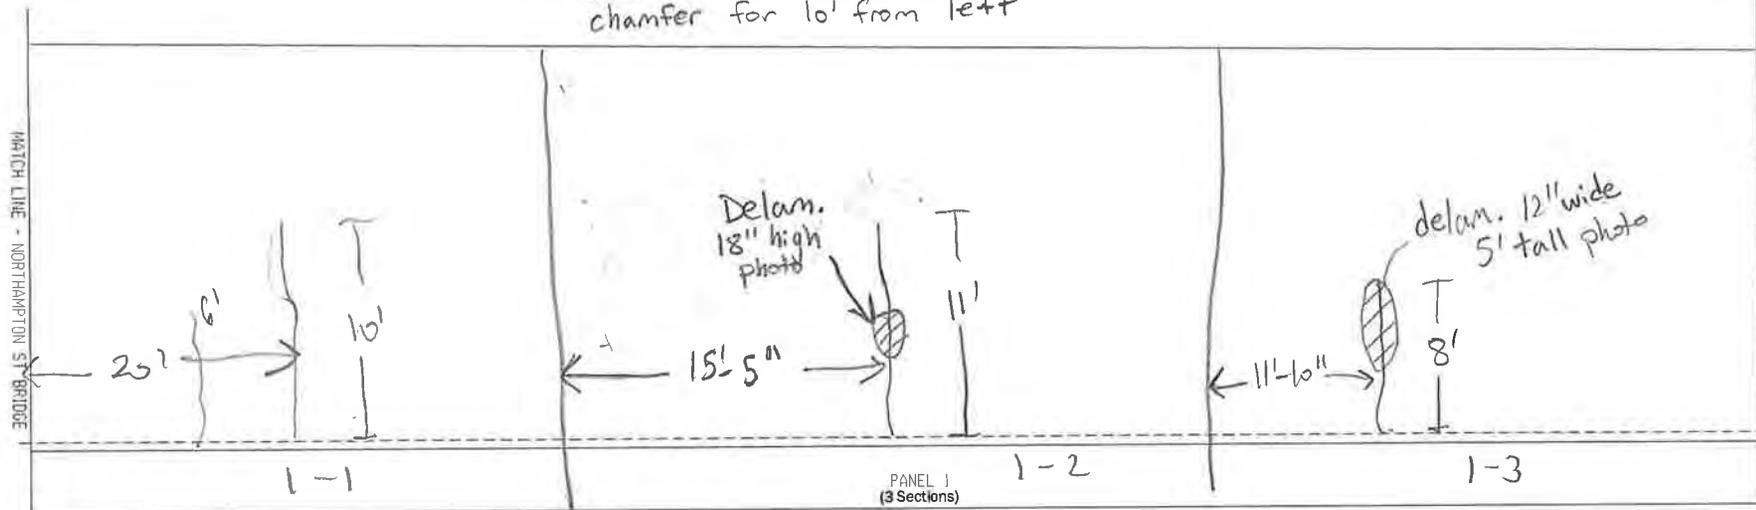


PANEL 1 (3 Sections)

1-2-1

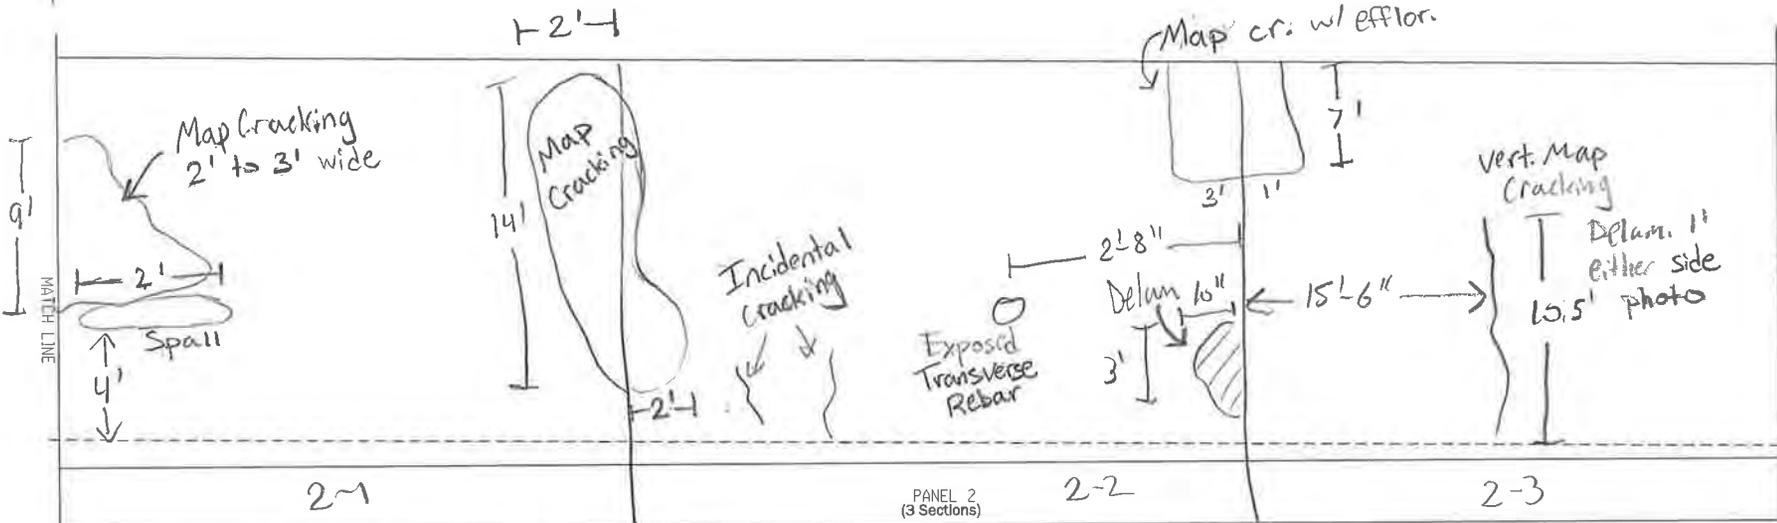


PANEL 2 (3 Sections)


RW 11 PANELS 1-2

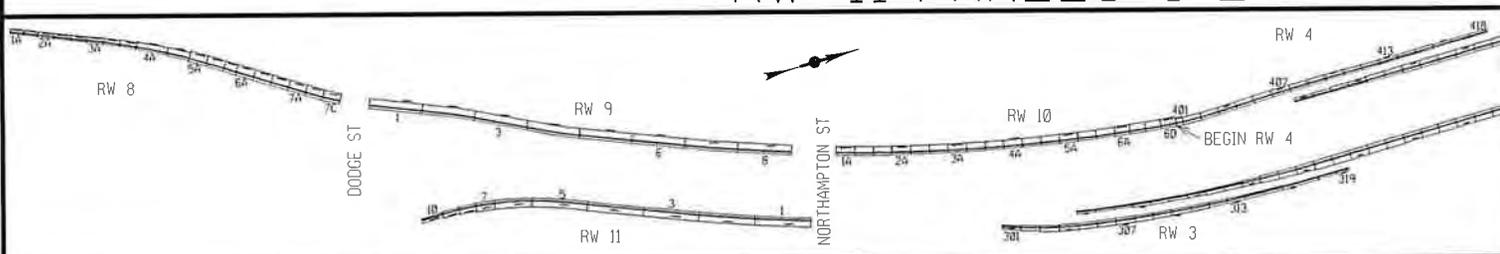

BY: RIM  
 DATE: 5/1/23  
 SCALE: 1" = 10'

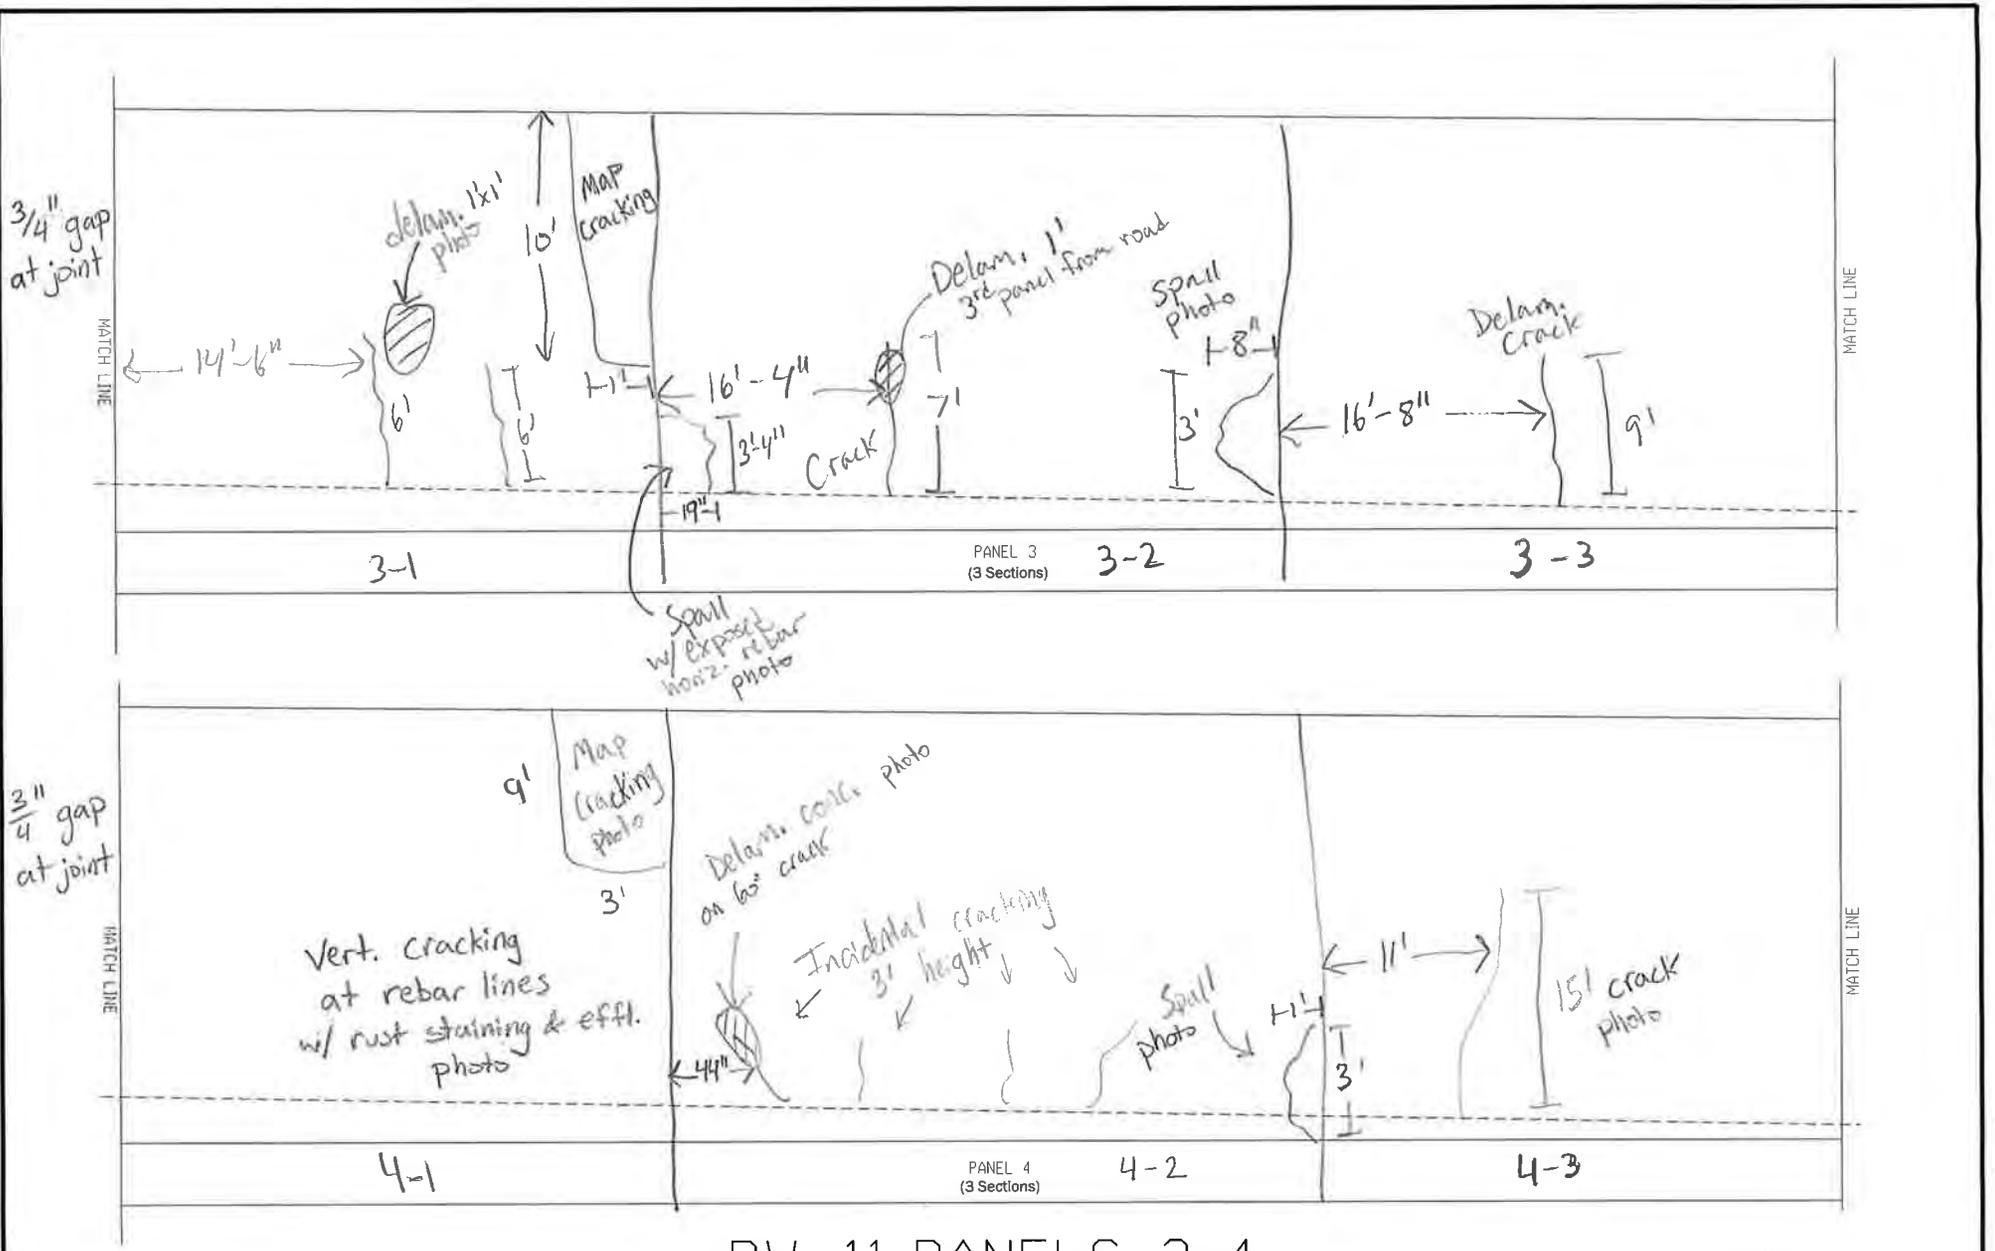

RW 11 PANELS 3-4

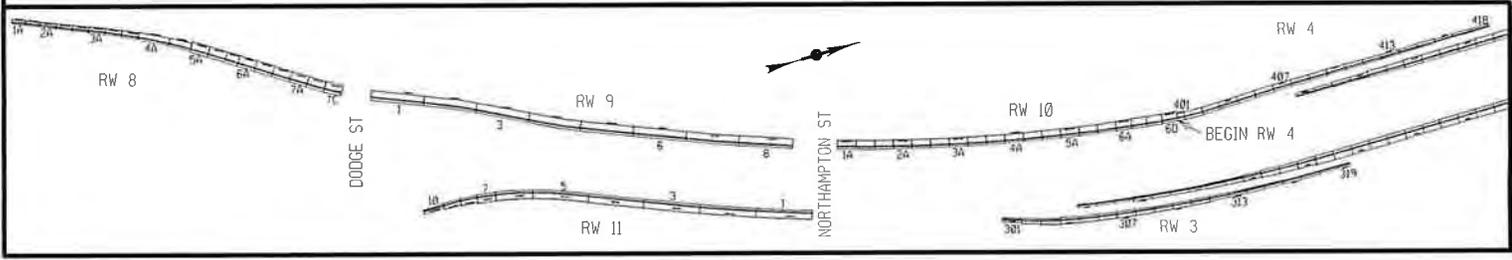


BY: RIM

DATE: 5/1/23

SCALE: 1" = 10'




$\frac{3}{4}$ " Gap at joint

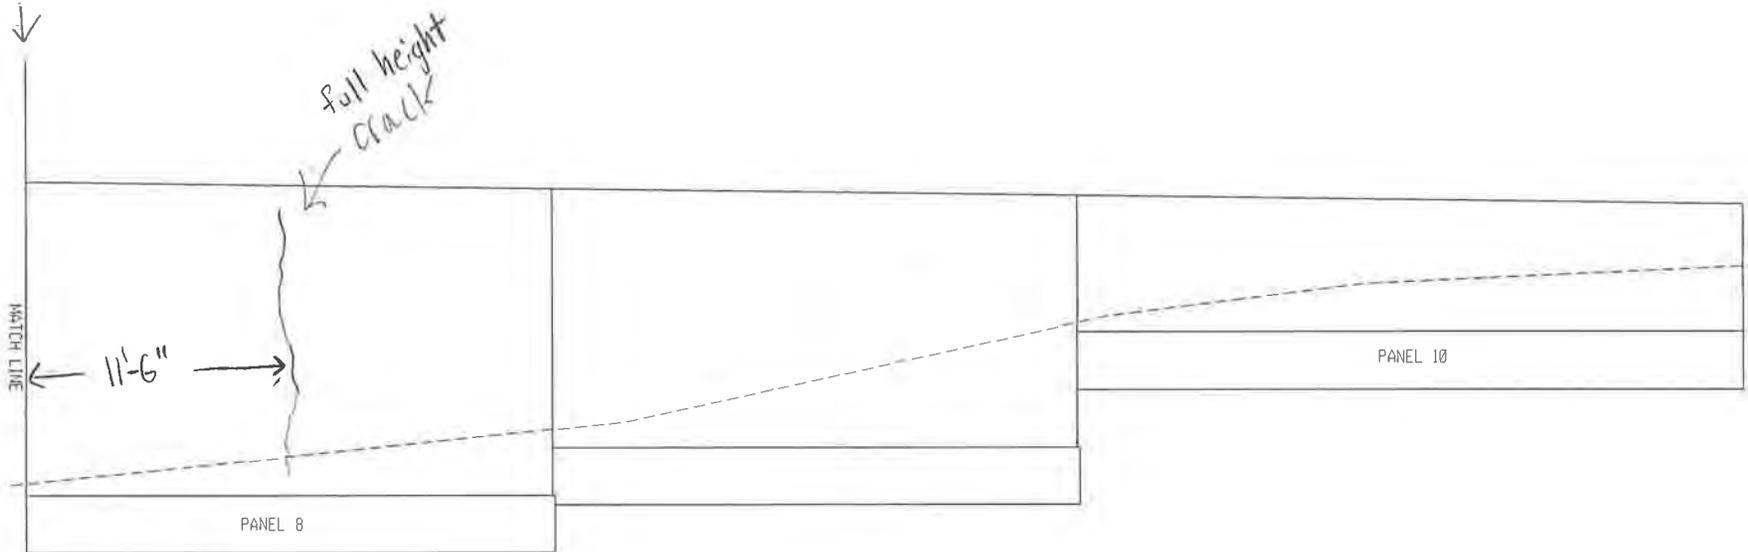

- Map cracking throughout
- Error on top panel



### RW 11 PANELS 8-10

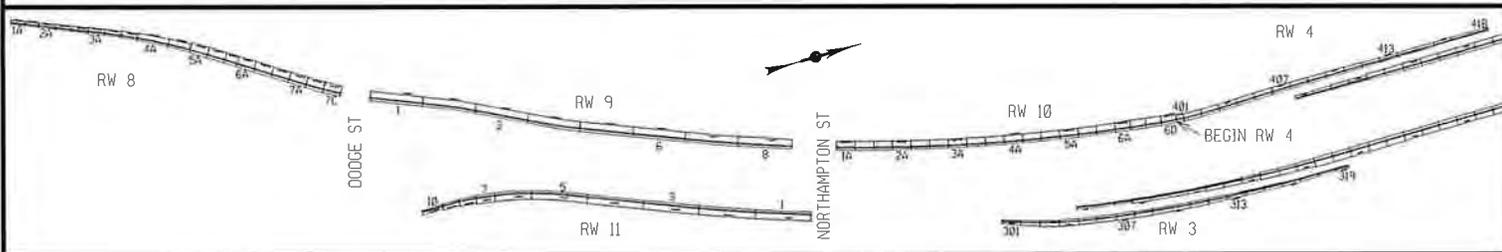

BY: RIM  
 DATE: 5/1/23  
 SCALE: 1" = 10'

Retaining Wall Coping Inspection 5/30/2023

Retaining Wall 11

- Balustrade railing has minor stress cracking

PIN 5512.52 Kensington Expressway  
Retaining Wall #11 (RT) along 33EB between Dodge Street and Northampton Street Bridge

## Calculations



300 State Street, Suite 201 • Rochester, NY 14614  
 Phone 585.454.6110 • Fax 585.454.3066  
 www.labellapc.com

PROJECT  
 PIN

|                        |          |     |           |
|------------------------|----------|-----|-----------|
| Kensington Inspections |          |     |           |
| 5512.52                | CALC. BY | CAM | DATE      |
|                        |          |     | 5/26/2023 |

Condition Estimates

- Retaining Wall 11
  - Condition 2 - map cracks, stains, isolated delam, minor cracks
  - Condition 3 - spalls, widespread delam, major cracks
  - Areas with multiple forms of deterioration were measured under only one category. Condition 3 categories were prioritized over condition 2.

| Panel              | Minor/Map Crack (sf) | Major Cracks (ft) | Spalls (sf) | Widespread Delam (sf) | Isolated Delam (sf) | Other (staining, efflor., etc.) |                      |                      |
|--------------------|----------------------|-------------------|-------------|-----------------------|---------------------|---------------------------------|----------------------|----------------------|
| 1.1                |                      | 16                |             |                       |                     |                                 |                      |                      |
| 1.2                |                      | 11                |             |                       | 3                   |                                 |                      | 5                    |
| 1.3                |                      | 8                 |             |                       | 6                   |                                 |                      |                      |
| 2.1                | 55                   |                   | 2           |                       |                     |                                 |                      |                      |
| 2.2                | 41                   |                   | 1           |                       | 3                   |                                 |                      |                      |
| 2.3                | 7                    |                   |             |                       | 24                  |                                 |                      |                      |
| 3.1                | 10                   | 12                | 1           |                       | 3                   |                                 |                      |                      |
| 3.2                | 7                    |                   | 11          |                       | 3                   |                                 |                      |                      |
| 3.3                |                      | 9                 |             |                       | 18                  |                                 |                      |                      |
| 4.1                | 94.5                 |                   |             |                       |                     |                                 |                      |                      |
| 4.2                | 21                   |                   | 3           |                       | 3                   |                                 |                      |                      |
| 4.3                |                      | 15                |             |                       |                     |                                 |                      |                      |
| 5.1                |                      | 22.5              |             |                       |                     |                                 |                      |                      |
| 5.2                |                      | 14                |             |                       | 6                   |                                 |                      |                      |
| 5.3                |                      | 8                 | 1           |                       | 1                   |                                 |                      |                      |
| 6.1                |                      | 11                |             |                       |                     |                                 |                      |                      |
| 6.2                |                      | 11                |             |                       |                     |                                 |                      |                      |
| 7                  | 6                    | 15                |             |                       |                     |                                 |                      |                      |
| 8                  | 9                    | 17                |             |                       |                     |                                 |                      |                      |
| 9                  |                      |                   |             |                       |                     |                                 |                      |                      |
| 10                 |                      |                   |             |                       |                     |                                 |                      |                      |
| <b>Total (sf):</b> | 250.50               | 84.75<br>(sf)     | 19.00       | 0.00                  | 70.00               | 5.00                            | <b>COND 2</b><br>326 | <b>COND 3</b><br>104 |

PIN 5512.52 Kensington Expressway  
Retaining Wall #11 (RT) along 33EB between Dodge Street and Northampton Street Bridge

# Wall Inventory Sheet

## INVENTORY, INSPECTION, AND DATA COLLECTION

| INVENTORY, INSPECTION, AND DATA COLLECTION |   | WALL INSPECTION LOCATION INFORMATION & NOTES |
|--|---|--|
| <b>PRIMARY OWNER</b>                       | NYS DOT - New York State Department of Transportation   |  |
| <b>REGION</b>                              | 05-Region 05 - Buffalo  |  |
| <b>COUNTY</b>                              | 3-County 3 - Erie   |  |
| <b>RESIDENCY</b>                           | 534 - Erie North Residency  |  |
| <b>NYS ROUTE</b>                           | Rte. 33   |  |
| <b>REFERENCE MARKER</b>                    | 3353011032  |  |
| <b>LONGITUDE</b>                           | 78.84444  |  |
| <b>LATITUDE</b>                            | 42.90565  |  |
| <b>ADDITIONAL LOCATION DESCRIPTION</b>     | Located along the E.B. mainline right shoulder between Dodge and Northampton Streets and supports West Drive adjacent to the Buffalo Museum of Science (approximately 630 ft. long, 20 ft. maximum exposed height). The east abutment of the Northampton Street Overpass is not considered as part of RW#11 |  |
| <b>TYPE OF SERVICE PROVIDED</b>            | Support/Protect a Roadway   |  |
| <b>WALL TYPE</b>                           | Cantilever - Concrete   |  |
| <b>LEGACY RETAINING WALL TYPE</b>          |   |  |
| <b>WALL FACING TYPE</b>                    | Cast - in -Place Concrete   |  |
| <b>WALL BACKFILL REINFORCEMENT TYPE</b>    | N/A   |  |
| <b>ADDITIONAL WALL DESCRIPTION</b>         |   |  |
| <b>WALL LENGTH</b>                         | 630 Ft  |  |
| <b>WALL MAXIMUM HEIGHT</b>                 | 20 Ft   |  |
| <b>WALL AREA</b>                           | 14700 SF  |  |
| <b>YEAR BUILT</b>                          | 1960  |  |
| <b>CONTRACT NUMBER</b>                     | FAC 59-19   |  |
| <b>AADT</b>                                | 82,171  |  |
| <b>QC REVIEWER</b>                         |   |  |
| <b>QC APPROVED DATE</b>                    |   |  |
| <b>SITE ACCESS NOTES</b>                   | With WZTC in place to close the adjacent shoulder and travel lane, access was performed by walking and extension ladder.  |  |
| <b>INSPECTION FREQUENCY</b>                |   |  |
| <b>LAST INSPECTION STATUS</b>              | N/A   |  |
| <b>INSTRUMENTED</b>                        | N/A   |  |
| <b>MONITORED BY</b>                        | ----  |  |
| <b>INSTRUMENTATION COMMENT</b>             | ----  |  |
| <b>CONSEQUENCE OF FAILURE</b>              | 3-Major   |  |
| <b>WALL POSITION</b>                       | Between Roads   |  |
| <b>GENERAL NOTES</b>                       |   |  |
| <b>RETAINING WALL DATABASE ID</b>          |   |  |
| <b>NUMBER OF ERRORS AND WARNINGS</b>       |   |  |
| <b>USER UPDATE</b>                         |   |  |
| <b>SUBMISSION DATE</b>                     |   |  |
| <b>DATE UPDATE</b>                         |   |  |